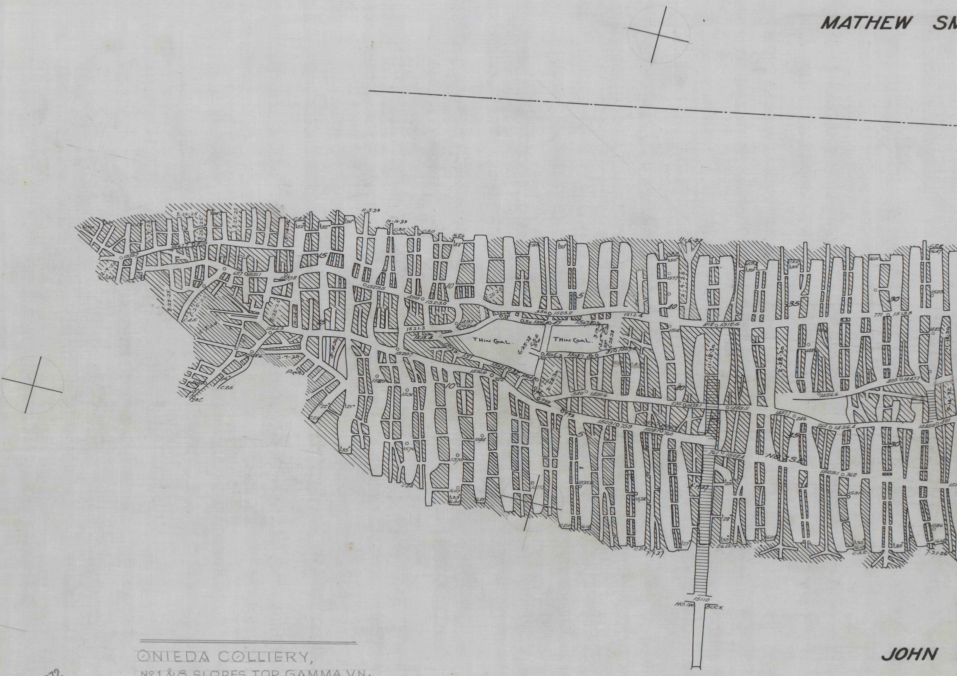
MATHEW SM
THIN COAL.
THIN COAL.
NO. 3 S.L.
1511.0
NO. 1 W BUCK
JOHN

ONIEDA COLLIERY,
Nº 1 & 8 SLOPES, TOP GAMMA VN.
1" = 100'

MAR 10 1972
MF

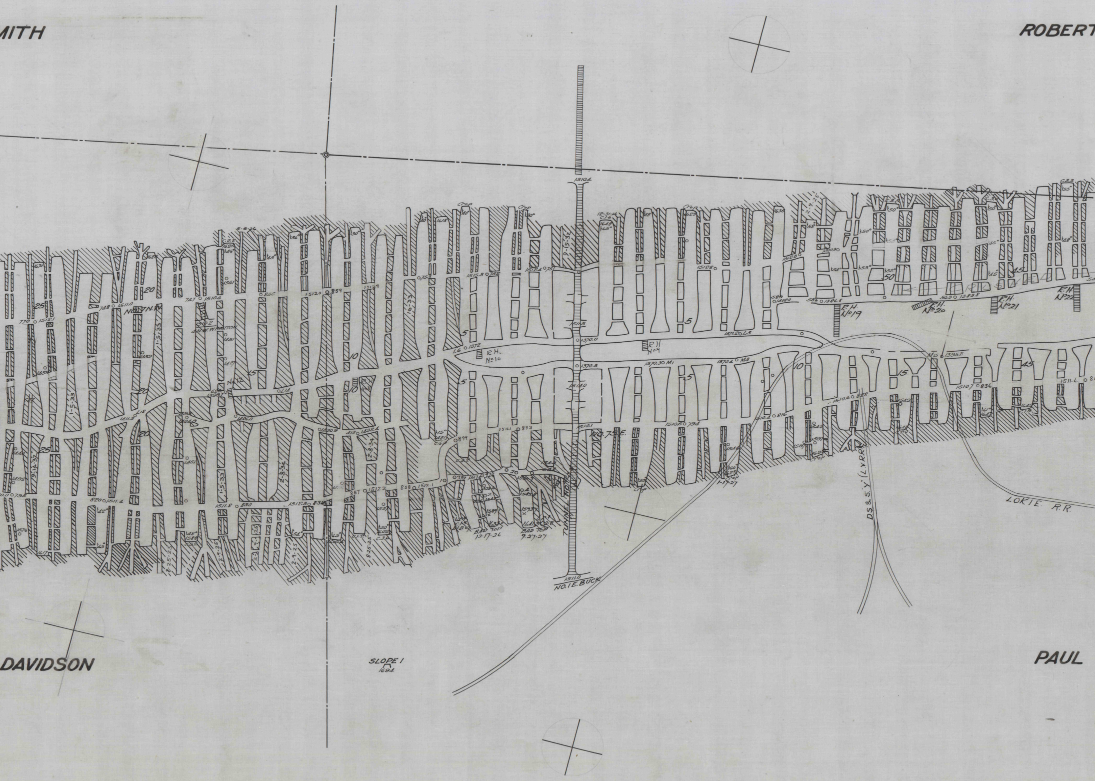

MITH
ROBERT
DAVIDSON
PAUL
SLOPE 1
1694
No 17 N.W.
4 N.W. WHARTON
1510.2
No 12
R.H. No 10
R.H. No 9
R.H. No 19
R.H. No 20
R.H. No 21
R.H. No 22
L6 1372
1370.0
1370.3
1370.30 M1
1370.4 M3
1371.2 L3
M15 1395.2
1511.5
1514.0
1510.1
1510.4
NO. 7 S.E.
TUNNEL No 1
1511.0
NO. 1 E. BUCK
BAD TOP 12-17-26
BAD TOP 9-27-27
1-17-27
9-15-32
1-5-33
2-8-34
19-14-32
8-25-25
2-9-25
5-8-26
12-31-24
DS & S 'Y' (L.V.R.R.)
LORIE R.R.
Crop
5
10
15
20
25
45
50

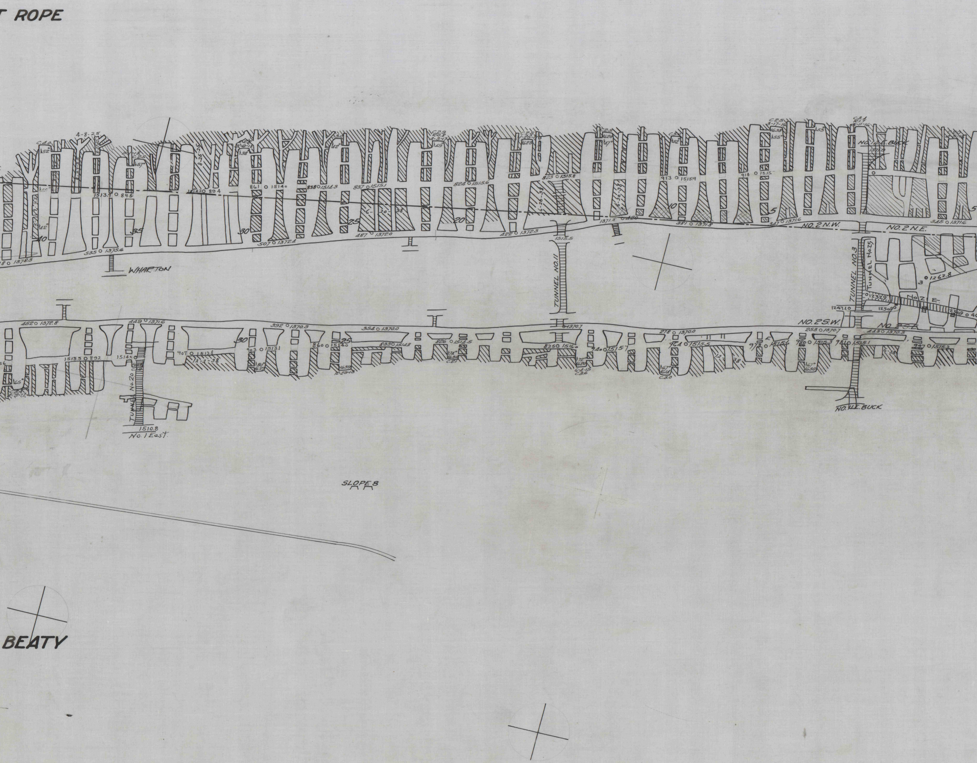

T ROPE
WHARTON
TUNNEL NO. 11
NO. 2 N.W.
NO. 2 N.E.
TUNNEL NO. 3
TUNNEL No. 25
NO. 2 E.
NO. 2 S.W.
NO. 4 E. BUCK
TUNNEL No. 20
No. 1 East
SLOPE 8
BEATY

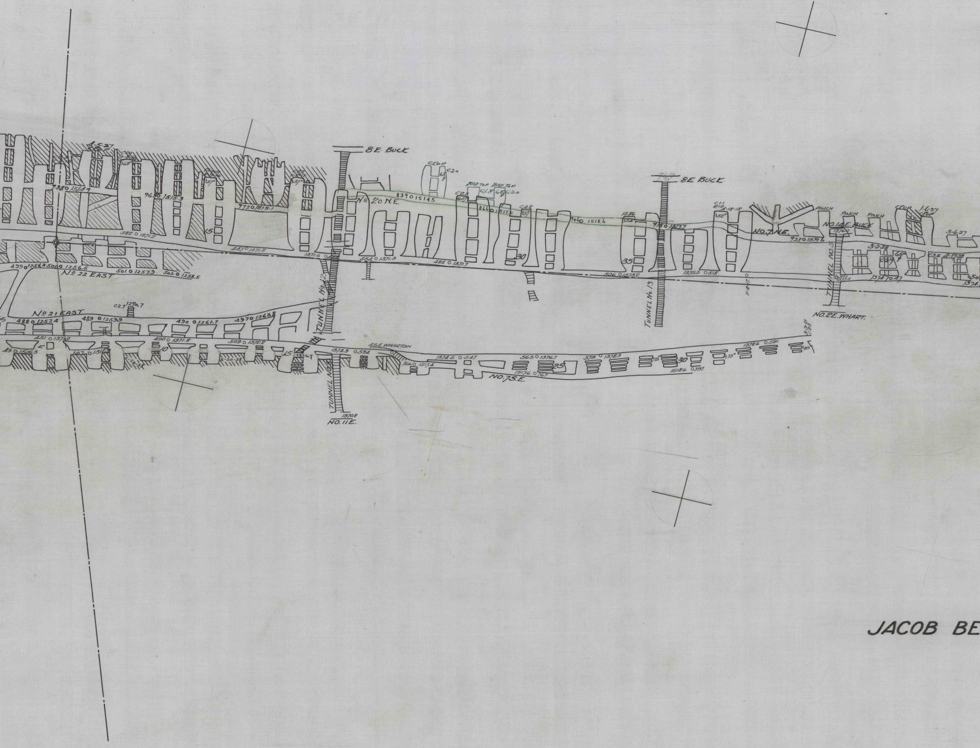
8E. BUCK
8E BUCK
No 20 N.E.
No 22 EAST
No 21 EAST
TUNNEL No 12
TUNNEL No 13
TUNNEL No 5
TUNNEL No 8
NO. 11E.
NO. 7 S.E.
NO. 7 N.E.
NO. 1 AE. BUCK
NO. 2E. WHART.
4 S.E. WHARTON
PINCH
PINCH
PINCH
CROP
CROP
BAD TOP
BAD TOP
15
15
30
35
10
15
25
30
839 0 1514.5
972 0 1515.1
963 0 1515.3
758 0 1514.9
382 0 1371.2
447 0 1371.2
454 0 1371.3
481 0 1371.7
506 0 1373.2
1375.5 0 518
915 0 1517.7
928 0 1517.6
499 0 1256.3
500 0 1256.5
501 0 1257.9
502 0 1258.5
488 0 1257.4
489 0 1259.9
490 0 1261.7
497 0 1263.8
451 0 1371.0
490 0 1371.8
509 0 1372.2
1373.3 0 534
1374.5 0 547
565 0 1376.7
579 0 1378.3
1378.6 0 591
1517.6 0 767
1518.6 0 791
1370.8
1290.7
1.5.27
5.6.27
1.6.27
3.2.28
6.20.28

JACOB BE

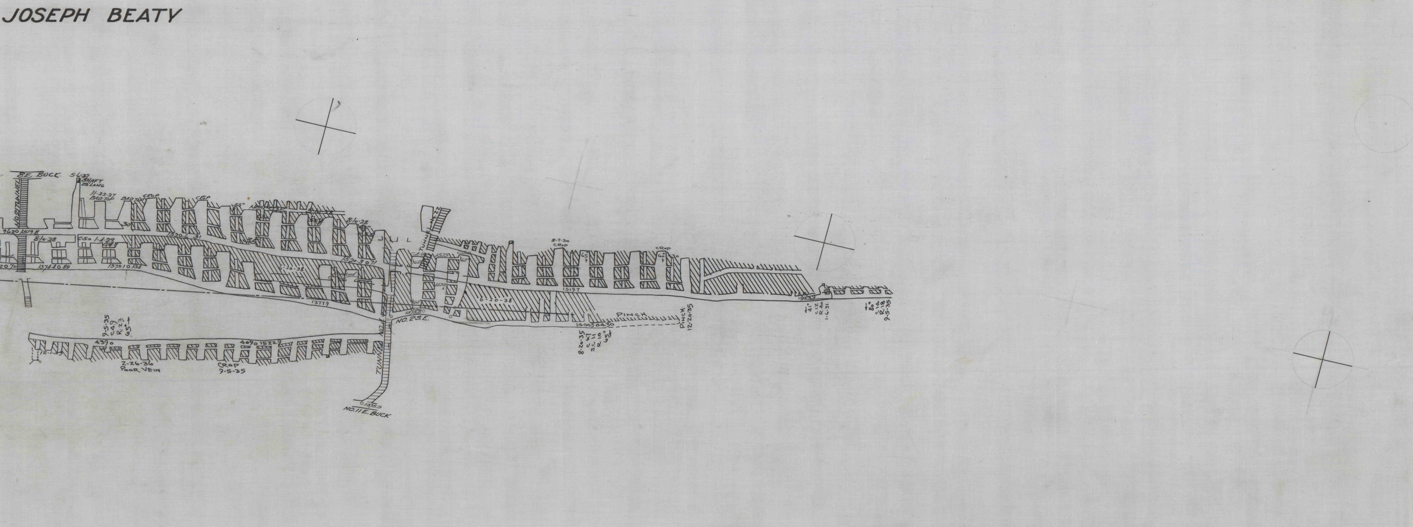
JOSEPH BEATY
8E. BUCK 5-6-27
SHAFT 25 LONG
NO.21 TUNNEL
11-22-27 BAD TOP
BAD TOP
CROP
CROP
55°
30
9620 1519.8
8-10-28
1371.4 0.89
C.5.0 1-4-29
1375.10 134
1520.6 31
8-10-28
1520.3 071
6-20-38
1377.9
TUNNEL NO.22
C.4.5
1575
C.5.0
60°
62°
1638
60°
1375.5
NO.2 S.E.
8-7-30 CROP
65°
CROP
60°
1519.7
6-20-38
PINCH
1400.3 04.30
PINCH 12-20-35
8-20-35 C 6.1 S.C. 11 R. 10 65°
1573.9
41° C.1.2 R.4.0 1-6-31.
80° C.1.4 R.1.8 9-5-35
9-5-35 C.4.9 R.2.3 65°
439.0
409.0 1522.9
12-1-49
2-26-36 POOR VEIN
CROP 9-5-35
TUNNEL NO.4
1375.9
NO.11 E. BUCK

ATY

...Eastern Middle COAL FIELD...

REVISED TO OCT. 1. 1925.
REVISED TO FEB. 1, 1929
" " JULY - 1932.
" " JANUARY - 1935.
" " MAY - 1936
" " APRIL - 1937.
" " APRIL - 1940
" " FEBRUARY - 1941.
" " January. 1943
" " FEBRUARY '45
" " DEC 1947
" " DEC 1949

ONEIDA NO1 SLOPE.

E. UNION TWP., Schuylkill & Luzerne Cnt's.,

TOP GAMMA VEIN

·8·HAZLETON DISTRICT. . .1"=100'. . .

COXE BROS. & CO.

MF
MAR 10 1972

STATE MINE INSPECTOR JUNE 1924. . ISKANDER.