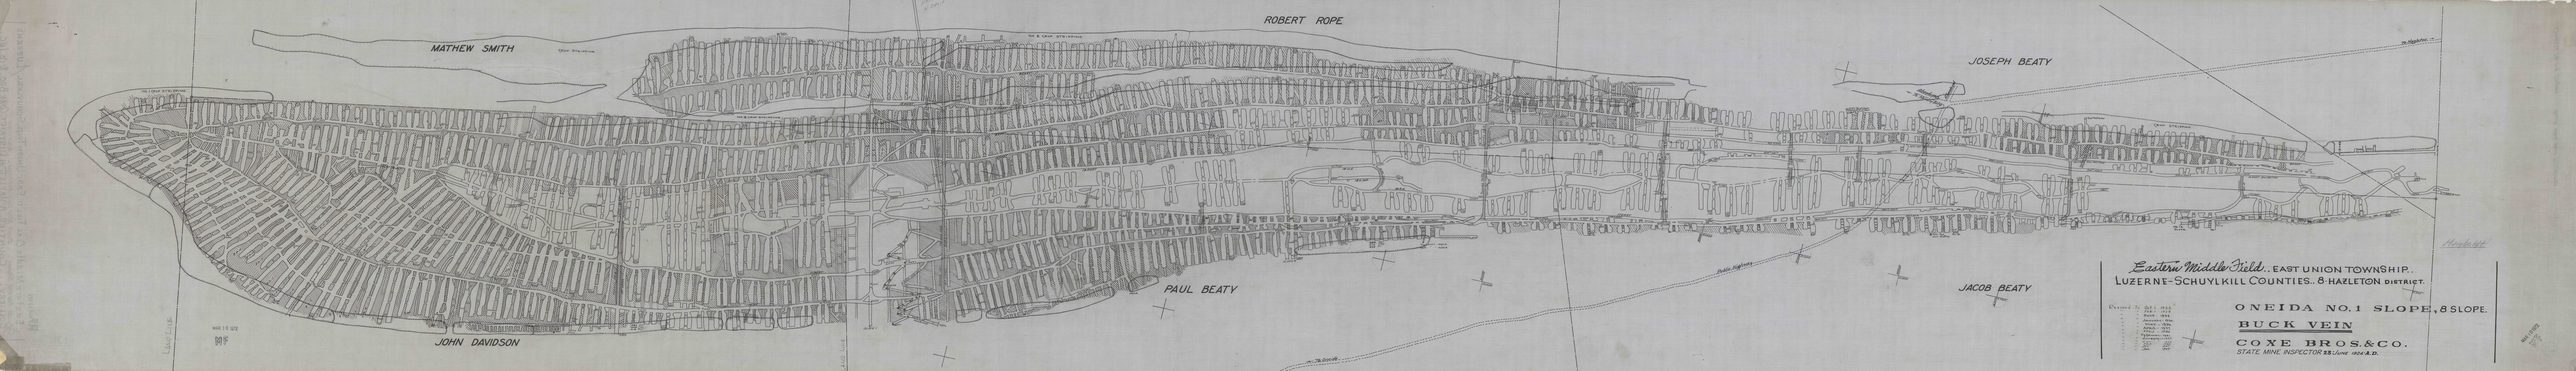
MATHEW SMITH
ROBERT ROPE
JOSEPH BEATY
PAUL BEATY
JACOB BEATY
JOHN DAVIDSON
Eastern Middle Field, EAST UNION TOWNSHIP,
LUZERNE-SCHUYLKILL COUNTIES & HAZLETON DISTRICT.
ONEIDA NO. 1 SLOPE, & SLOPE.
BUCK VEIN
COXE BROS. & CO.
STATE MINE INSPECTOR 22 June 1926 A.D.