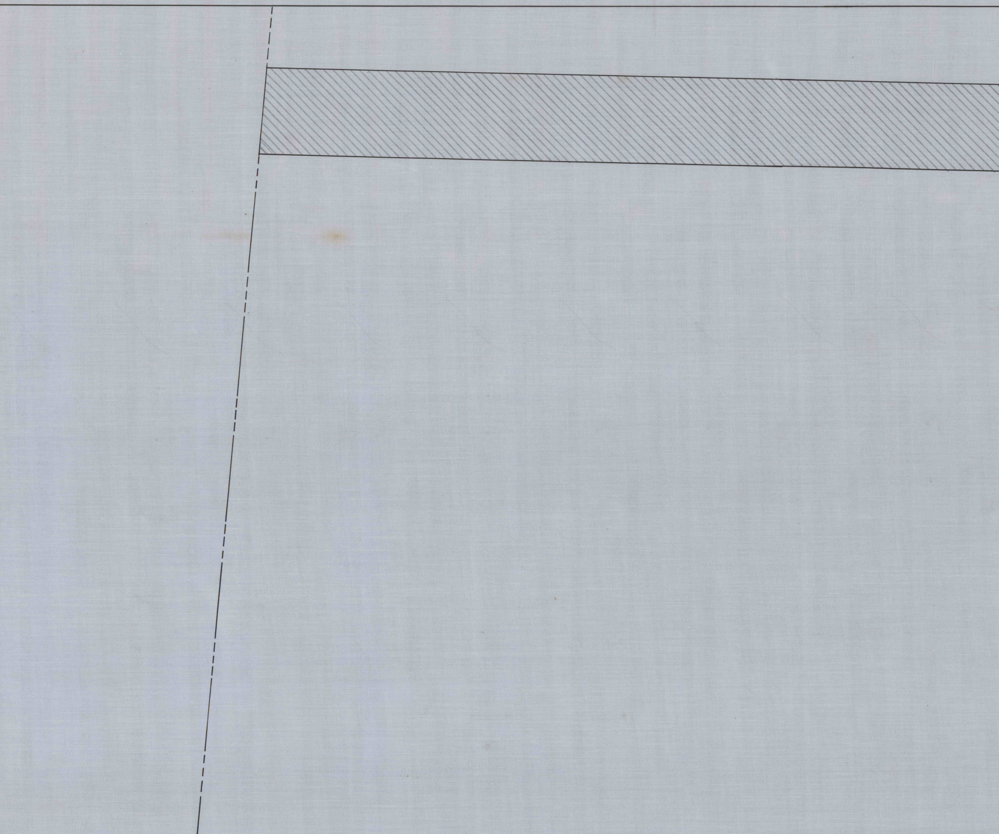

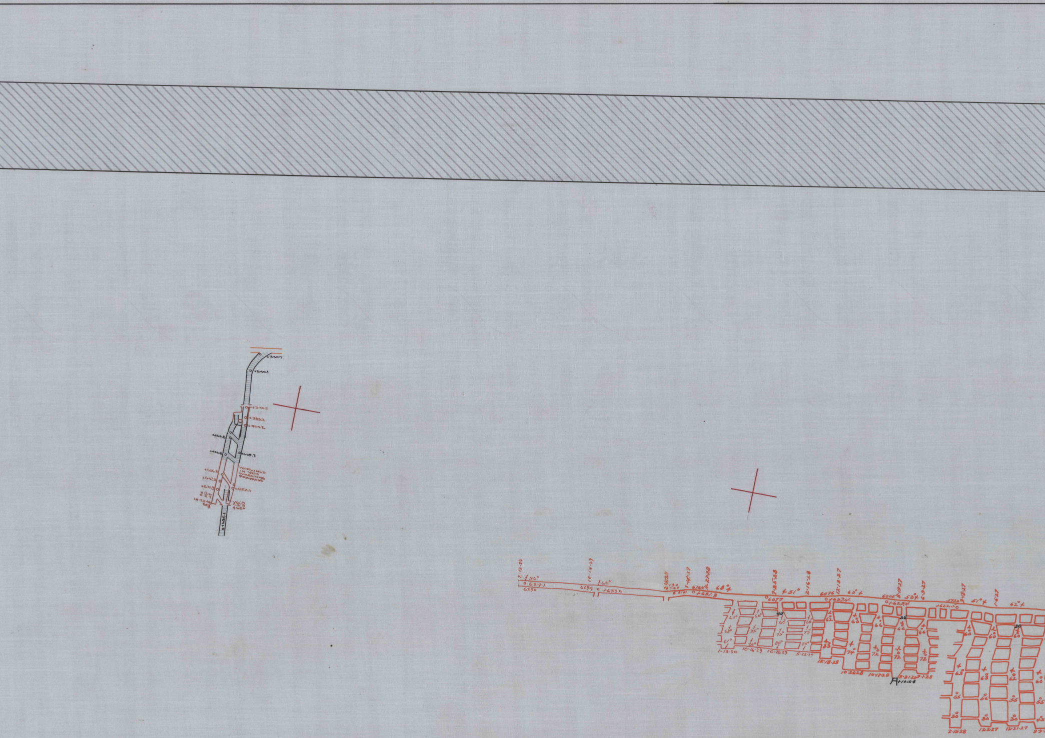
+840.7
+840.1
+340.7
+383.2
+404.2
+424.8
+476.8
+469.7
WORKINGS IN VEIN OVERLYING PRIMROSE
+525.8
+542.3
+571.3
+582.1
10-23-46
60°
68°
+635.1
2-13-30
56°
634.1
6390
10-14-29
60°
6294
+633.0
2-12-29
1-14-29
1-27-28
6164
6181
+651.3
68°
7-25-28
51°
6077
2-16-28
6076
12-13-27
60°
+627.4
6006
8-19-27
58°
6-9-27
+625.4
5832
3-18-27
51°
+622.5
1-6-27
62°
40
35
30
63°
60°
68°
75°
61°
80°
62
66
83
74°
72
60
63
56
55
30
1-13-30
10-16-29
10-16-29
5-22-29
12-18-28
10-26-28
10-17-28
8-21-28
9-1-28
A +1012.8
2-15-28
12-2-27
12-21-27

⑥ SPEED

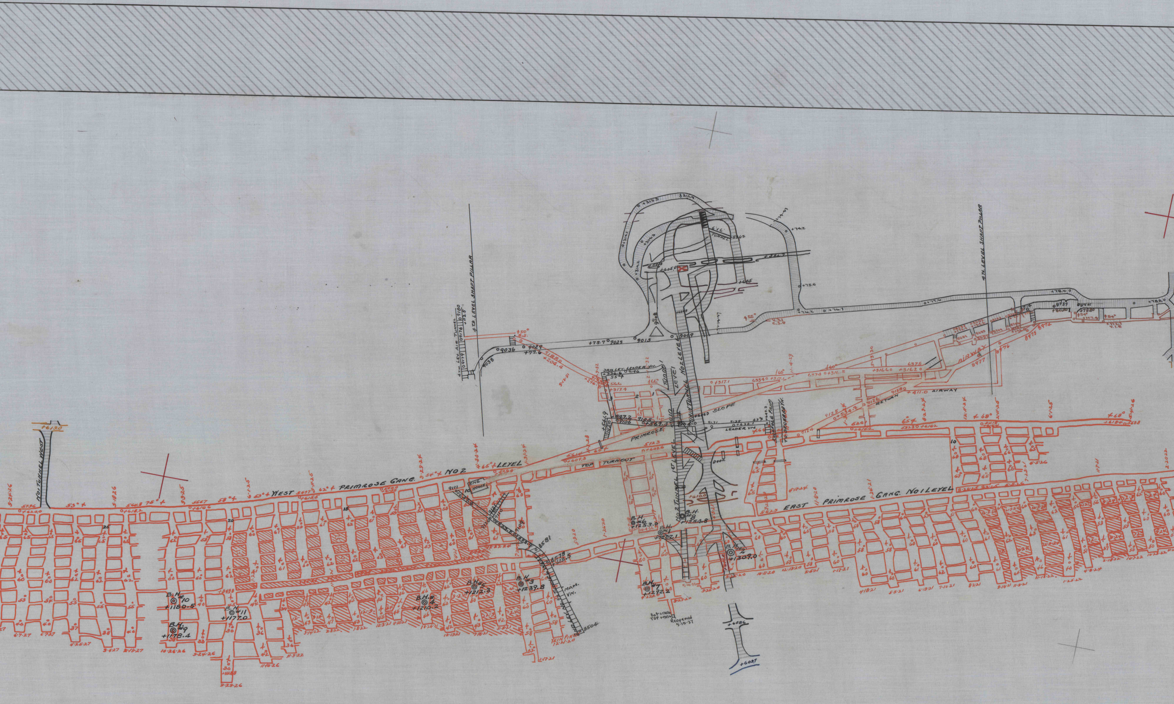
NO1 TUNNEL WEST
+619.0
WEST PRIMROSE GANG. NO2 LEVEL
TOP TURNOUT
ENG. HOUSE
4th LEVEL SHAFT PILLAR
4th LEV. AIR TUNNEL
3RD LEV. LEADER VN.
TUNNEL LEVEL
NO2 LEVEL MAIN TUNNEL
NO2 TUNNEL 1st LEVEL
PRIMROSE
SLOPE
LEADER VN.
BOREHOLE PROP.
TO ORCHARD VN.
DOOR
6'x6' TUNNEL
AIRWAY
RETURN
+411.0 AIRWAY
EAST PRIMROSE GANG. NO1 LEVEL
MAM. VN.
VEIN PINCH 12-21-20
B.H. #1 +1267.1
B.H. #2 +1309.0
B.H. #3 +1239.8
B.H. #4 +1210.2
B.H. #5 +1212.3
B.H. #6 +1253.0
B.H. #7 +1292.2
B.H. #8 +1252.8
B.H. #9 +1178.4
B.H. #10 +1180.5
B.H. #11 +1177.0
Bot +1301.6
TOP +1317.6
Reopened 5-10-37
+6086
+6037
+605.0
+610.0

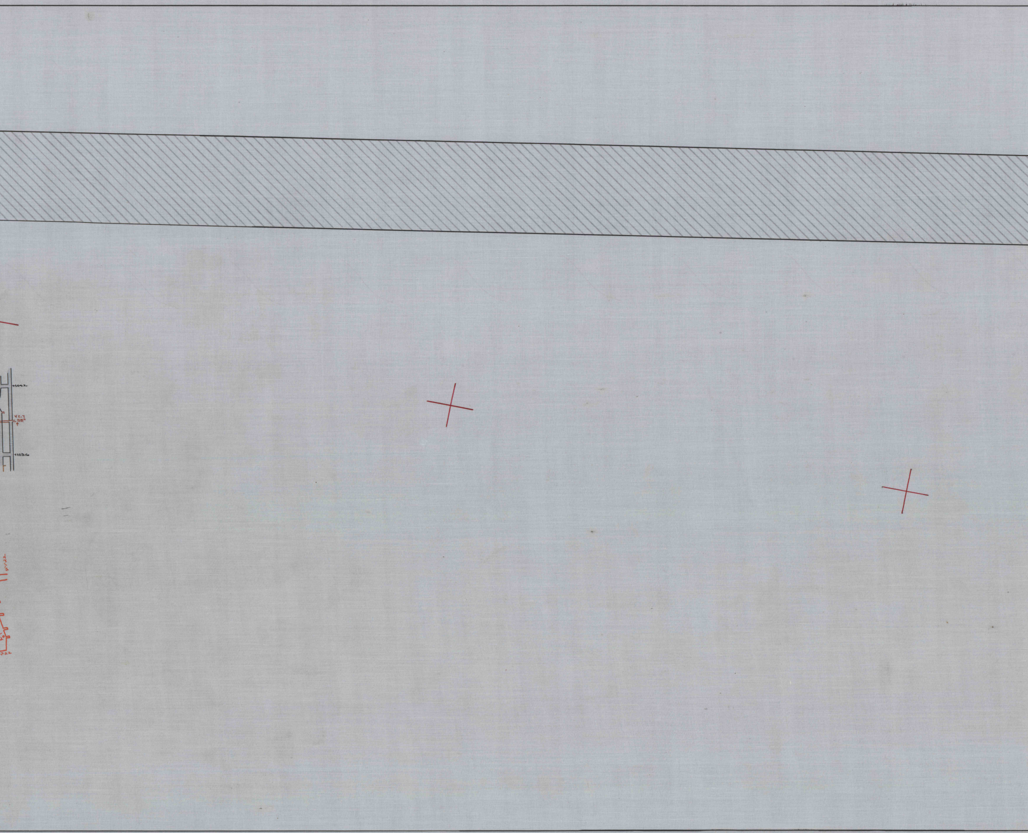
+104.2
VZ.7
55°
+103.6
4.1.22
.7.22

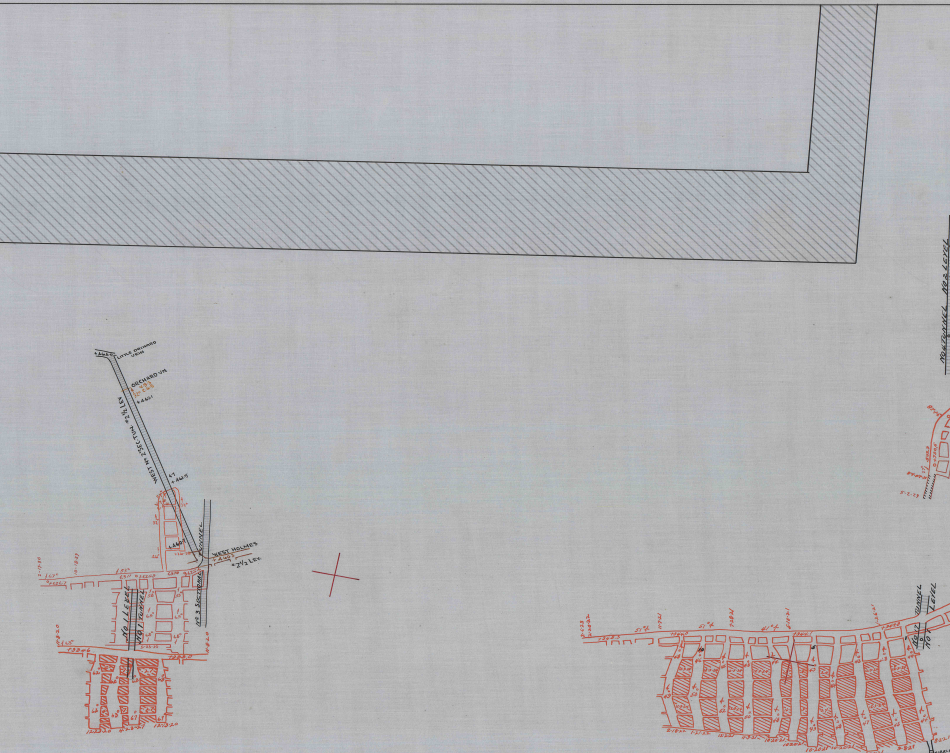
+464.0
LITTLE ORCHARD VEIN
ORCHARD VN
V.9.3
32° C.6.8
+462.1
WEST No 2 SEC. TUN. *2½ LEV
+461.5
+460.7
1.26.38
TUNNEL
WEST HOLMES
+460.3
*2½ LEV.
2-17-30
10-18-29
67°
53°
0+626.7
6311
0+626.9
6310
625.6
No 1 LEVEL
No 1 TUNNEL
No 3 SECTIONAL
58
53°
65°
68°
5-23-30
11-8-20
63°
+934.6
+933.0
62°
67
69°
12.23.20
4.23.27
12.13.20
NO 4 TUNNEL
NO 2 LEVEL
5-2-29
11-20-28
27°
502.9
0+790.5
2.6.23
2.20.22
11.7.21
7.28.21
5.18.21
1.26.21
51°
41°
+945.3
+944.0
+944.1
+944.8
TUNNEL
LEVEL
No 1
12.9.24
2.18.22
1.21.22
12.2.21
11.3.21
10.20.21
8.26.21
9.8.21
8.22.21
+1351.

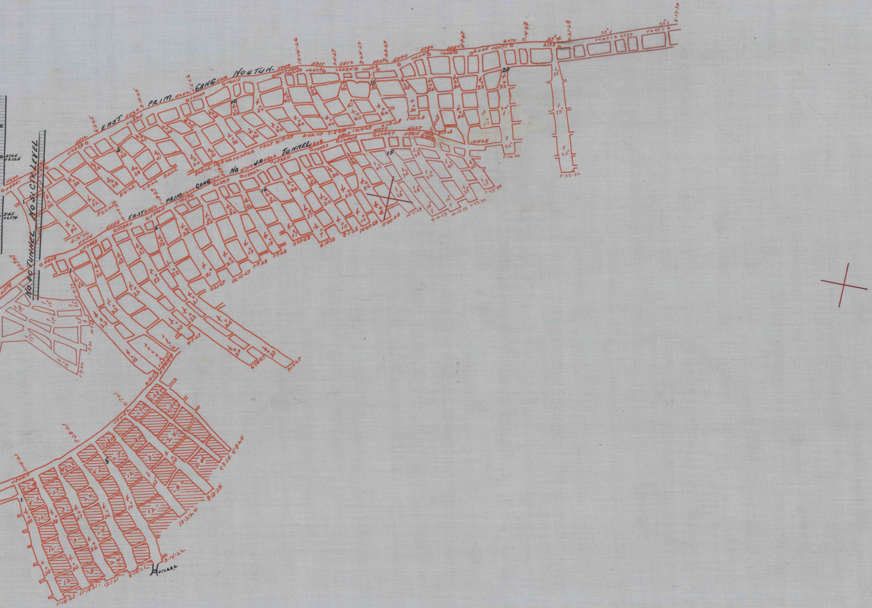

EAST PRIM. GANG No 4 TUN.
EAST PRIM. GANG No 40 TUNNEL
No 40 TUNNEL No 51 CTR LEVEL
3764 +6325
3765 +6374
5500 +6351
5502 +6393
5
10
15
20
1-10-30
1-23-30
2-17-30
H +1263.2

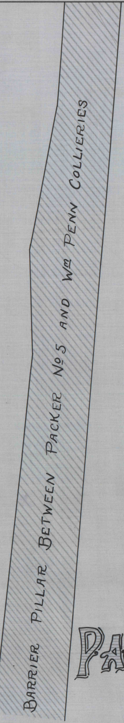
BARRIER PILLAR BETWEEN PACKER NO 5 AND WM PENN COLLIERIES

WESTERN MIDDLE COAL FIELD

PRIMROSE VEIN

at

PACKER COLLIERY NO. 5.

...BUTLER TOWNSHIP...
OF THE
SCHUYLKILL COUNTY, PA.,
Lehigh Valley Coal Company

ENGINEERING DEPT.

L.V.C.Co.

100 ft.=1 in.

GIRARD DIVISION
APR. 1929 R.S.

MF
MAR 10 1972

(6) "SPEED"