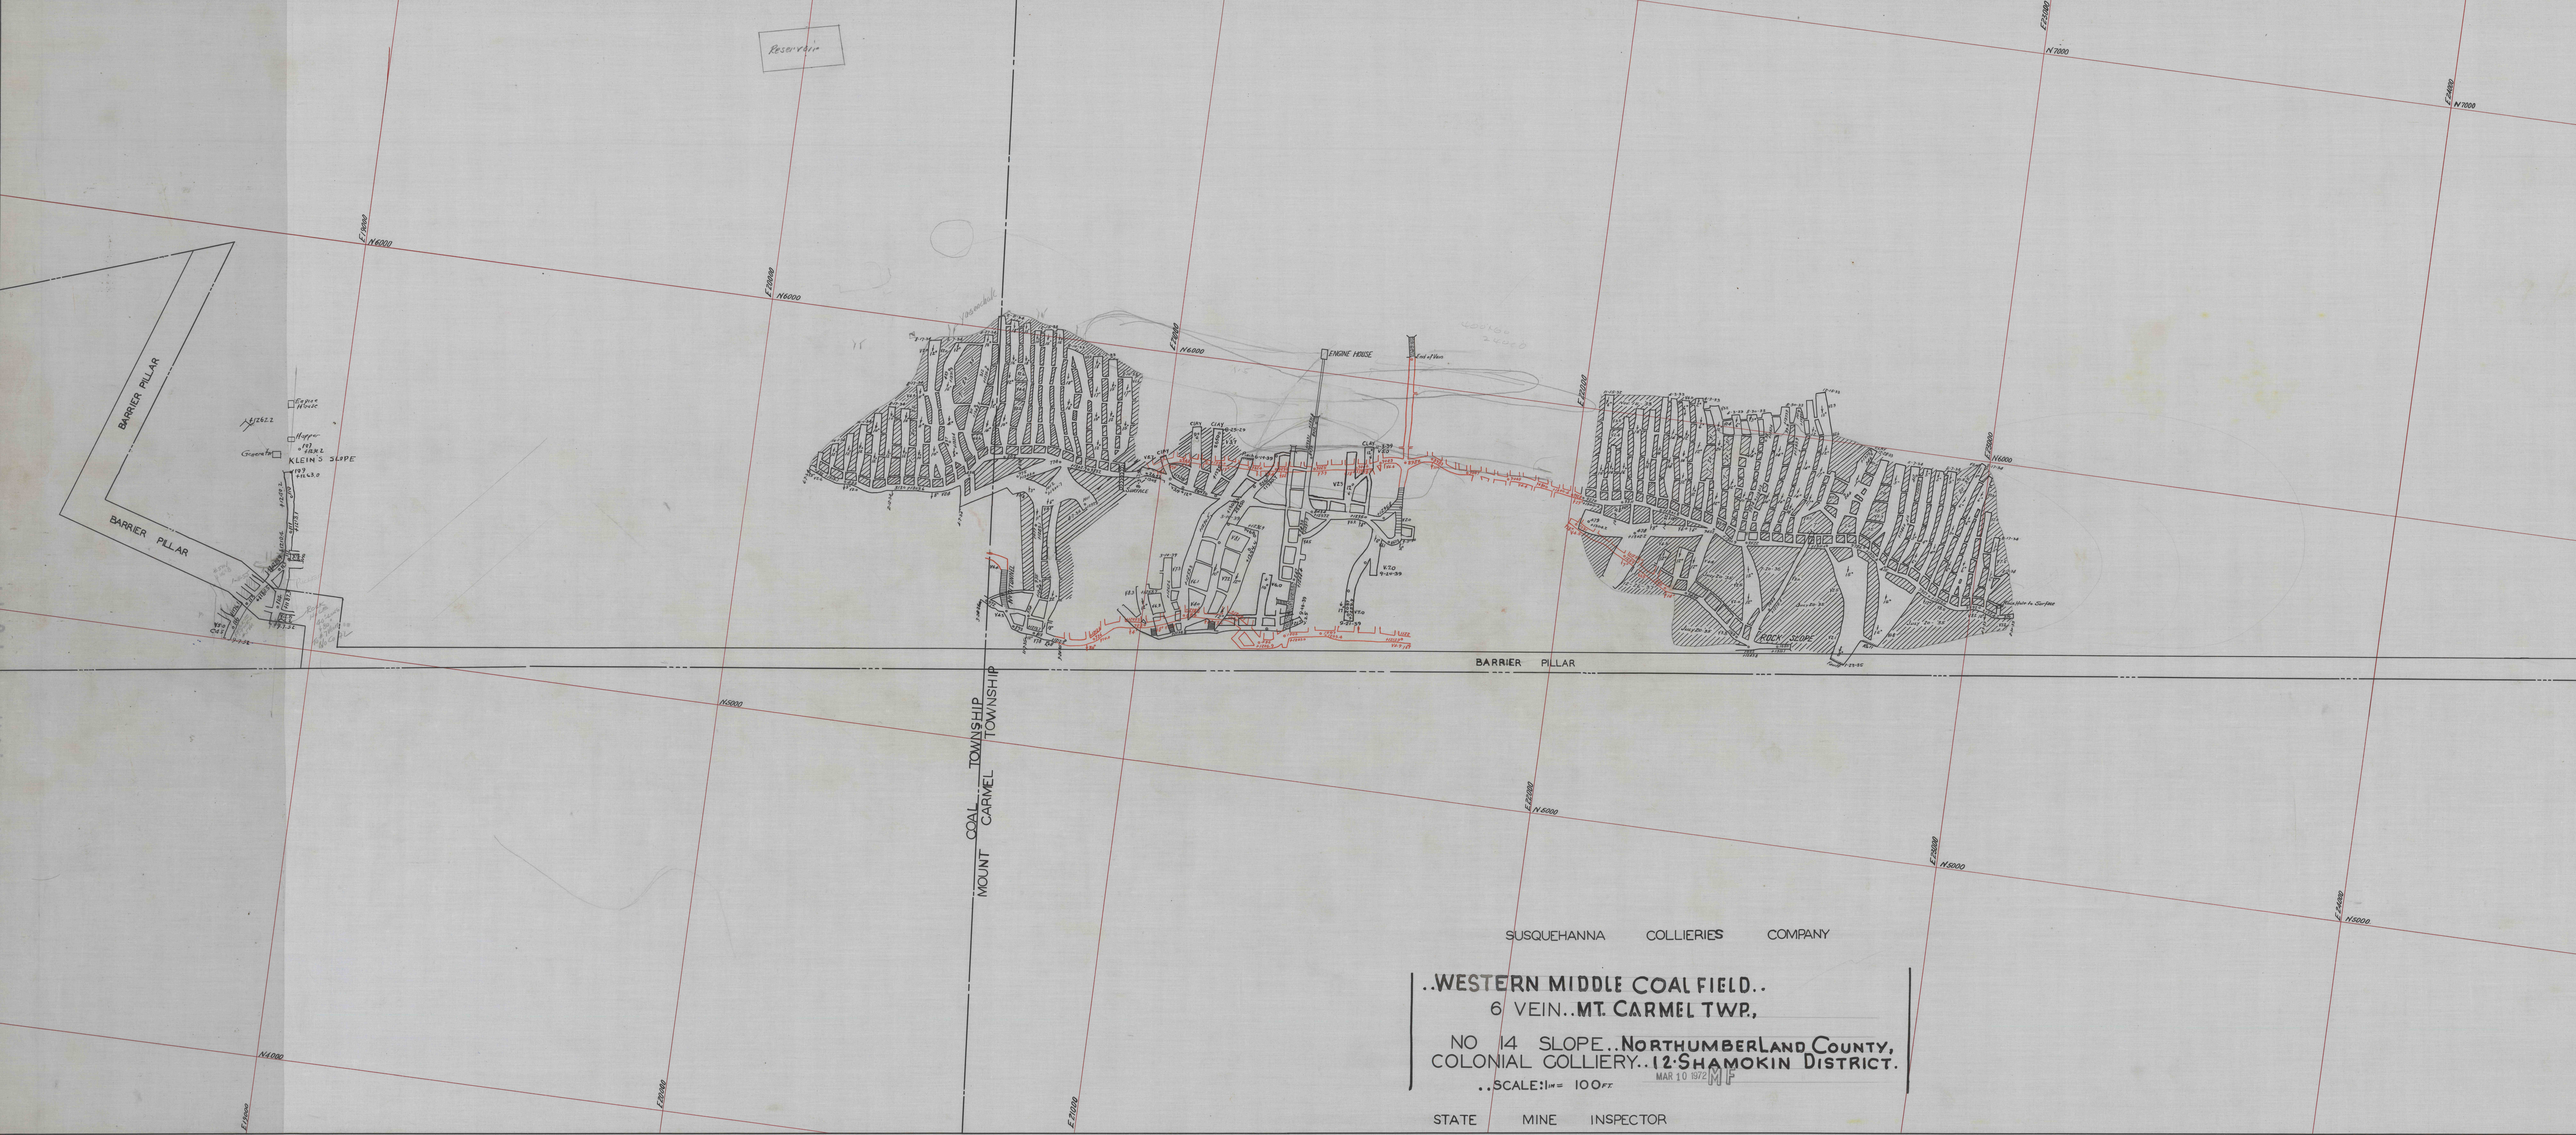

SUSQUEHANNA COLLIERIES COMPANY

..WESTERN MIDDLE COAL FIELD..
6 VEIN..MT. CARMEL TWP.,
NO 14 SLOPE..NORTHUMBERLAND COUNTY,
COLONIAL COLLIERY..12:SHAMOKIN DISTRICT.
..SCALE:1in= 100ft

MAR 10 1972 MF

STATE MINE INSPECTOR