


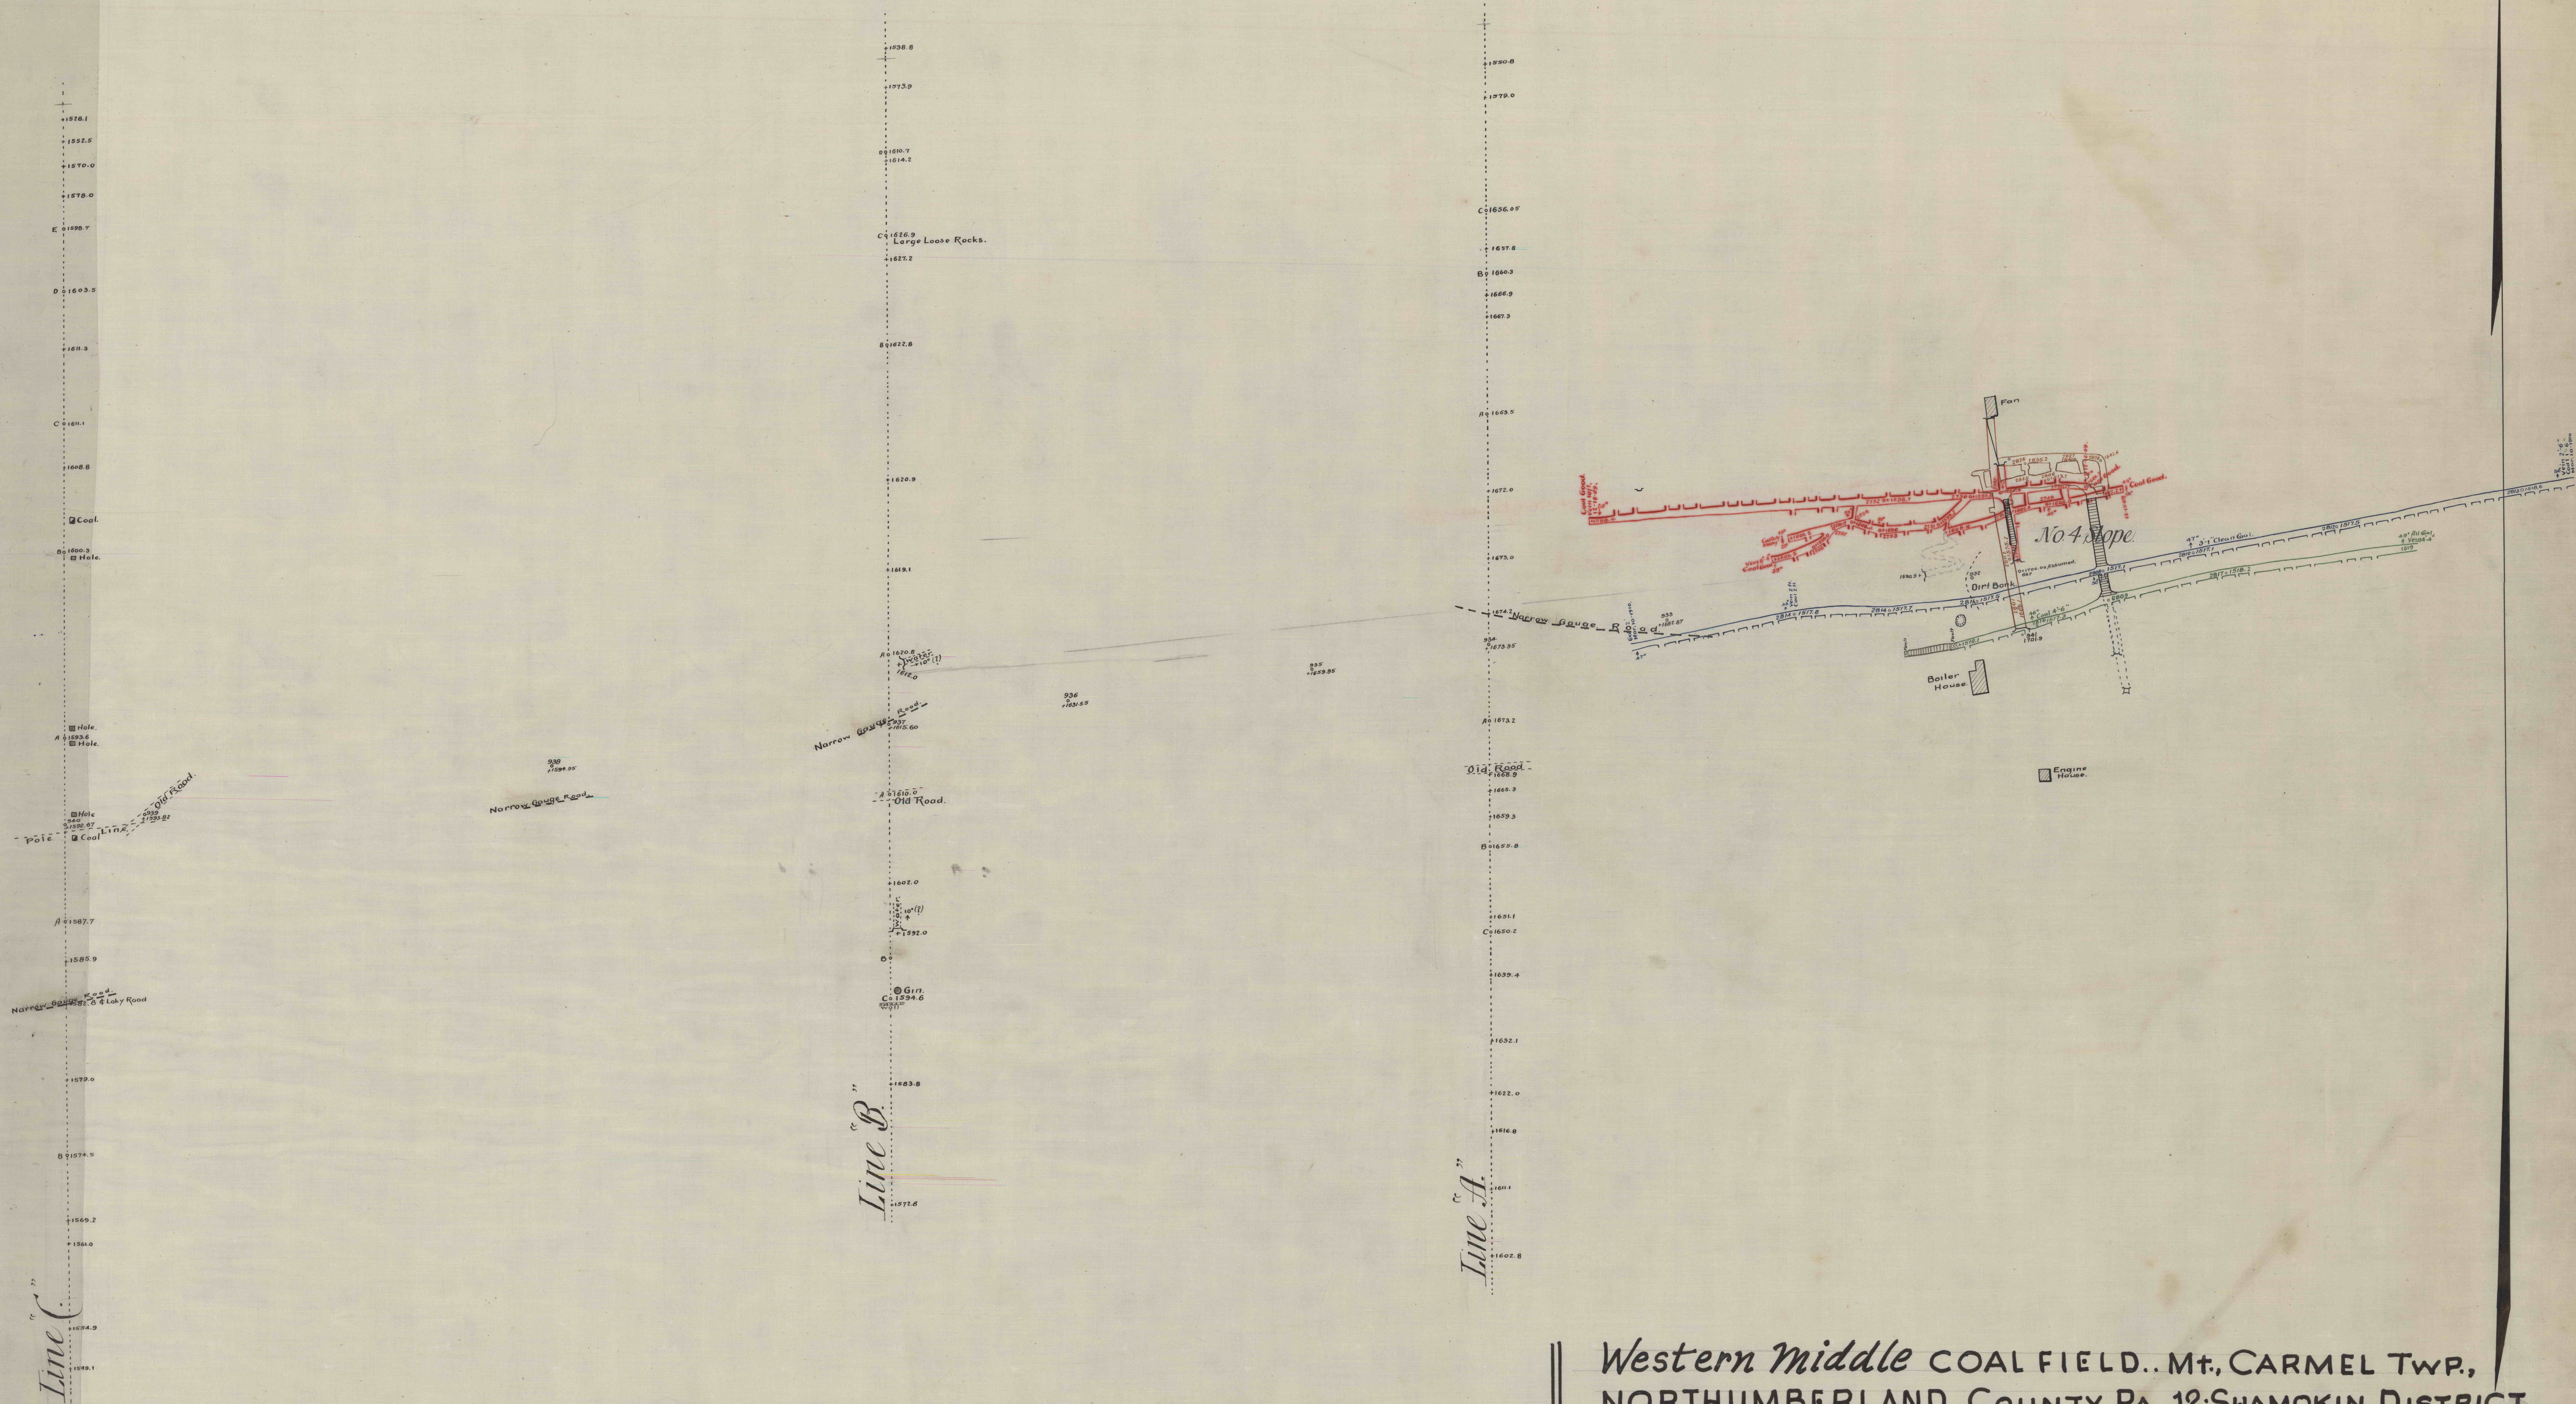

Western Middle COAL FIELD..Mt. CARMEL TWP.,
NORTHUMBERLAND COUNTY PA., 12 SHAMOKIN DISTRICT.
Natalie Colliery - Colonial Collieries Company - Operators.
Map showing the mine workings from No. 4 Slope and the relative
position of Section Lines - A - B and C.
Scale: 1 inch = 100 feet. January 1910 ~ William S. Pugh,
Mining Engr., Pottsville, Pa.

MAP 10 1072
W.P.