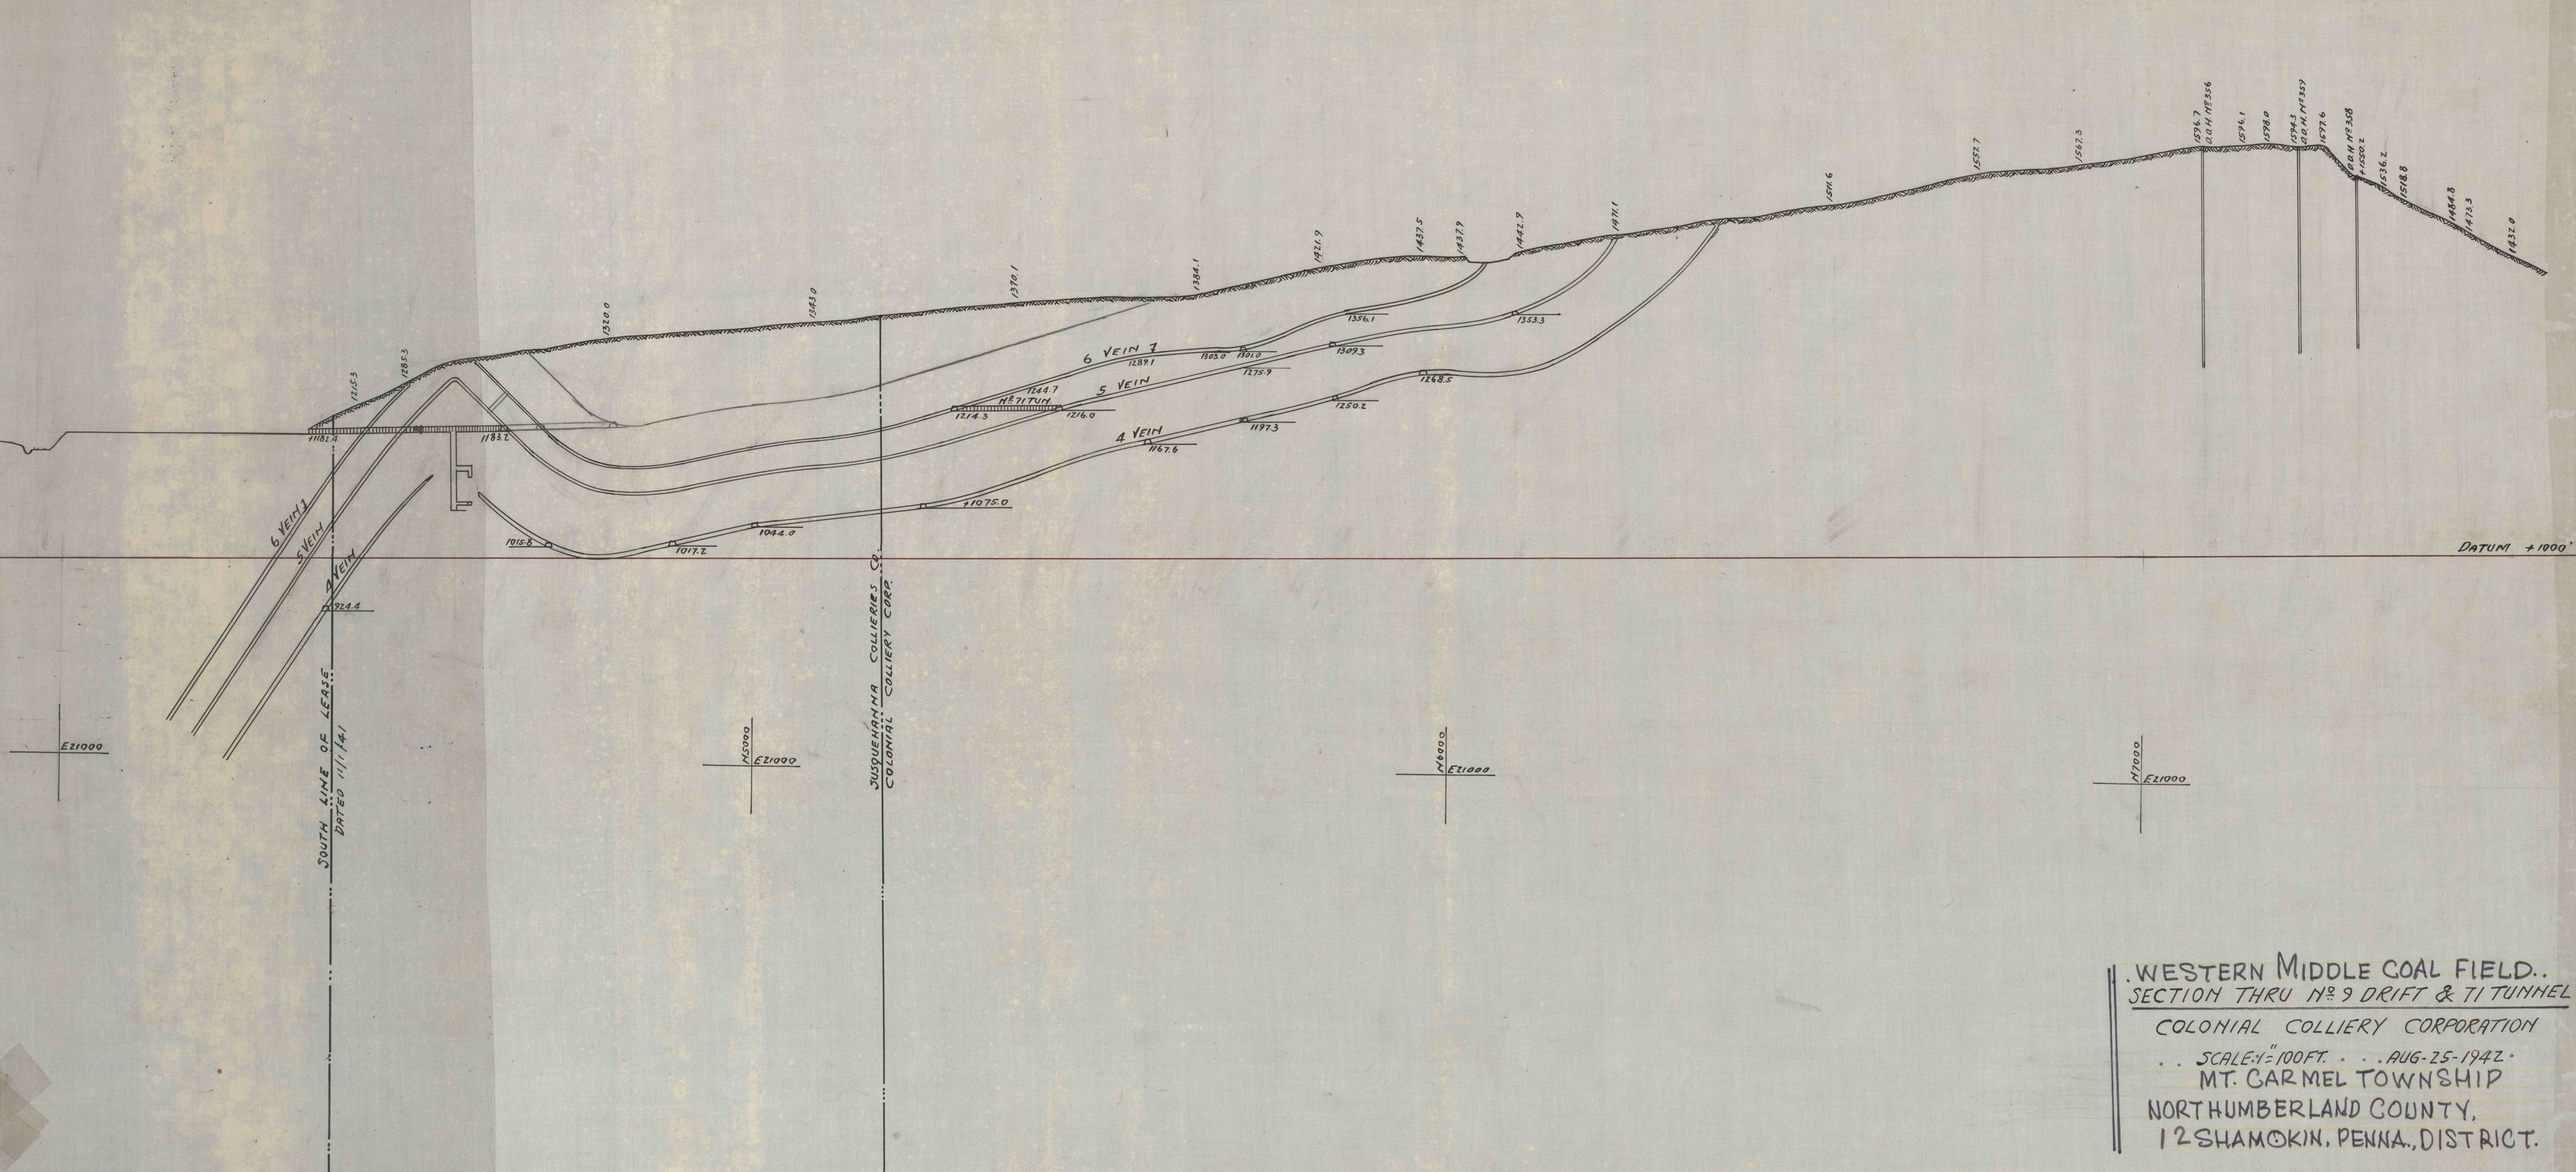

WESTERN MIDDLE COAL FIELD.
SECTION THRU No. 9 DRIFT & 7 TUNNEL
COLONIAL COLLIERY CORPORATION
SCALE: 1" = 100 FT. . . AUG-25-1942.
MT. CARMEL TOWNSHIP
NORTHUMBERLAND COUNTY,
12 SHAMOKIN, PENNA., DISTRICT.