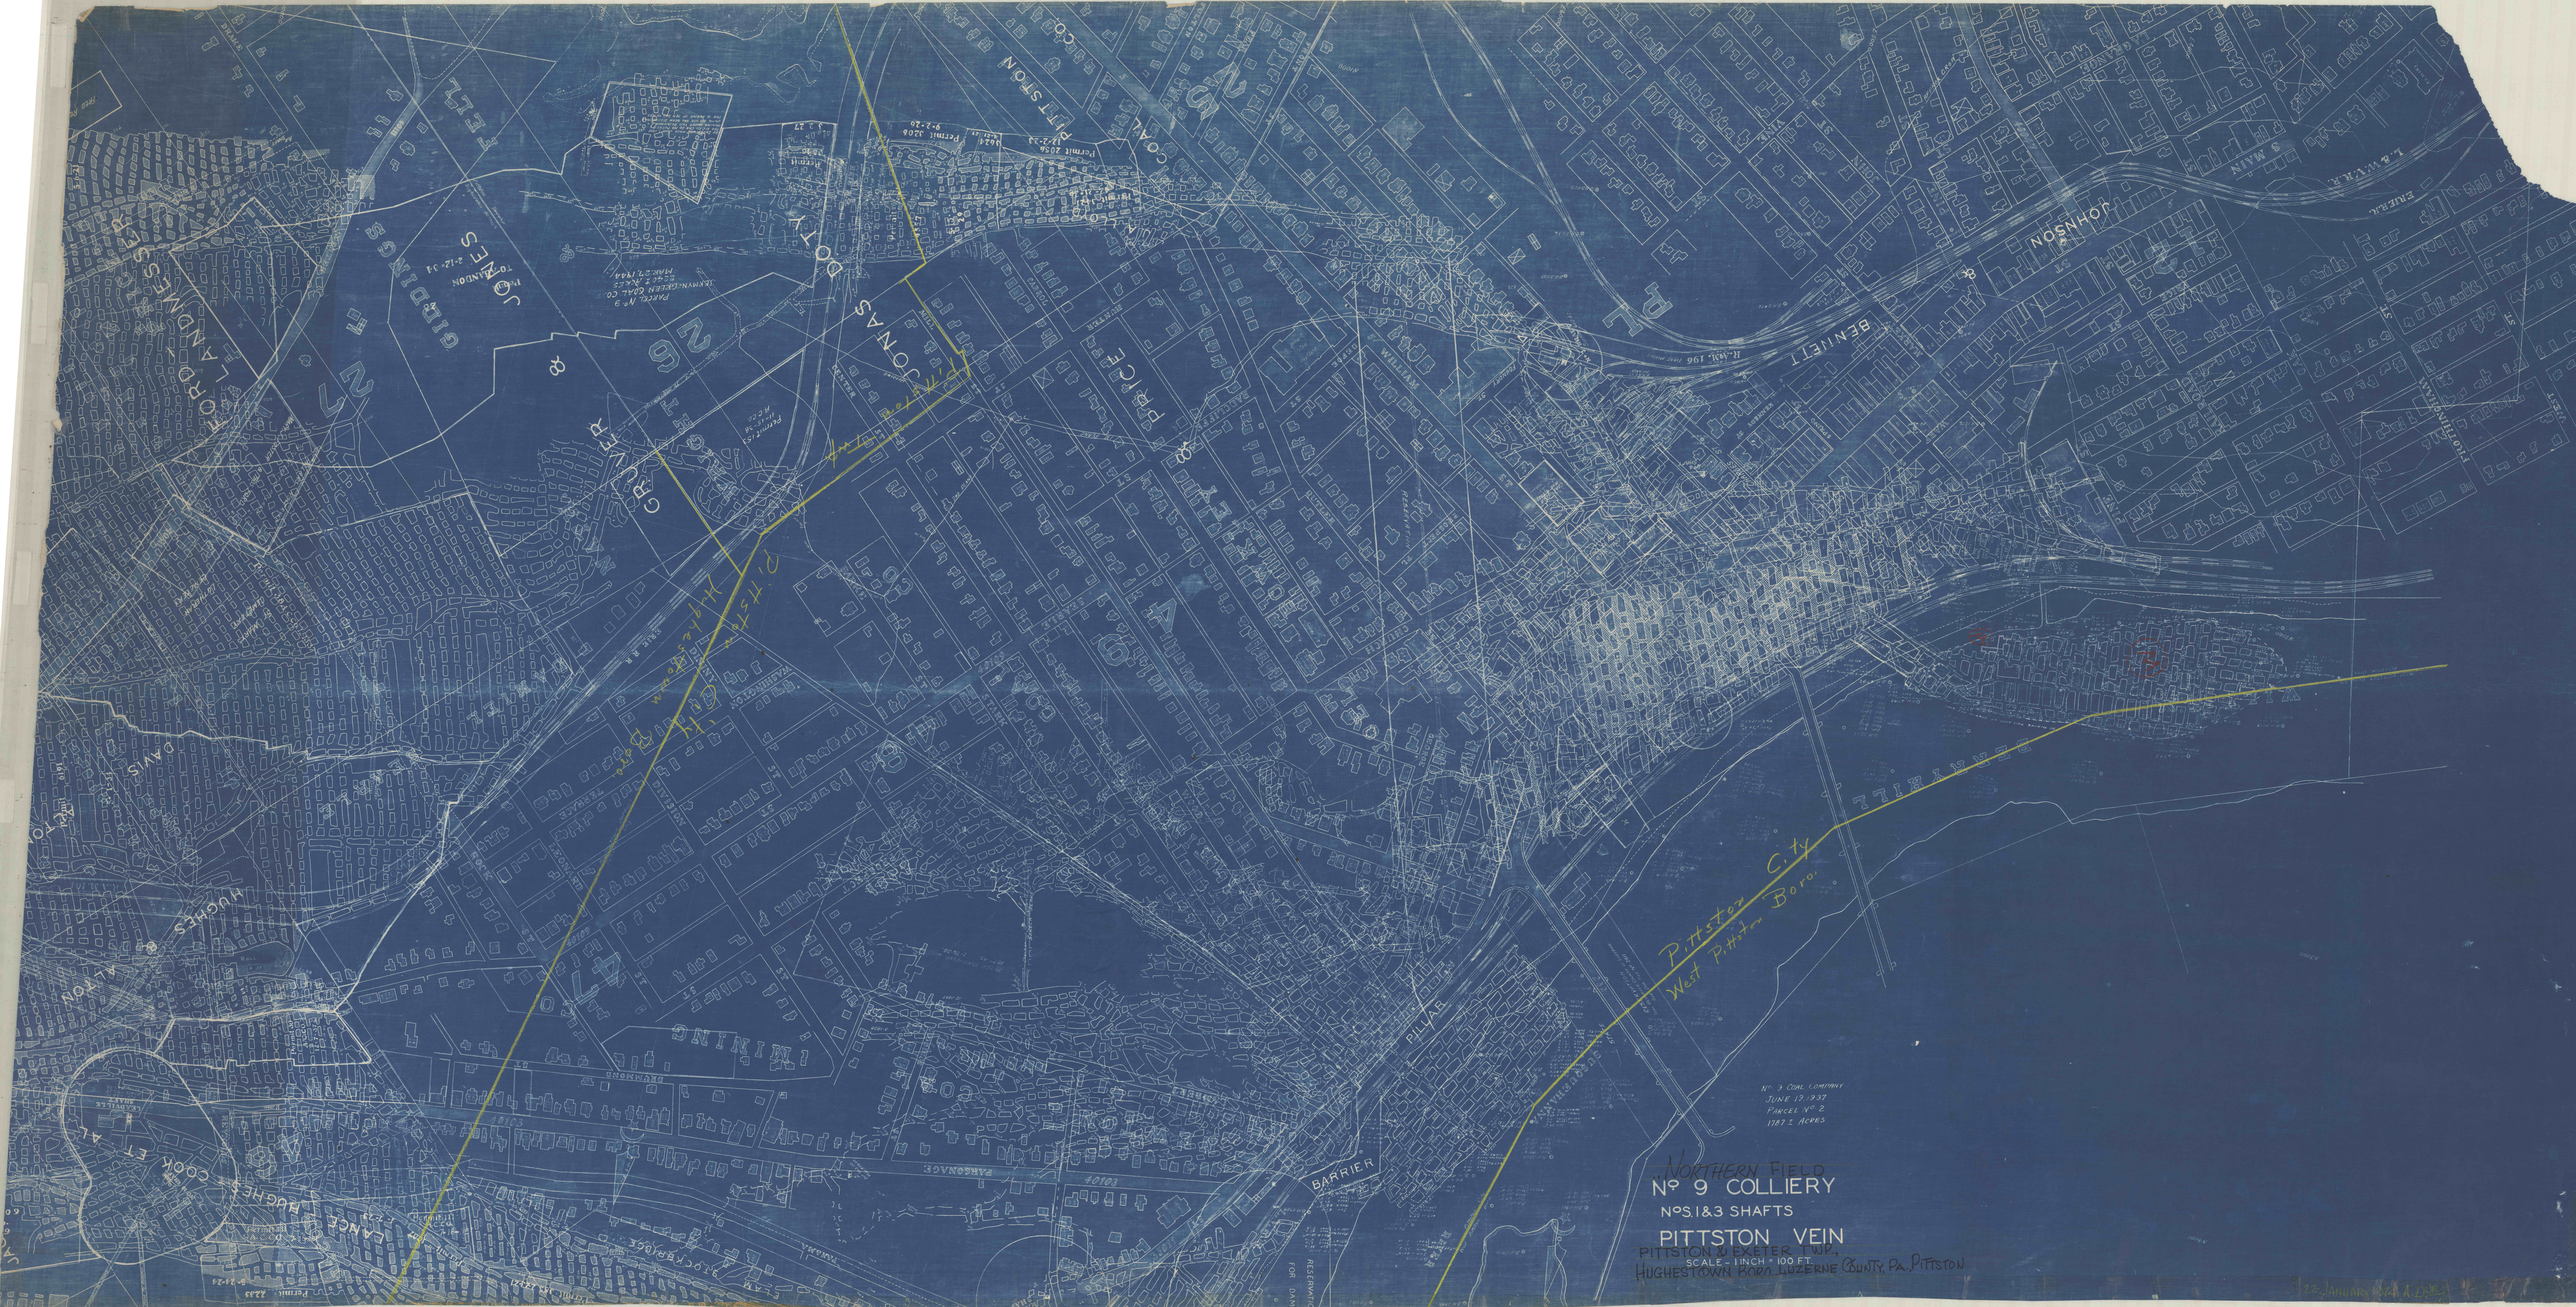

Northern Field
No. 9 COLLIERY
Nos. 1 & 3 SHAFTS
PITTSTON VEIN
PITTSTON & EXETER TWP.,
SCALE - 1 INCH = 100 FT.
Hughestown Boro., Luzerne County, Pa., Pittston

No. 9 COAL COMPANY
JUNE 19, 1937
PARCEL No. 2
178.1 ACRES
West Pittston Boro.
Pittston City
Pittston City
Hughestown Boro.
Pittston Twp.
Pittston Twp.
BARRIER
PILLAR
STOCKBRIDGE
PARSONAGE
DRUMMOND
MINING
47
48
49
LANCE & HUGHES, COOK ET AL
HUGHES & ALTON
DAVIS
FORD
LANDMESSER
GRUVER
&
JONES
GIDDINGS
FELL
26
27
JONAS
DOTY
PRICE
&
JOHNSON
&
BENNETT
PARCEL No. 9
JERMYN-GREEN COAL CO.
2240± ACRES
MAR. 27, 1944
Permit TO ABANDON
2-12-34
Permit 153
11-15-38
A.C.CO.
Permit 1421
12-21-26
Permit 2056
12-2-23
3624
4-21-27
Permit 3206
9-2-26
Permit
3 2 27
BY INDENTURE MADE JUNE 1, 1902 THE P.C.Co. CAN DO NO FURTHER MINING UNDER THIS RESERVOIR UNTIL ITS USE HAS BEEN DISCONTINUED FOR A PERIOD OF TEN (10) YEARS
COAL
PITTSTON
CO.
25
HUNTER
CENTER
MILL
L. & W.V.R.R.
ERIE R.R.
MAIN
AIR SHAFT
Permit 2233
5-2-24