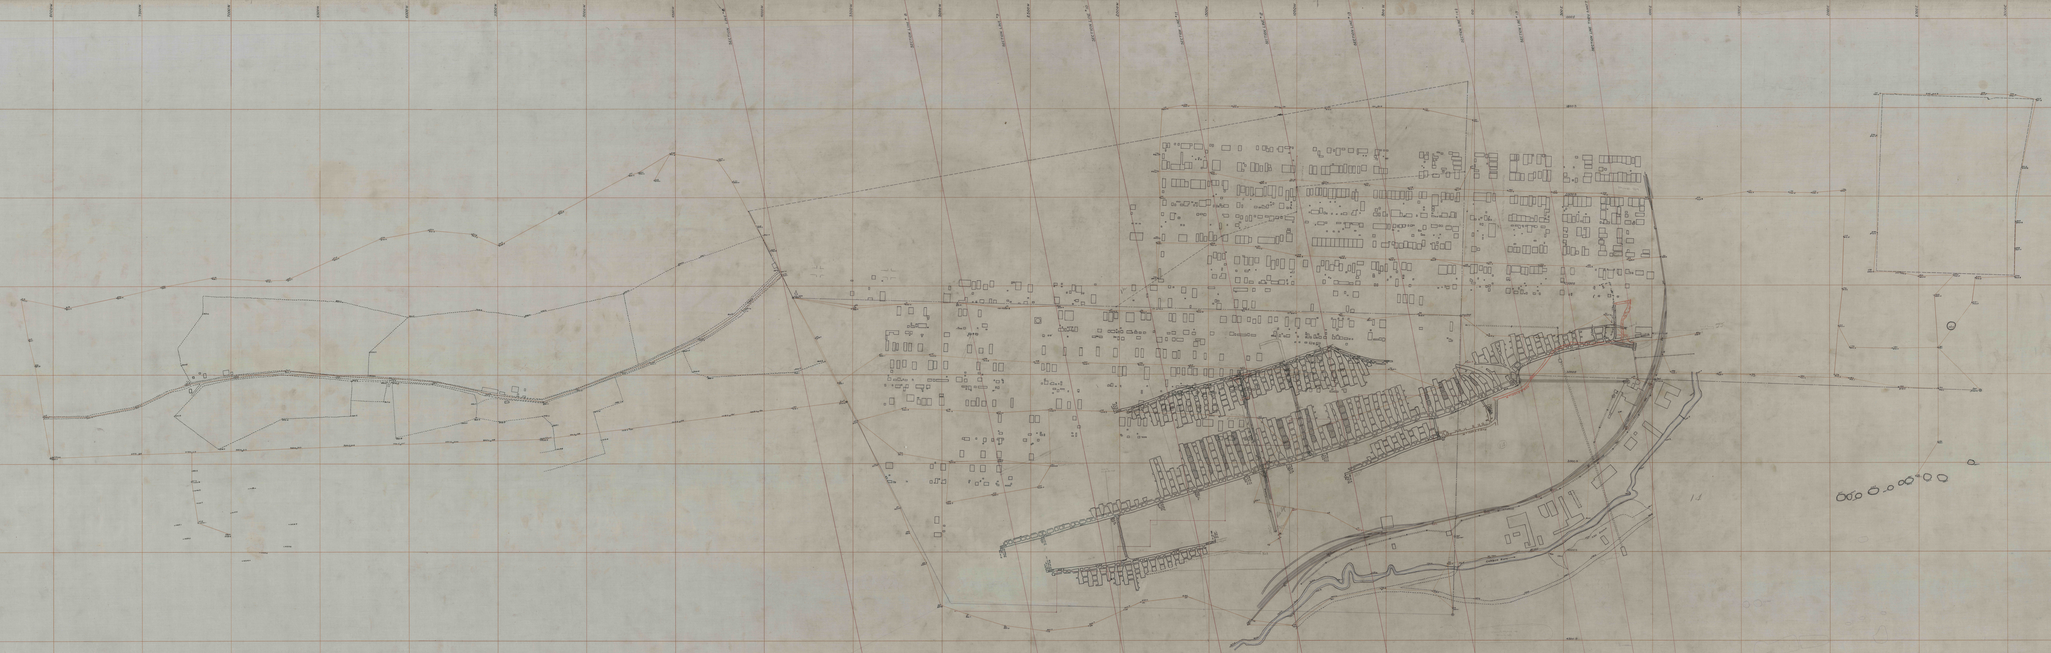


..WESTERN Middle Coal Field..

NEILSON COLLIERY

SHAMOKIN COAL CO.

Map Showing ..COAL TWP. NORTHUMBERLAND

NO 14 VEIN WORKINGS. ..COUNTY PA.

P.J. Friel, State Inspector of Mines, 12 SHAMOKIN Dis

Scale 1"=100 April 13, 1953