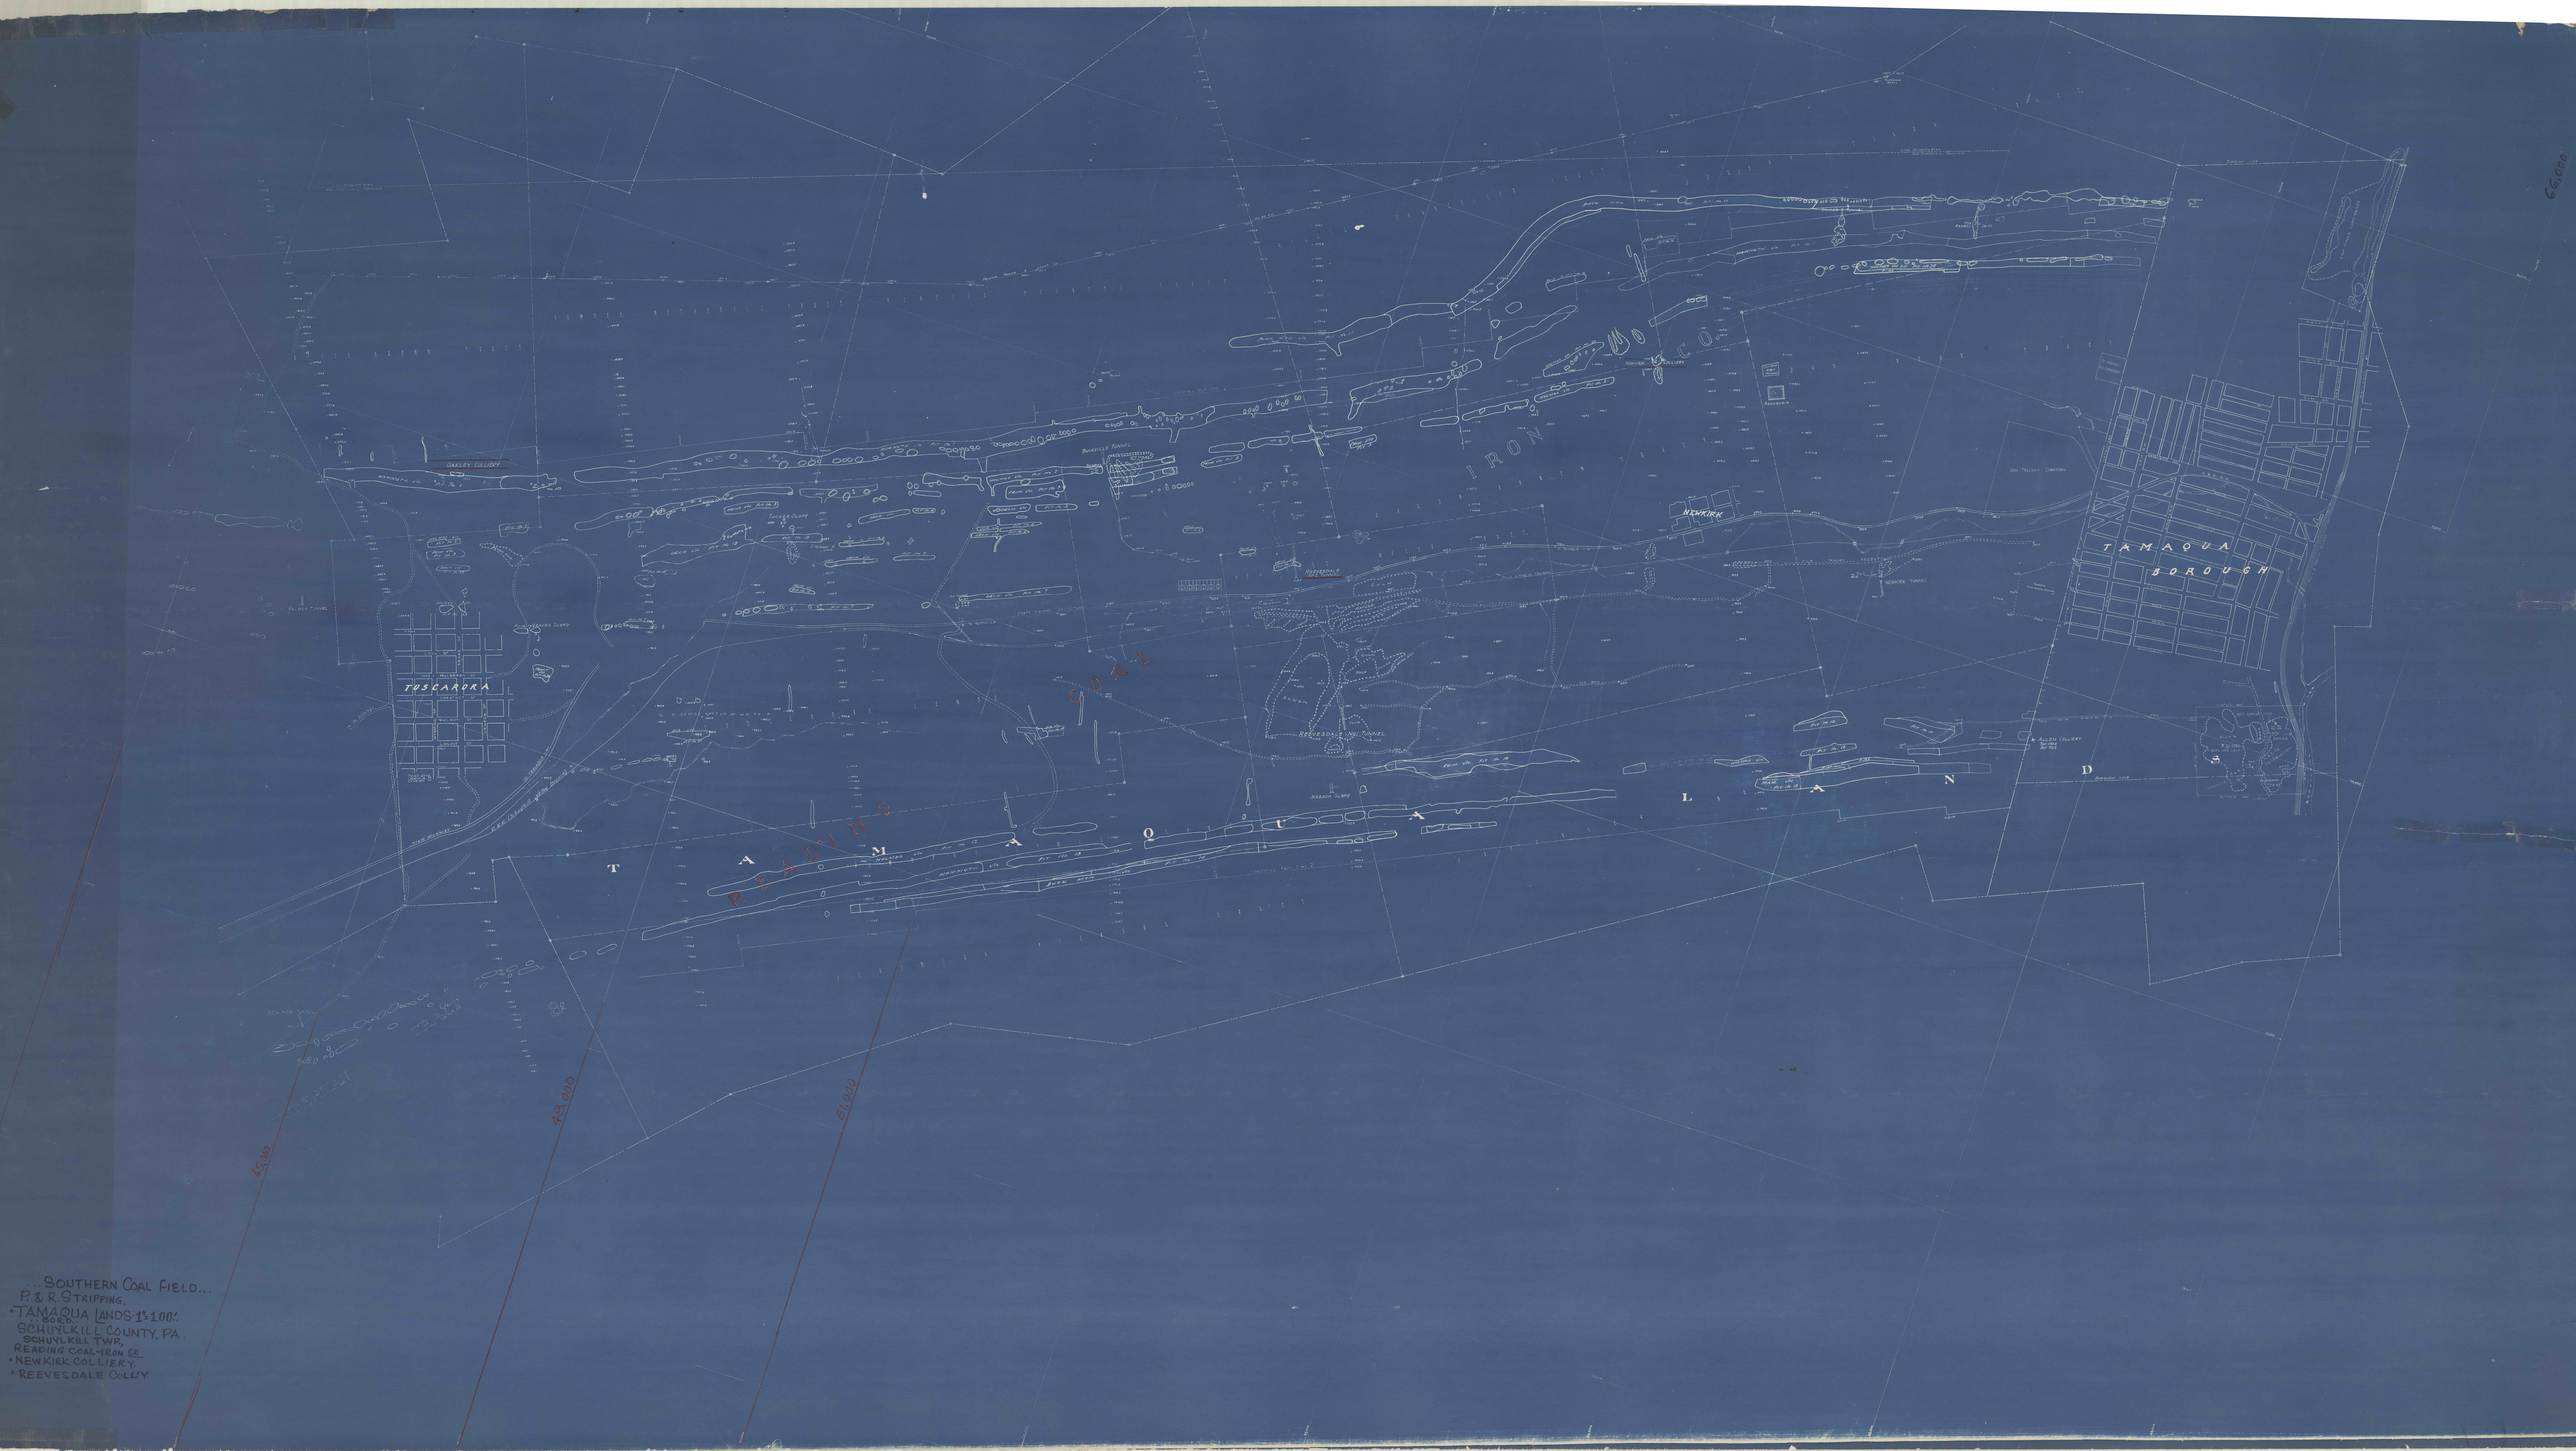

SOUTHERN COAL FIELD...
P & R STRIPPING.
*TAMAQUA LANDS: 1" = 100'.
BOROUGH
SCHUYLKILL COUNTY, PA.
SCHUYLKILL TWP.
READING COAL-IRON CO.
* NEWKIRK COLLIERY.
* REEVESDALE COLLY.