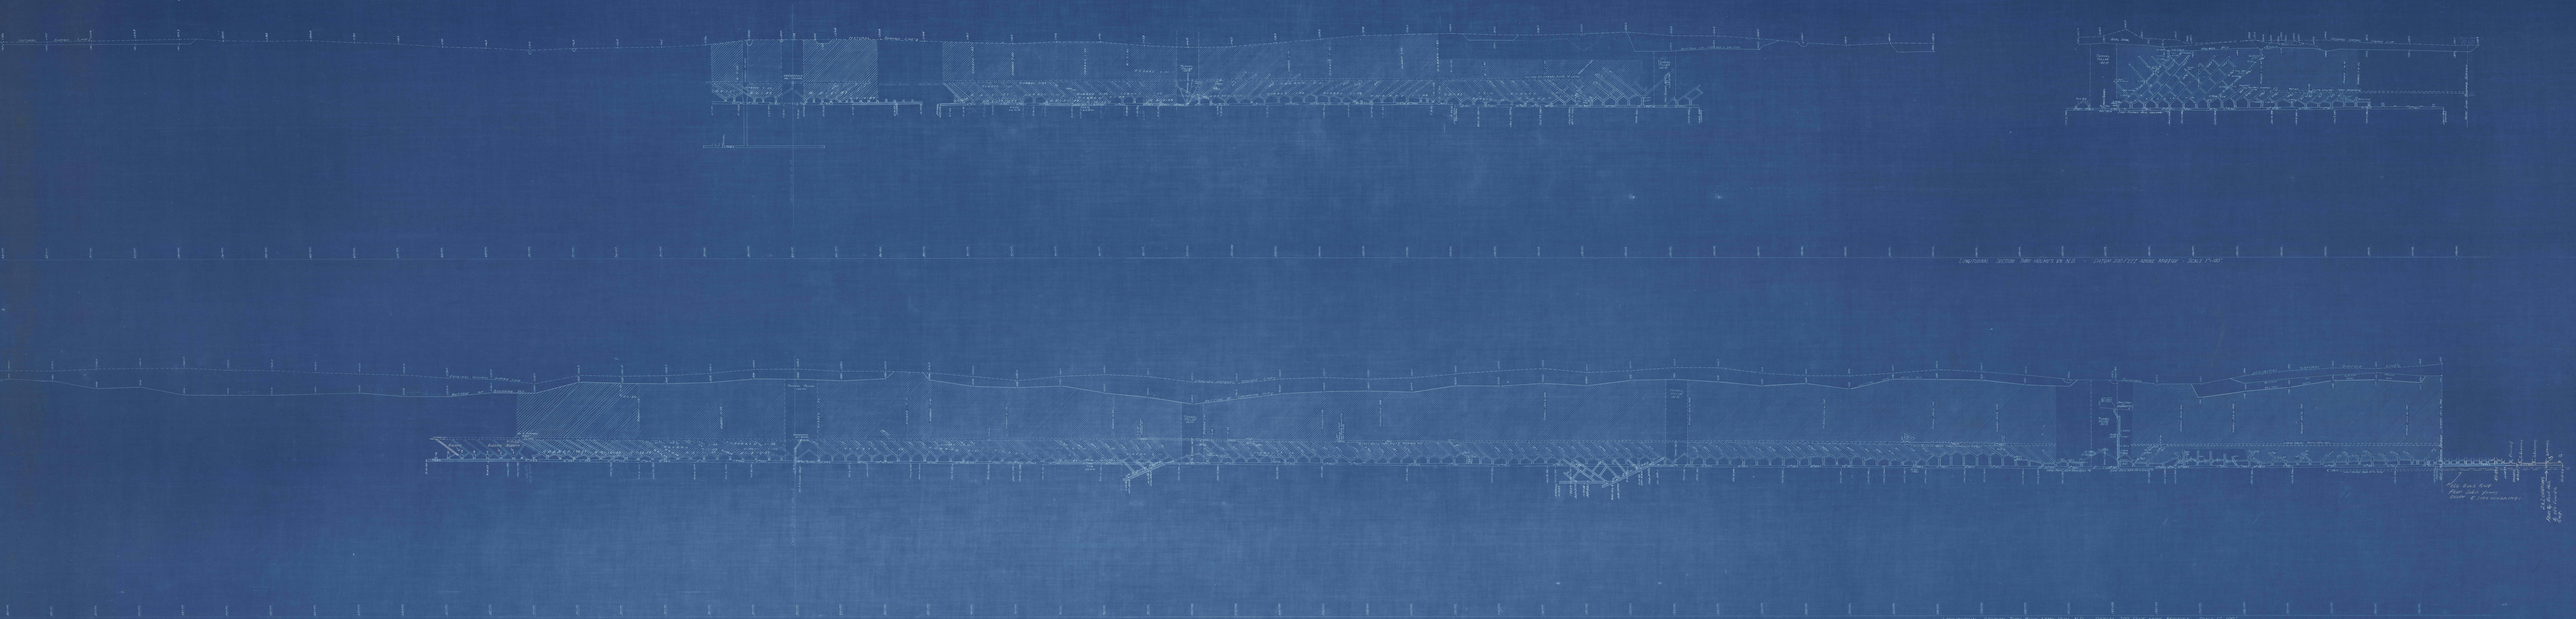

Southern Coal Field 1"=100'

New York Colliery Schuylkill Twp. / County, Pa.

Longitudinal Section Thru Holmes VeinN.D. Datum 200 Feet Above Mattide

Longitudinal Section Thru Buck Mtn. Vein N.D