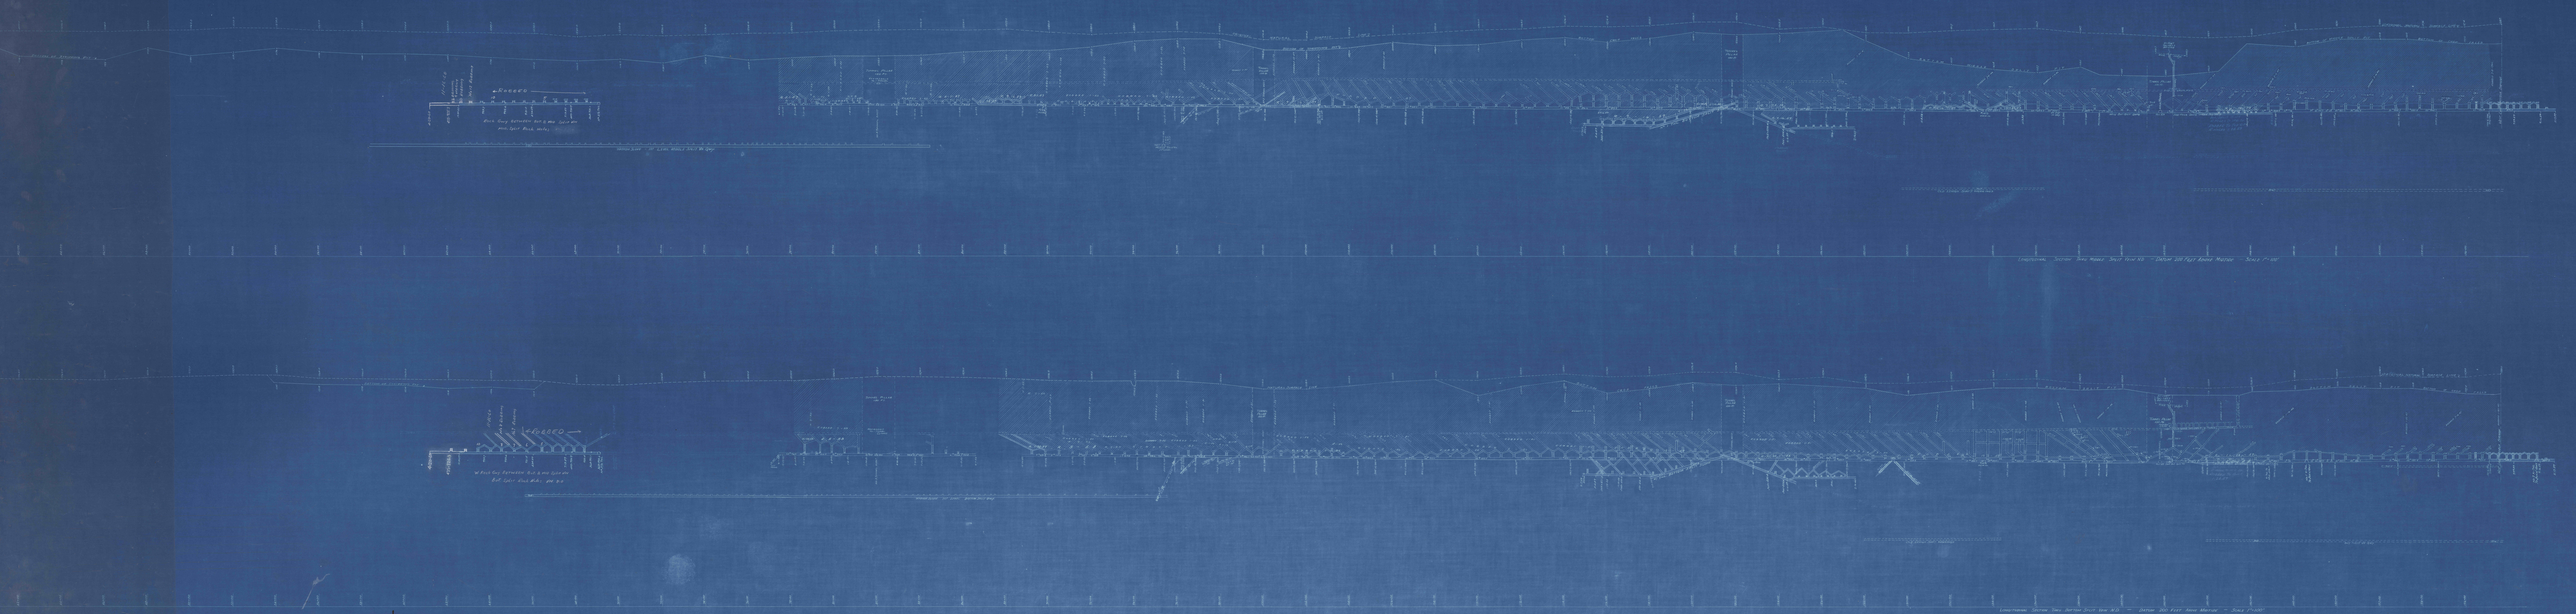


..SOUTHERN FIELD..NEWKIRK COLLIERY

∴LONGITUDINAL SECTIONS-1"=100'. BOTTOM-SPLIT VN.

NORTH-DIP, SCHUYLKILL Twp., County, Pa., READING ANTHRACITE COLLIERIES.