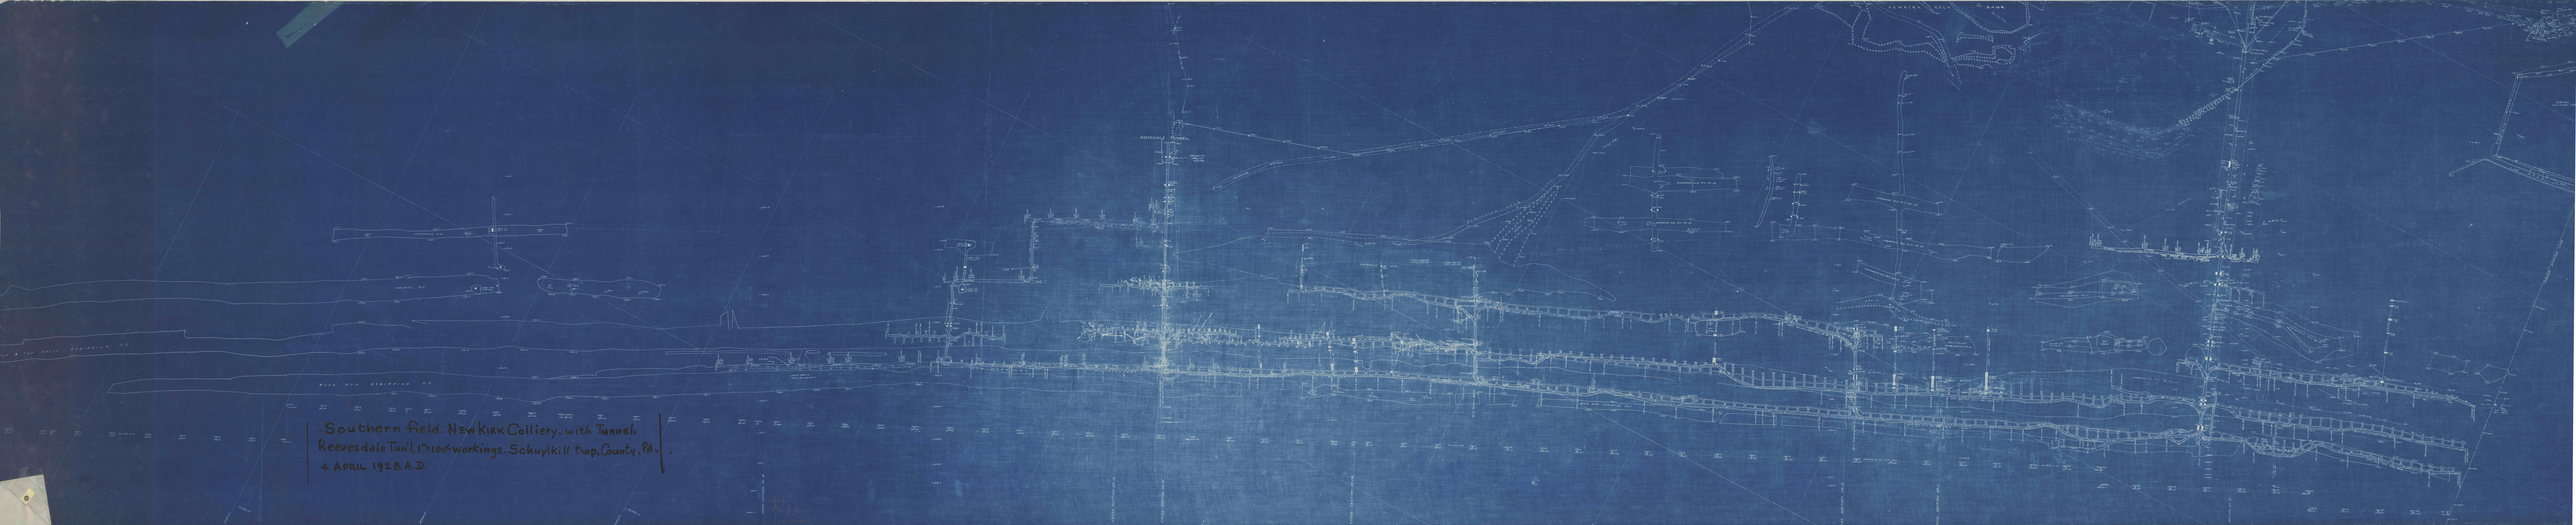


Southern field. New Kirk Colliery. with Tunnel.
Reevesdale Tun'l, 1"=100' workings. Schuylkill twp, County, Pa.
4 APRIL 1928. A.D.