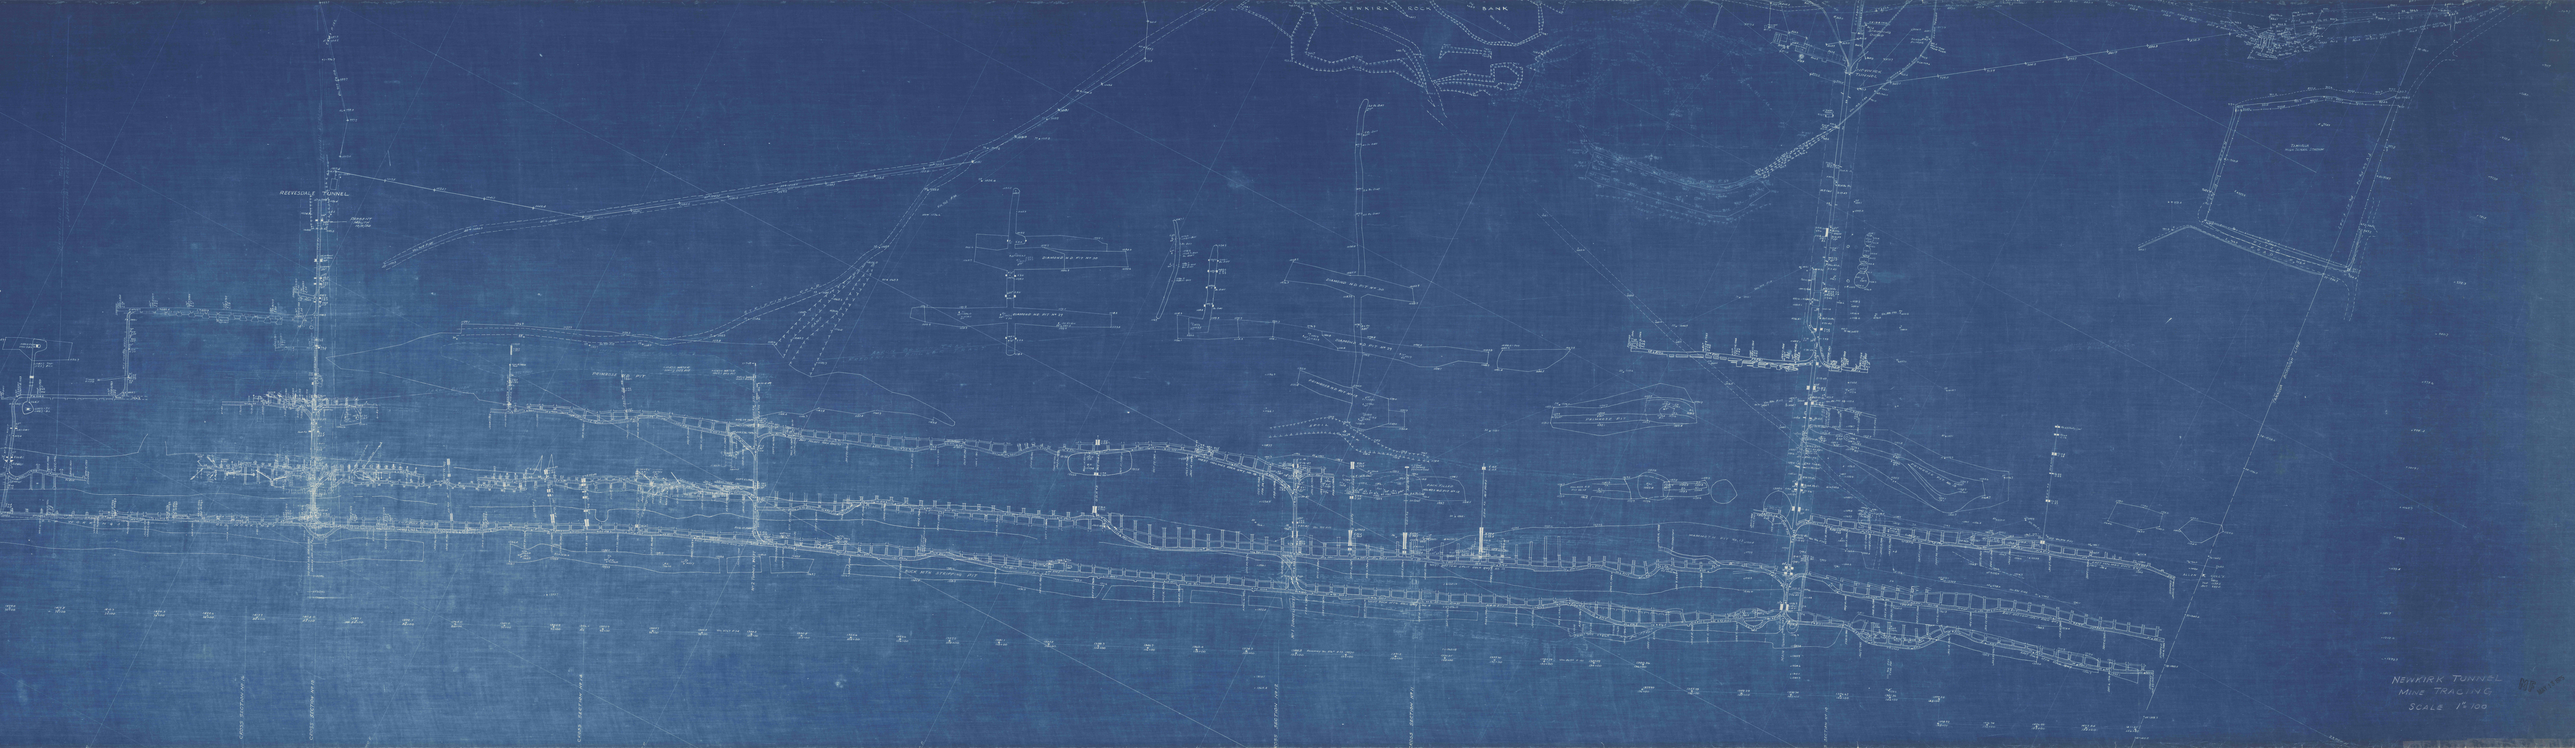
REEVESDALE TUNNEL
NEWKIRK TUNNEL
MINE TRACING
SCALE 1"=100