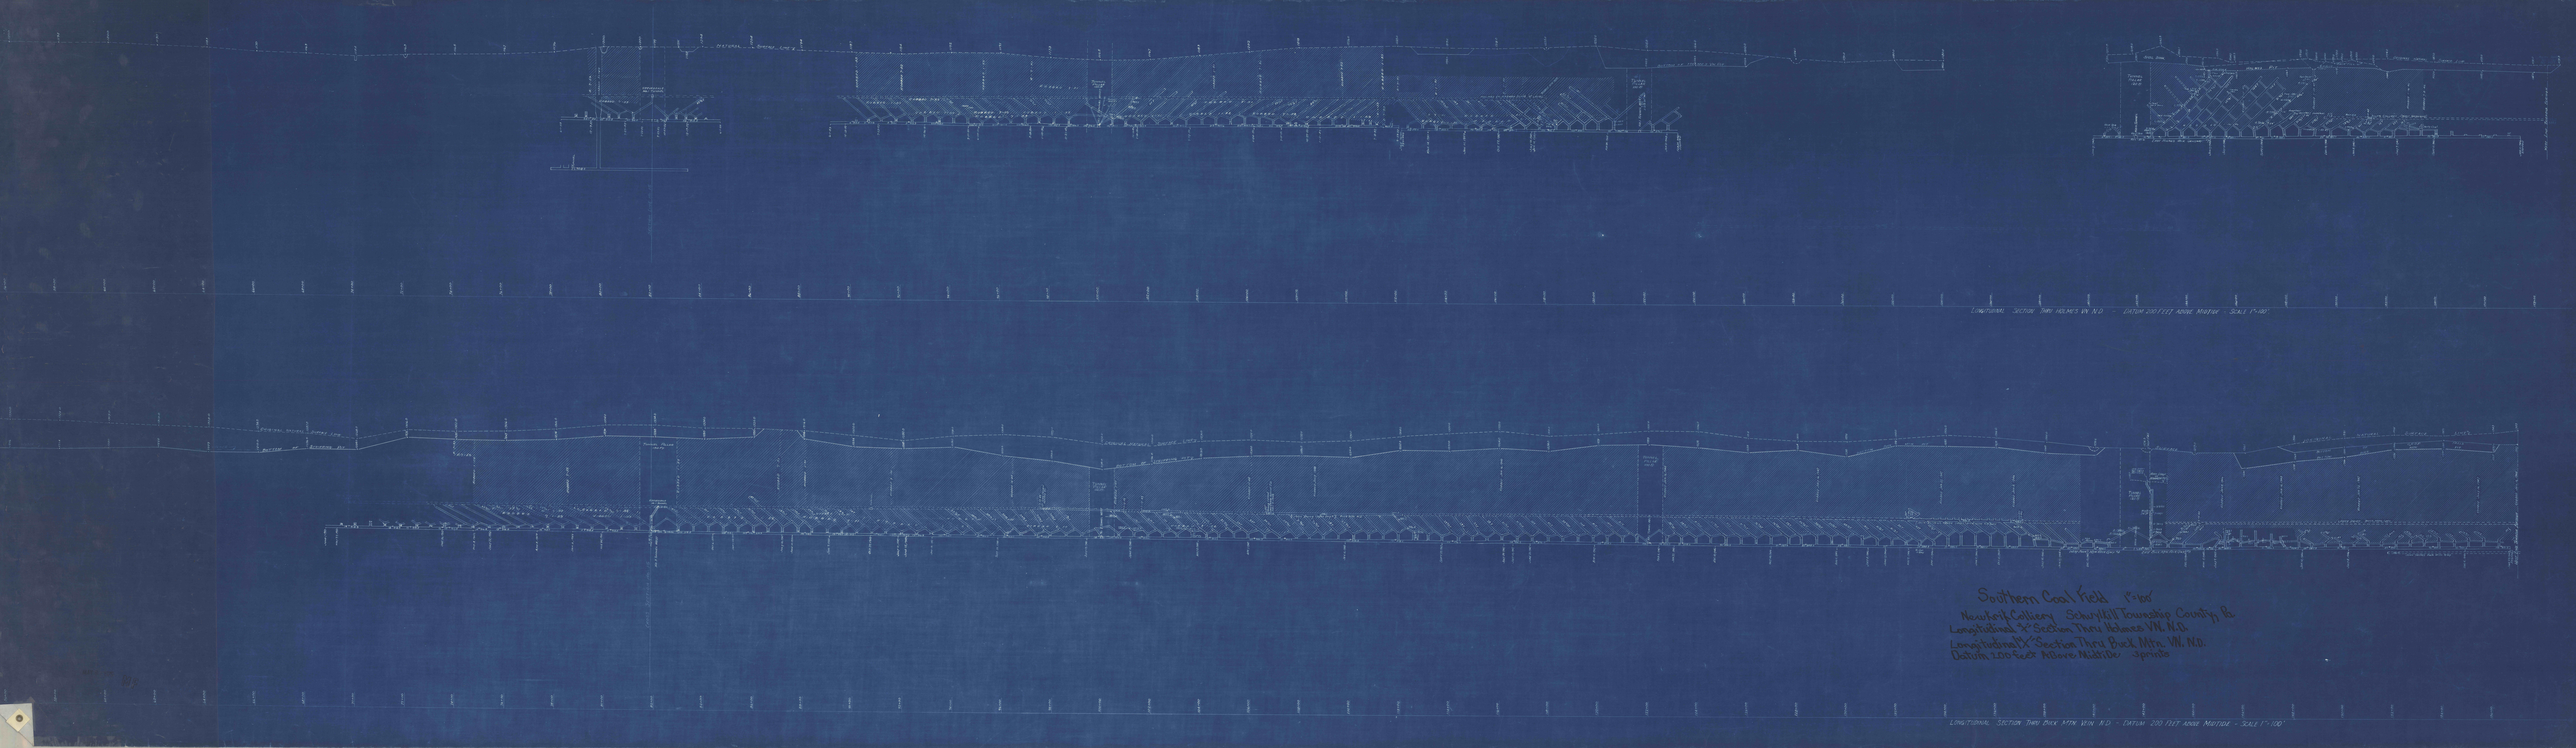
LONGITUDINAL SECTION THRU HOLMES VN. N.D. - DATUM 200 FEET ABOVE MIDTOP - SCALE 1"=100'
Southern Coal Field 1"=100'
Longitudinal X Section Thru Holmes VN. N.D.
Longitudinal X Section Thru Buck Mtn. VN. N.D.
LONGITUDINAL SECTION THRU BUCK MTN. VEIN N.D. - DATUM 200 FEET ABOVE MIDTOP - SCALE 1"=100'