


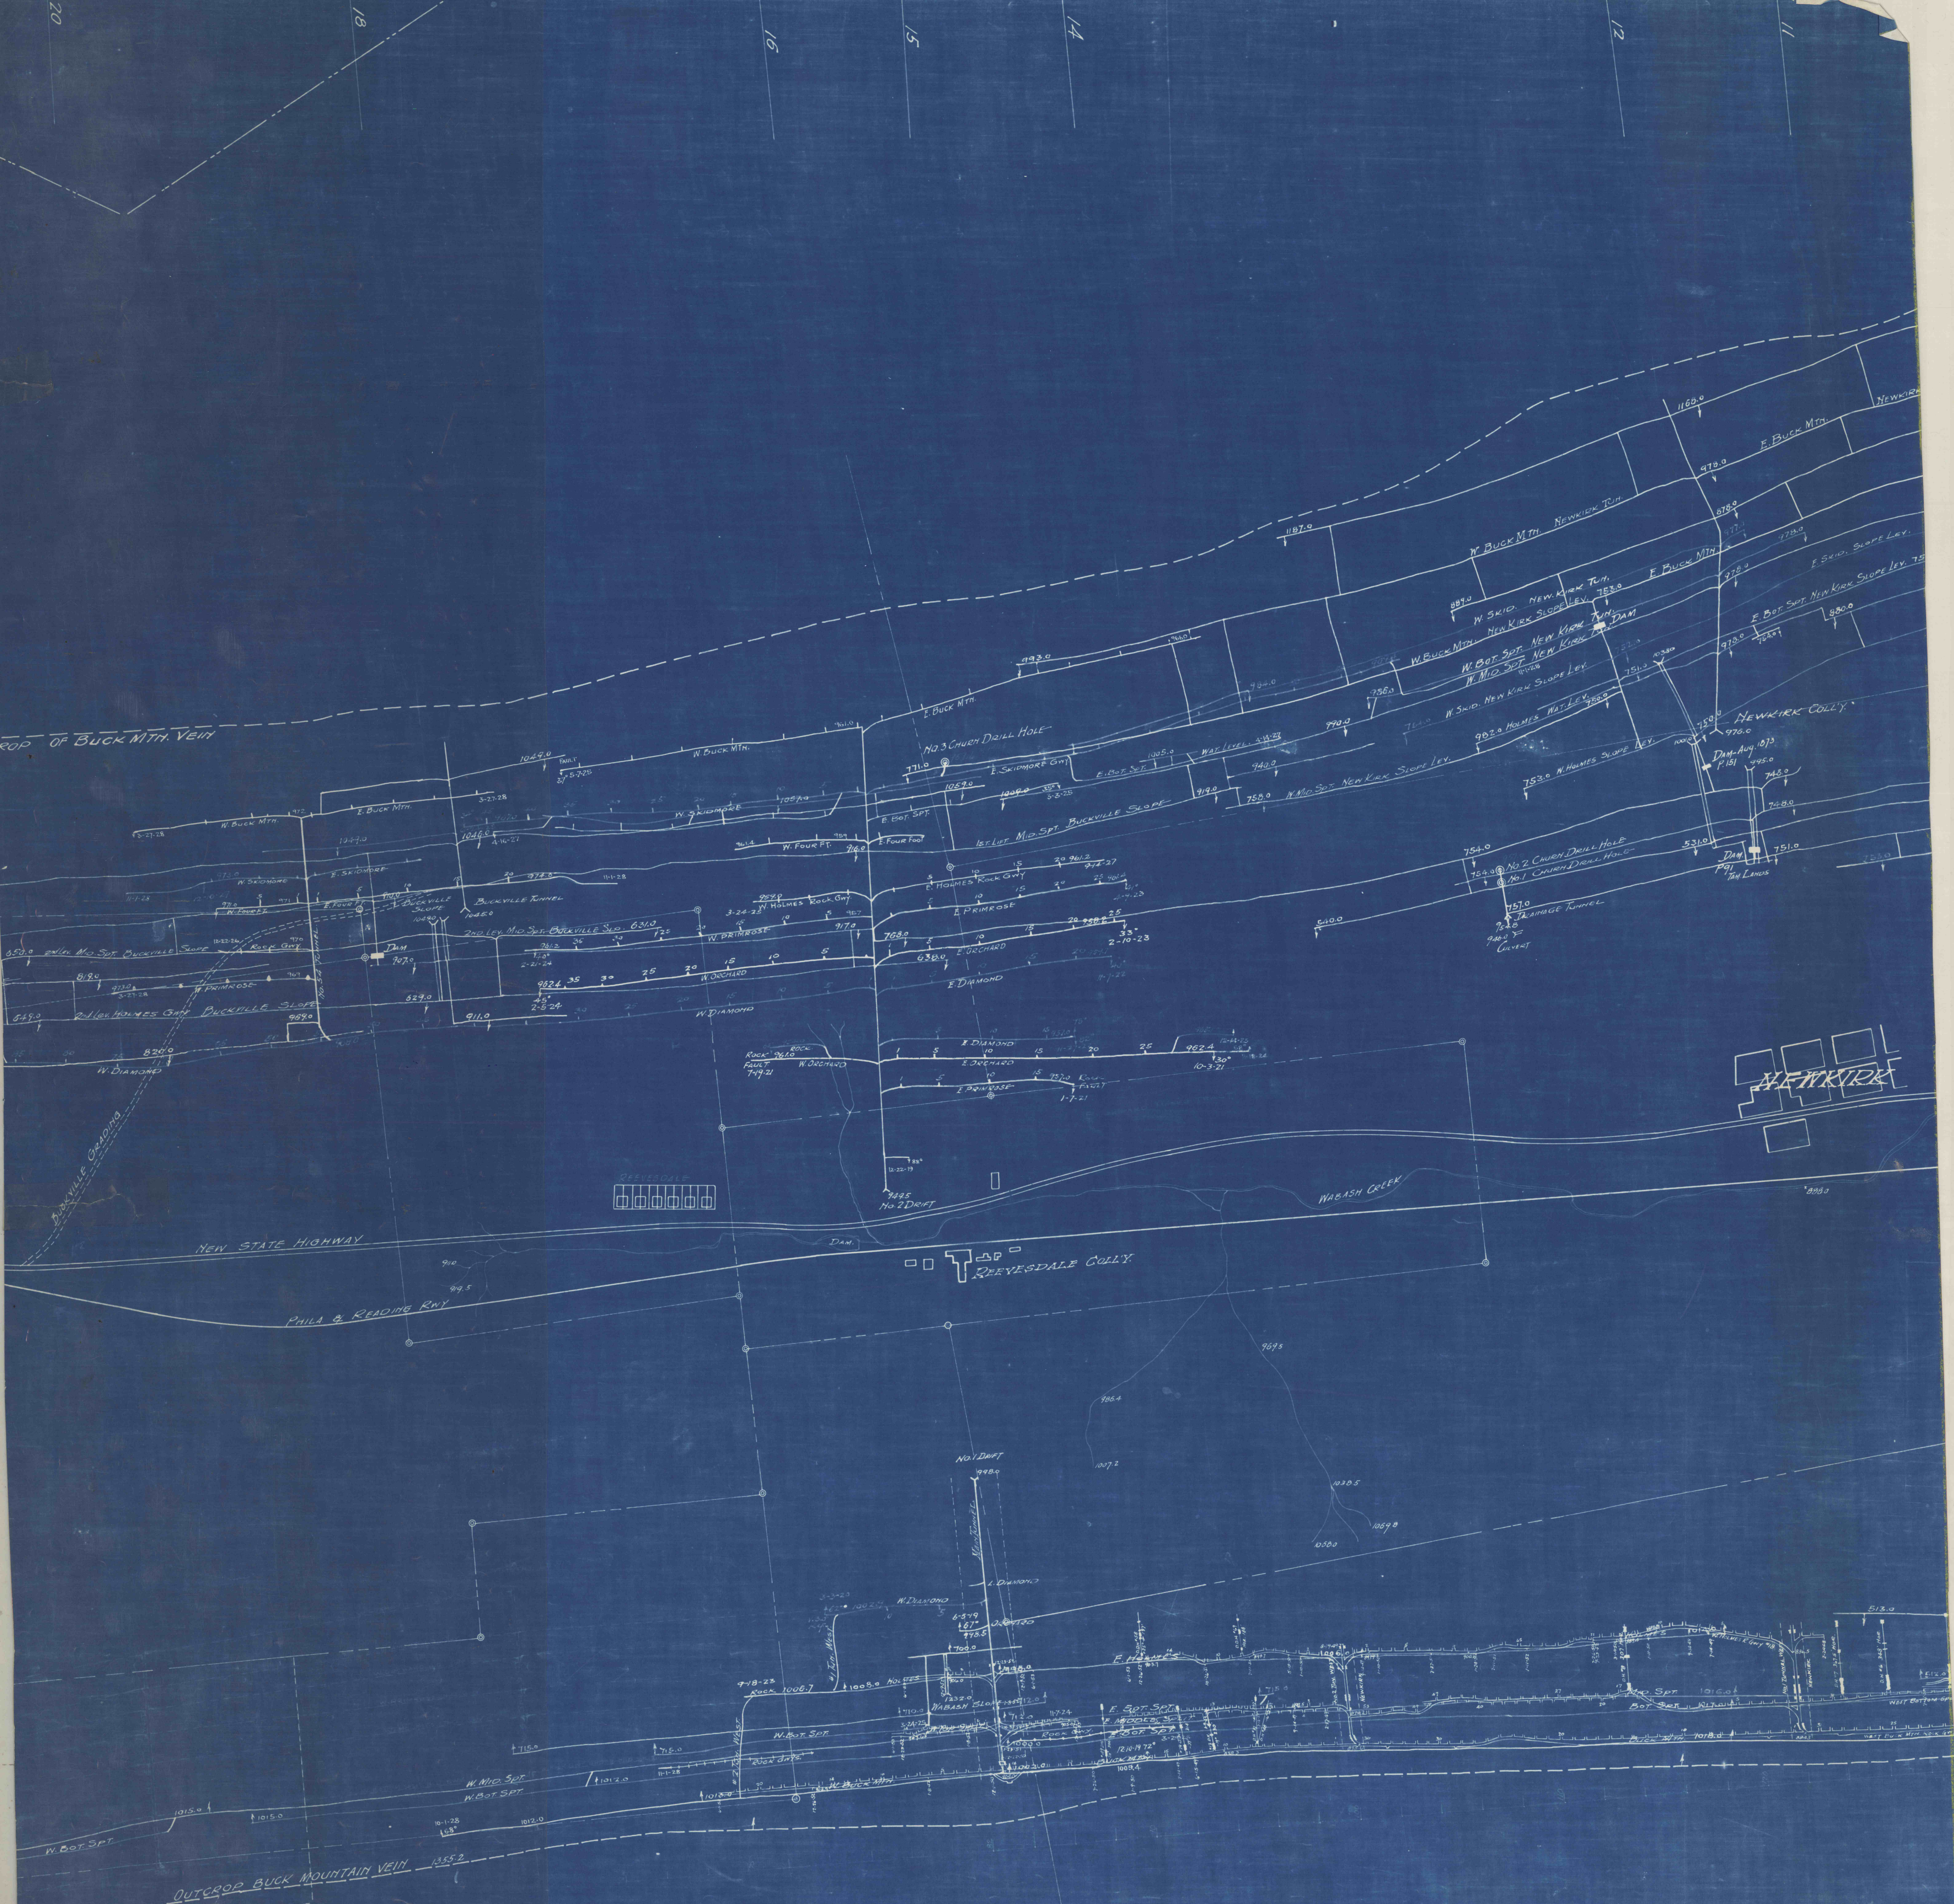

NEW KIRK

SOUTHERN Field:
NEW KIRK Colliery-1400'-
TAMAQUA LANDS-New School Site)
SCHUYLKILL TWP, COUNTY, PA.