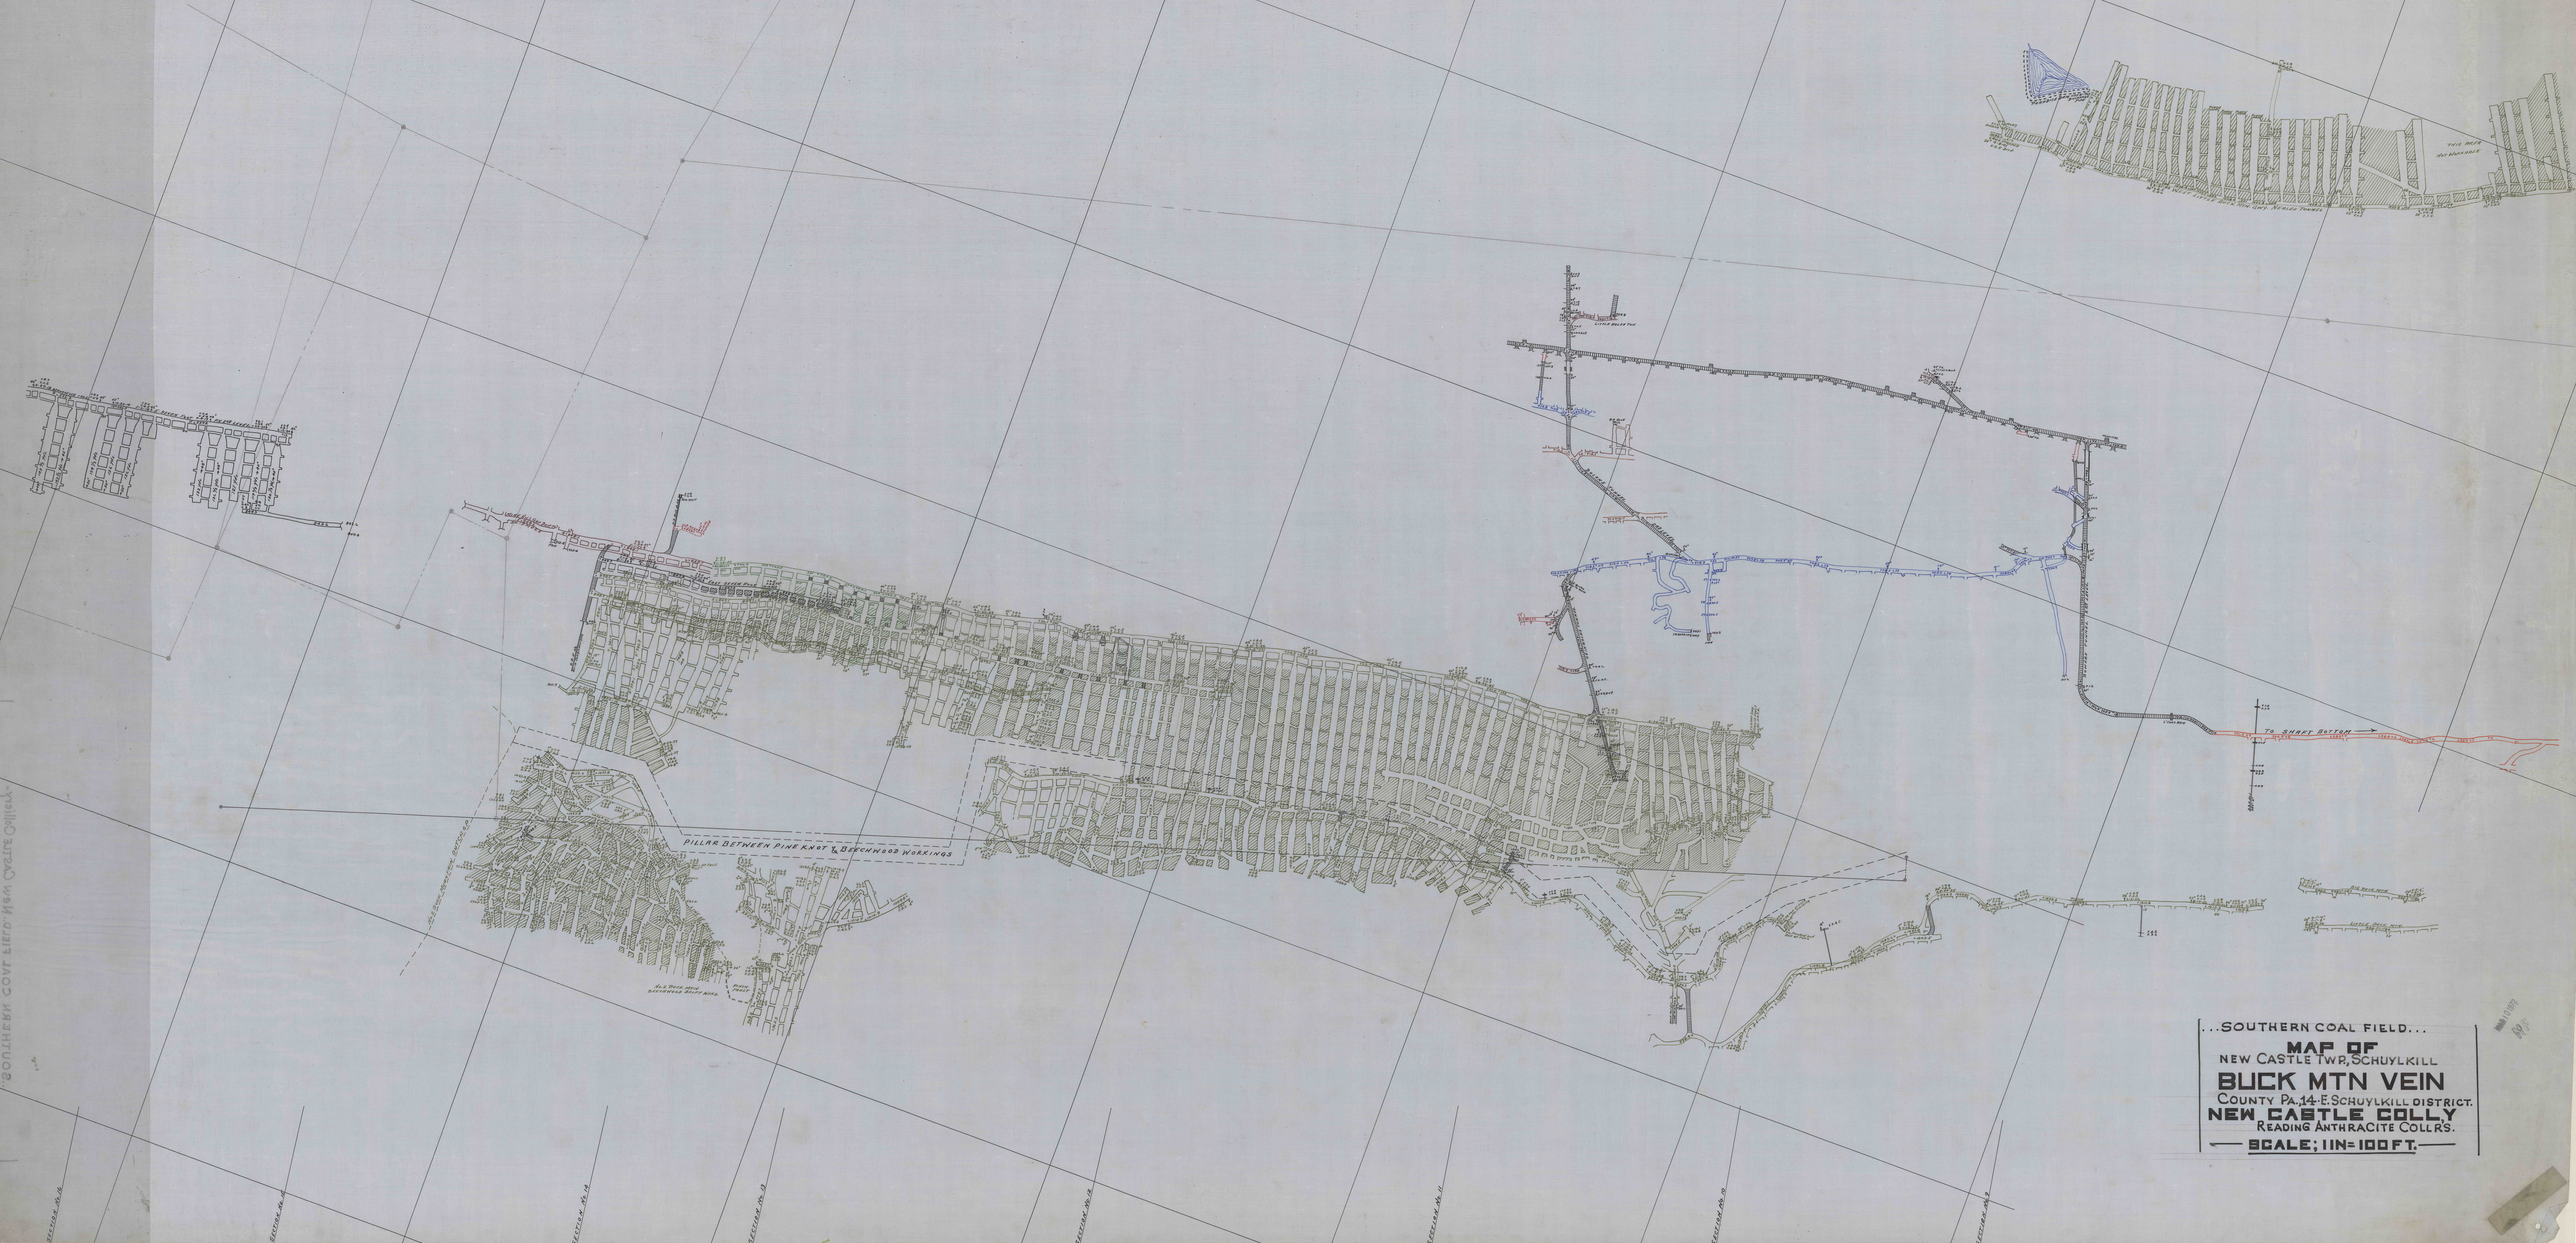

...SOUTHERN COAL FIELD...

MAP OF
NEW CASTLE TWP, SCHUYLKILL

BUCK MTN VEIN
COUNTY PA. 14-E. SCHUYLKILL DISTRICT.

NEW CASTLE COLLY
READING ANTHRACITE COLL'RS.

SCALE; 1 IN = 100 FT.

SOUTHERN COAL FIELD. MAP OF NEW CASTLE TWP. SCHUYLKILL COUNTY.