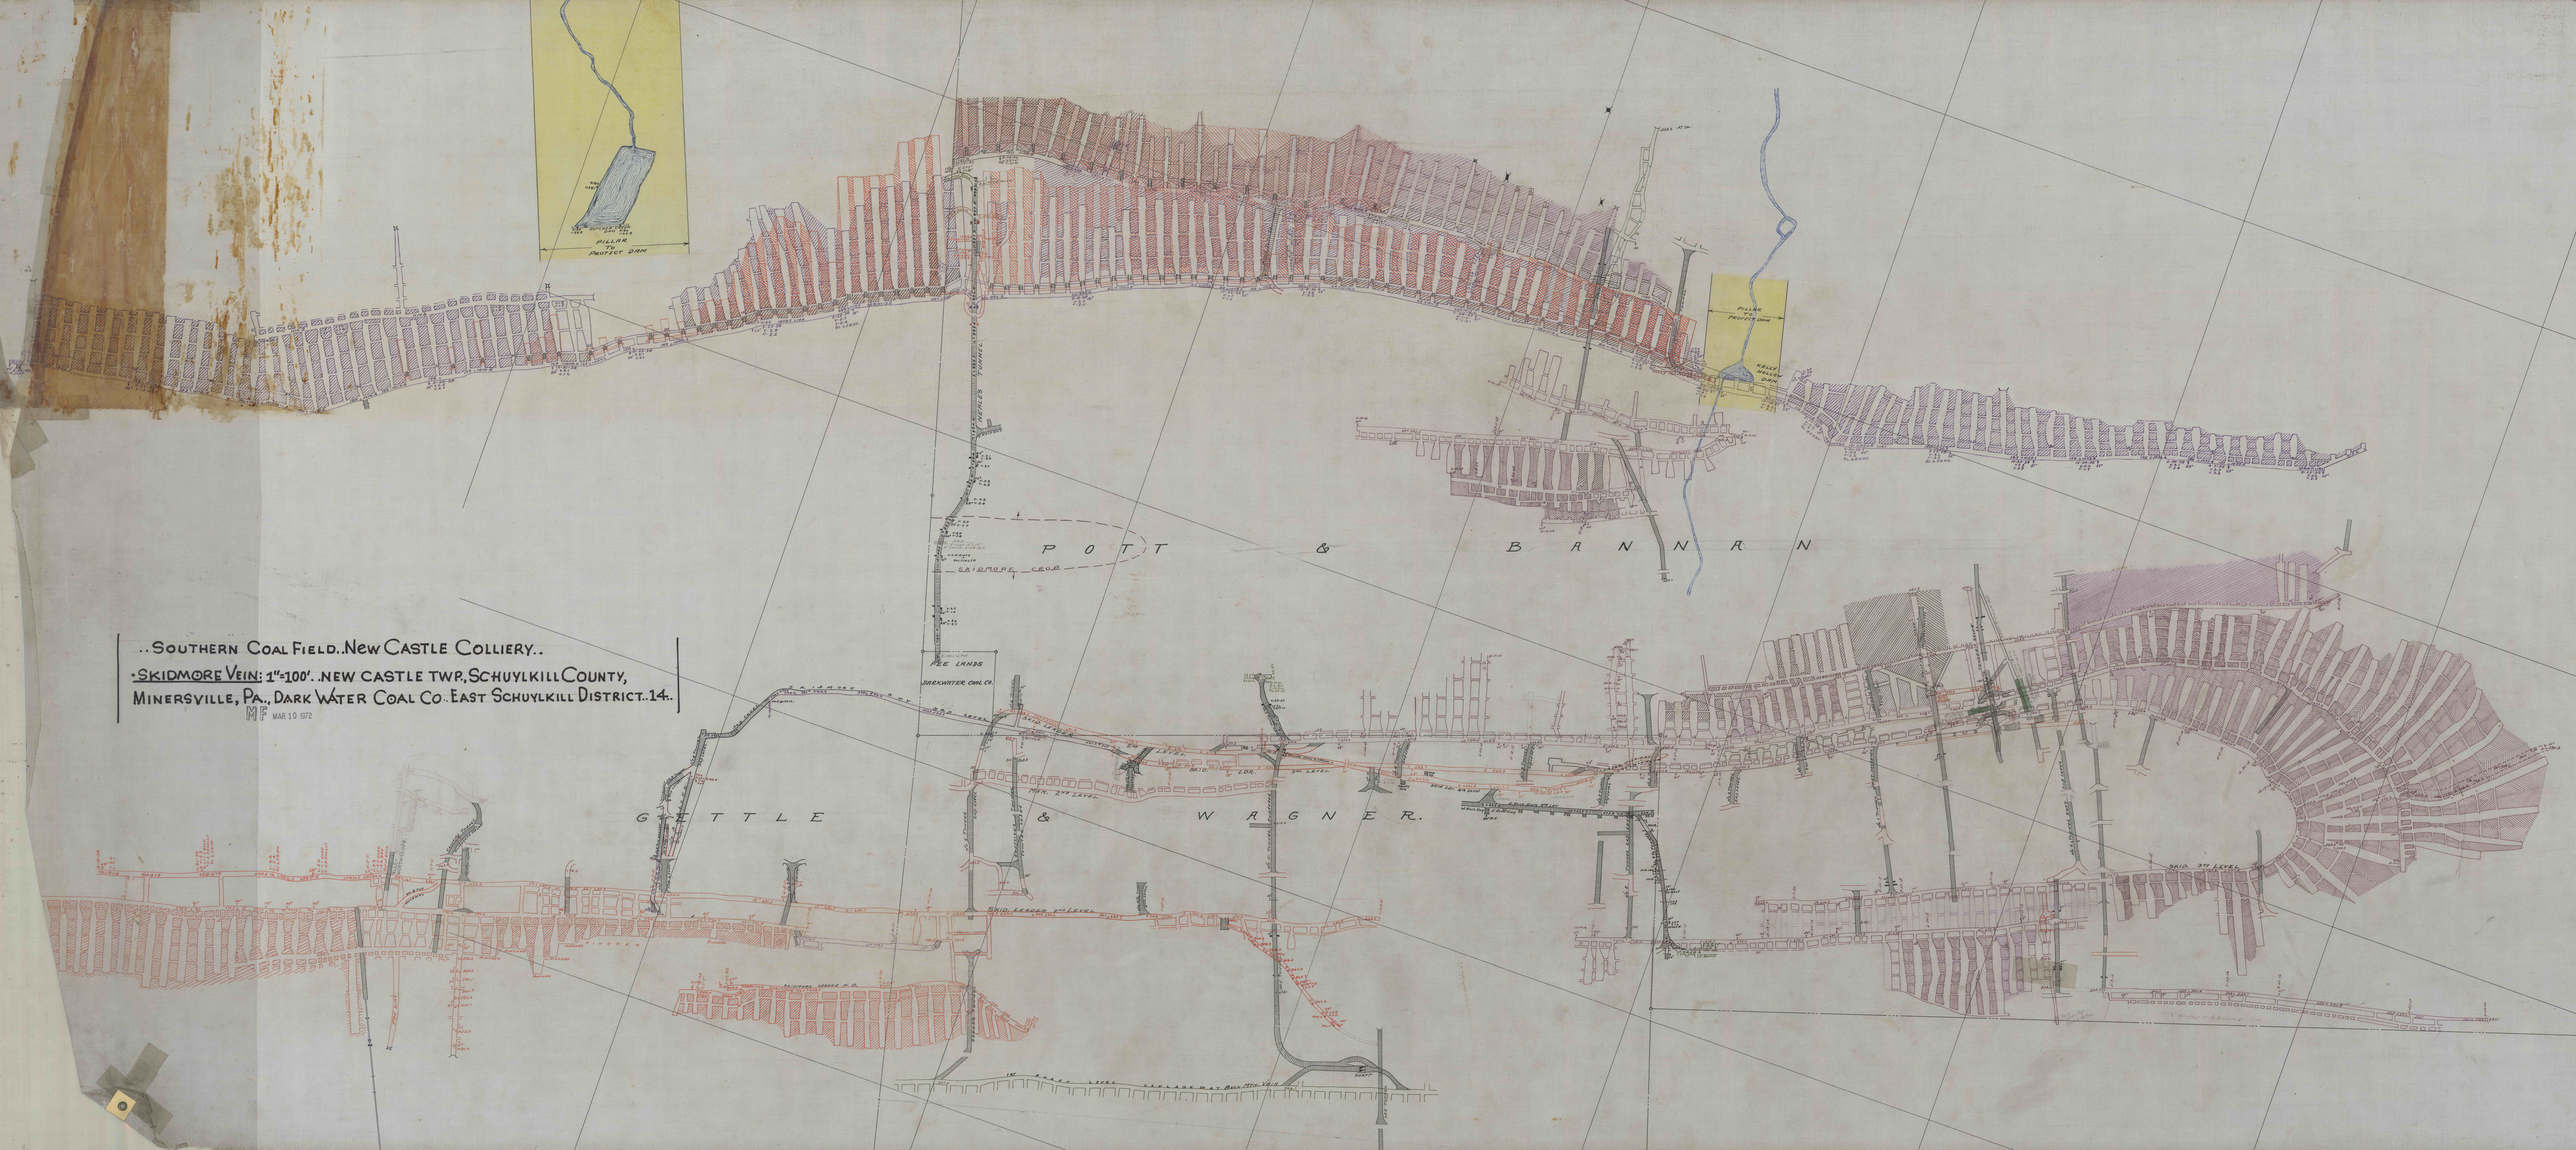

..SOUTHERN COAL FIELD..NEW CASTLE COLLIERY..

·SKIDMORE VEIN: 1"=100'. .NEW CASTLE TWP, SCHUYLKILL COUNTY, MINERSVILLE, PA., DARK WATER COAL CO. EAST SCHUYLKILL DISTRICT. 14..

MP MAR 10 1972