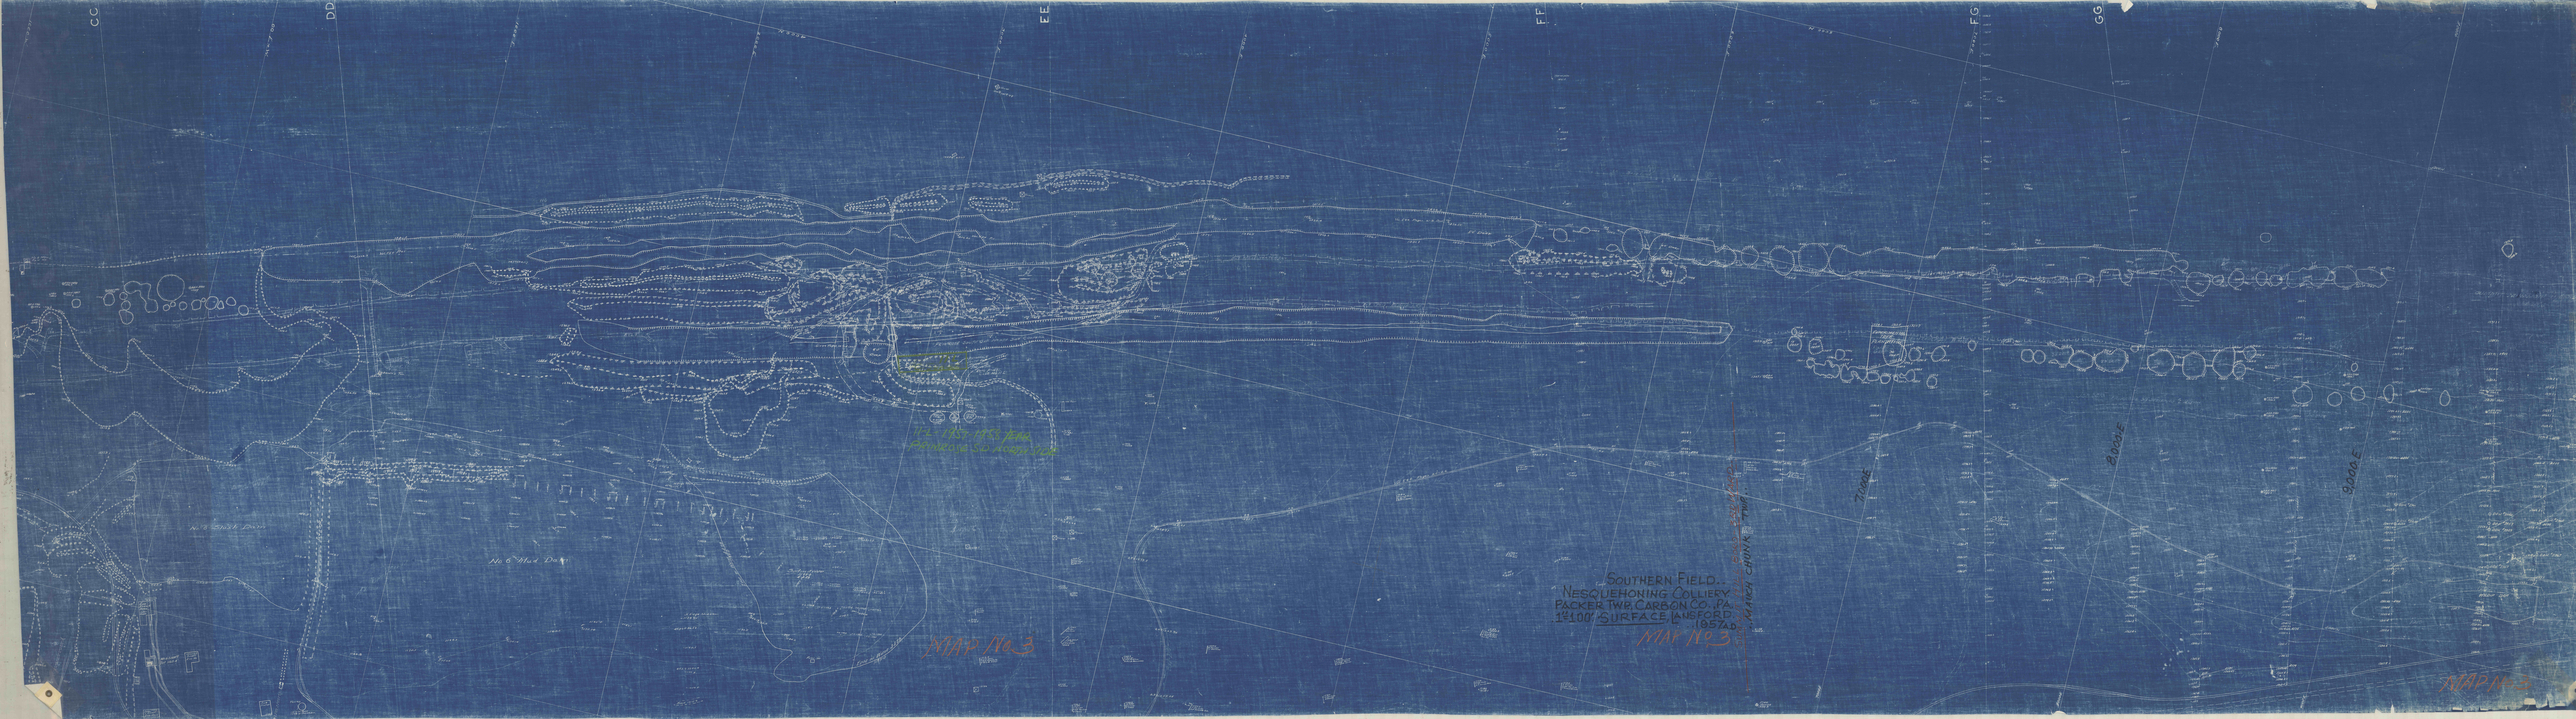

SOUTHERN FIELD..
NESQUEHONING COLLIERY.
PACKER TWP., CARBON CO., PA.
.1"=100'. ·SURFACE, LANSFORD.
..1957.A.D

MAP No. 3

11-L-1957-1958 YEAR
PRIMROSE SD NORTH SIDE

CC
DD
EE
FF
FG
GG
No. 6 Mud Dam.
No. 7 Cut
No. 2 Cut
SUMMIT HILL BORO.
.MAUCH CHUNK
7,000E
8,000.E
9000.E
FIRE TOWER
MAP No. 3
MAP No. 3