


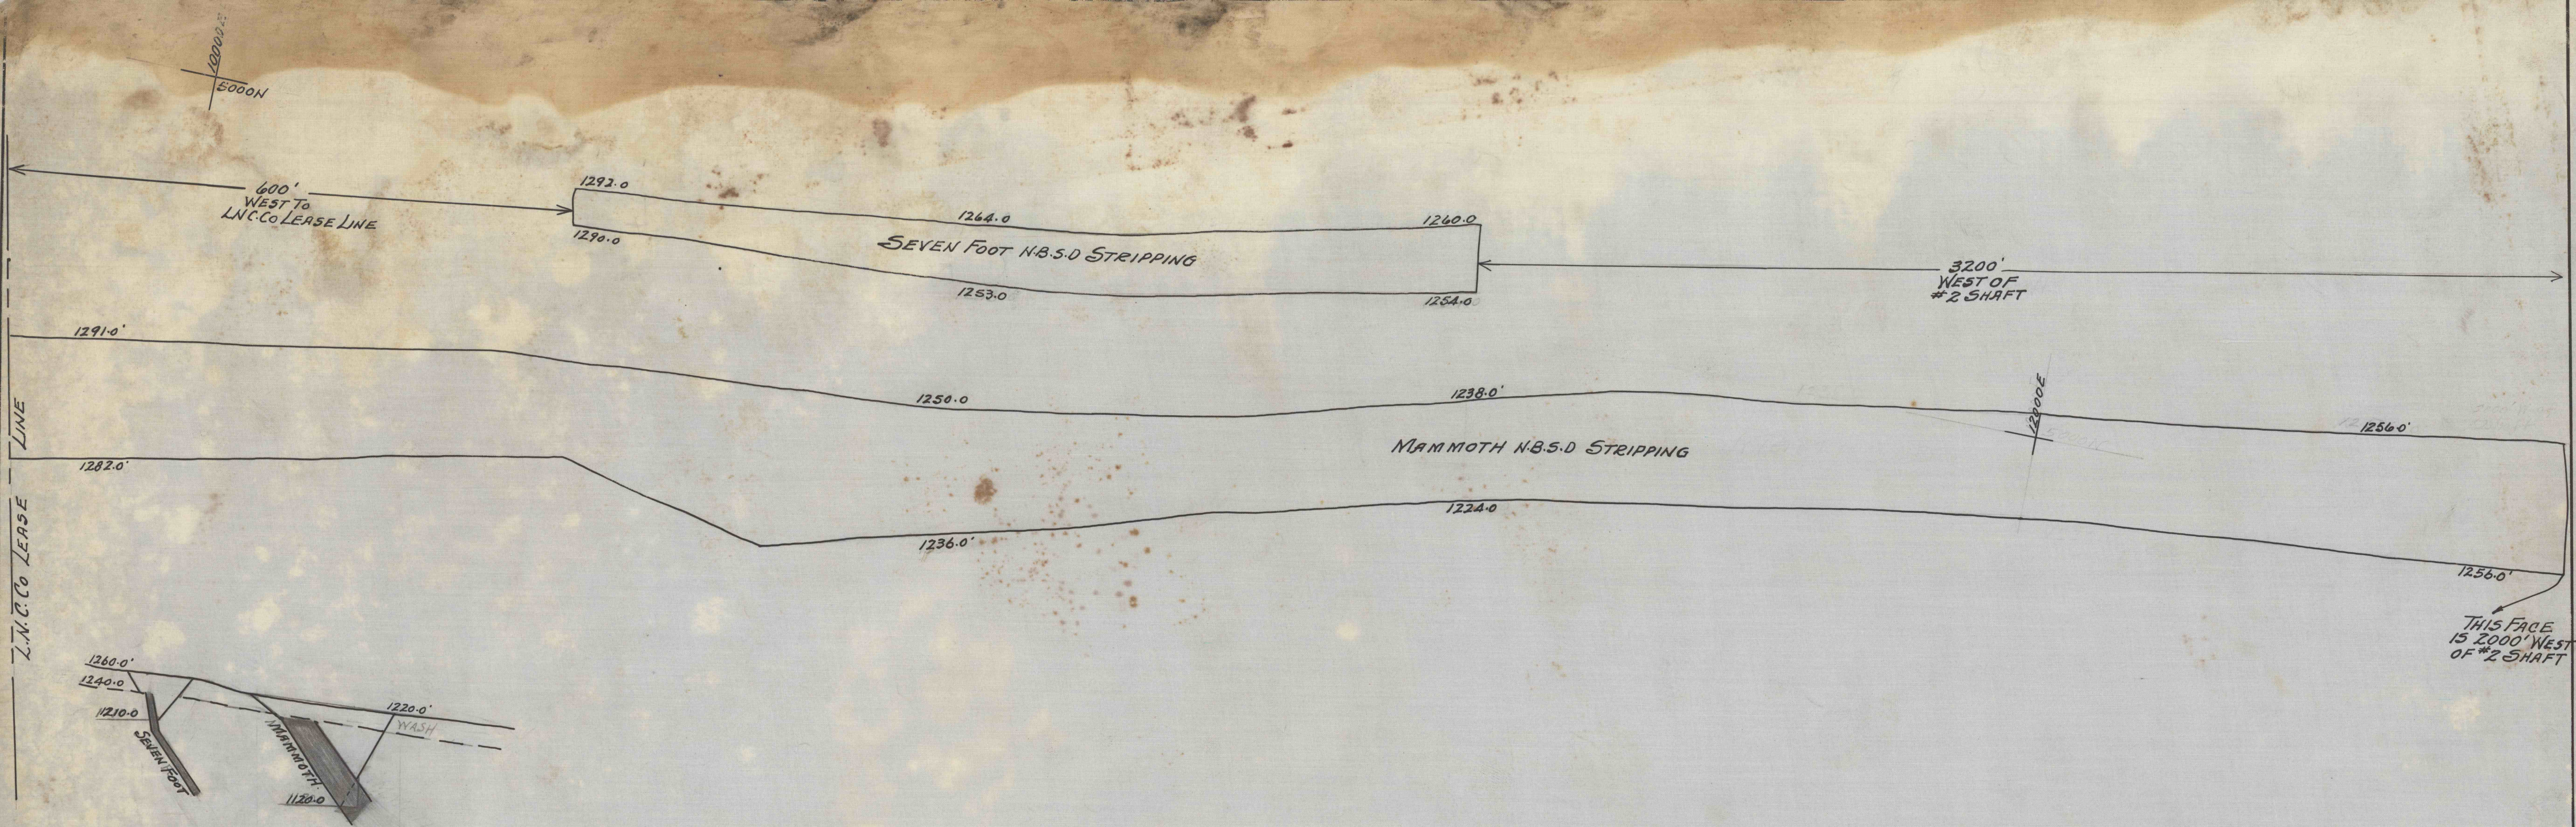

TYPICAL SECTION