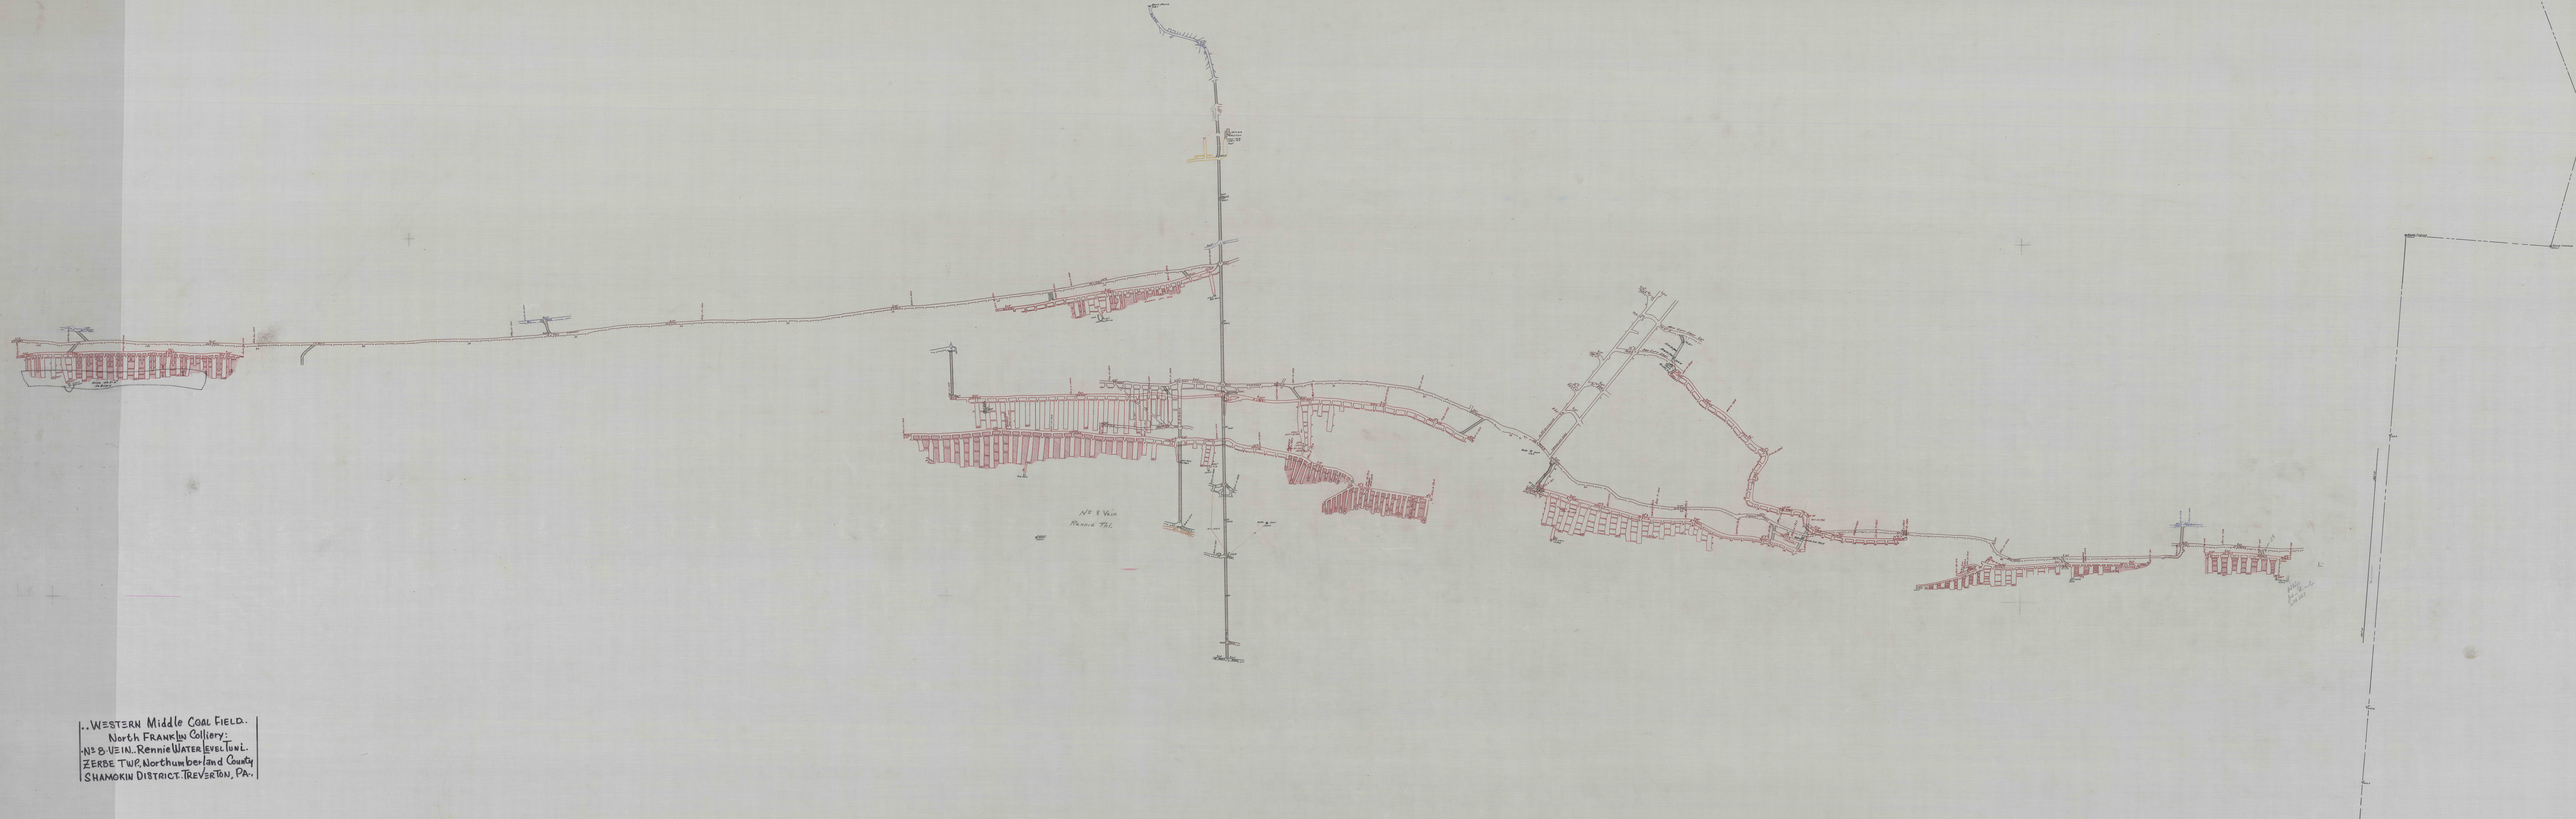

1. WESTERN Middle Coal Field.
North FRANKLIN Colliery:
No 8 VEIN. Rennie WATER LEVEL TUNL.
ZERBE TWP. Northumberland County
SHAMOKIN DISTRICT. TREVERTON, PA.