


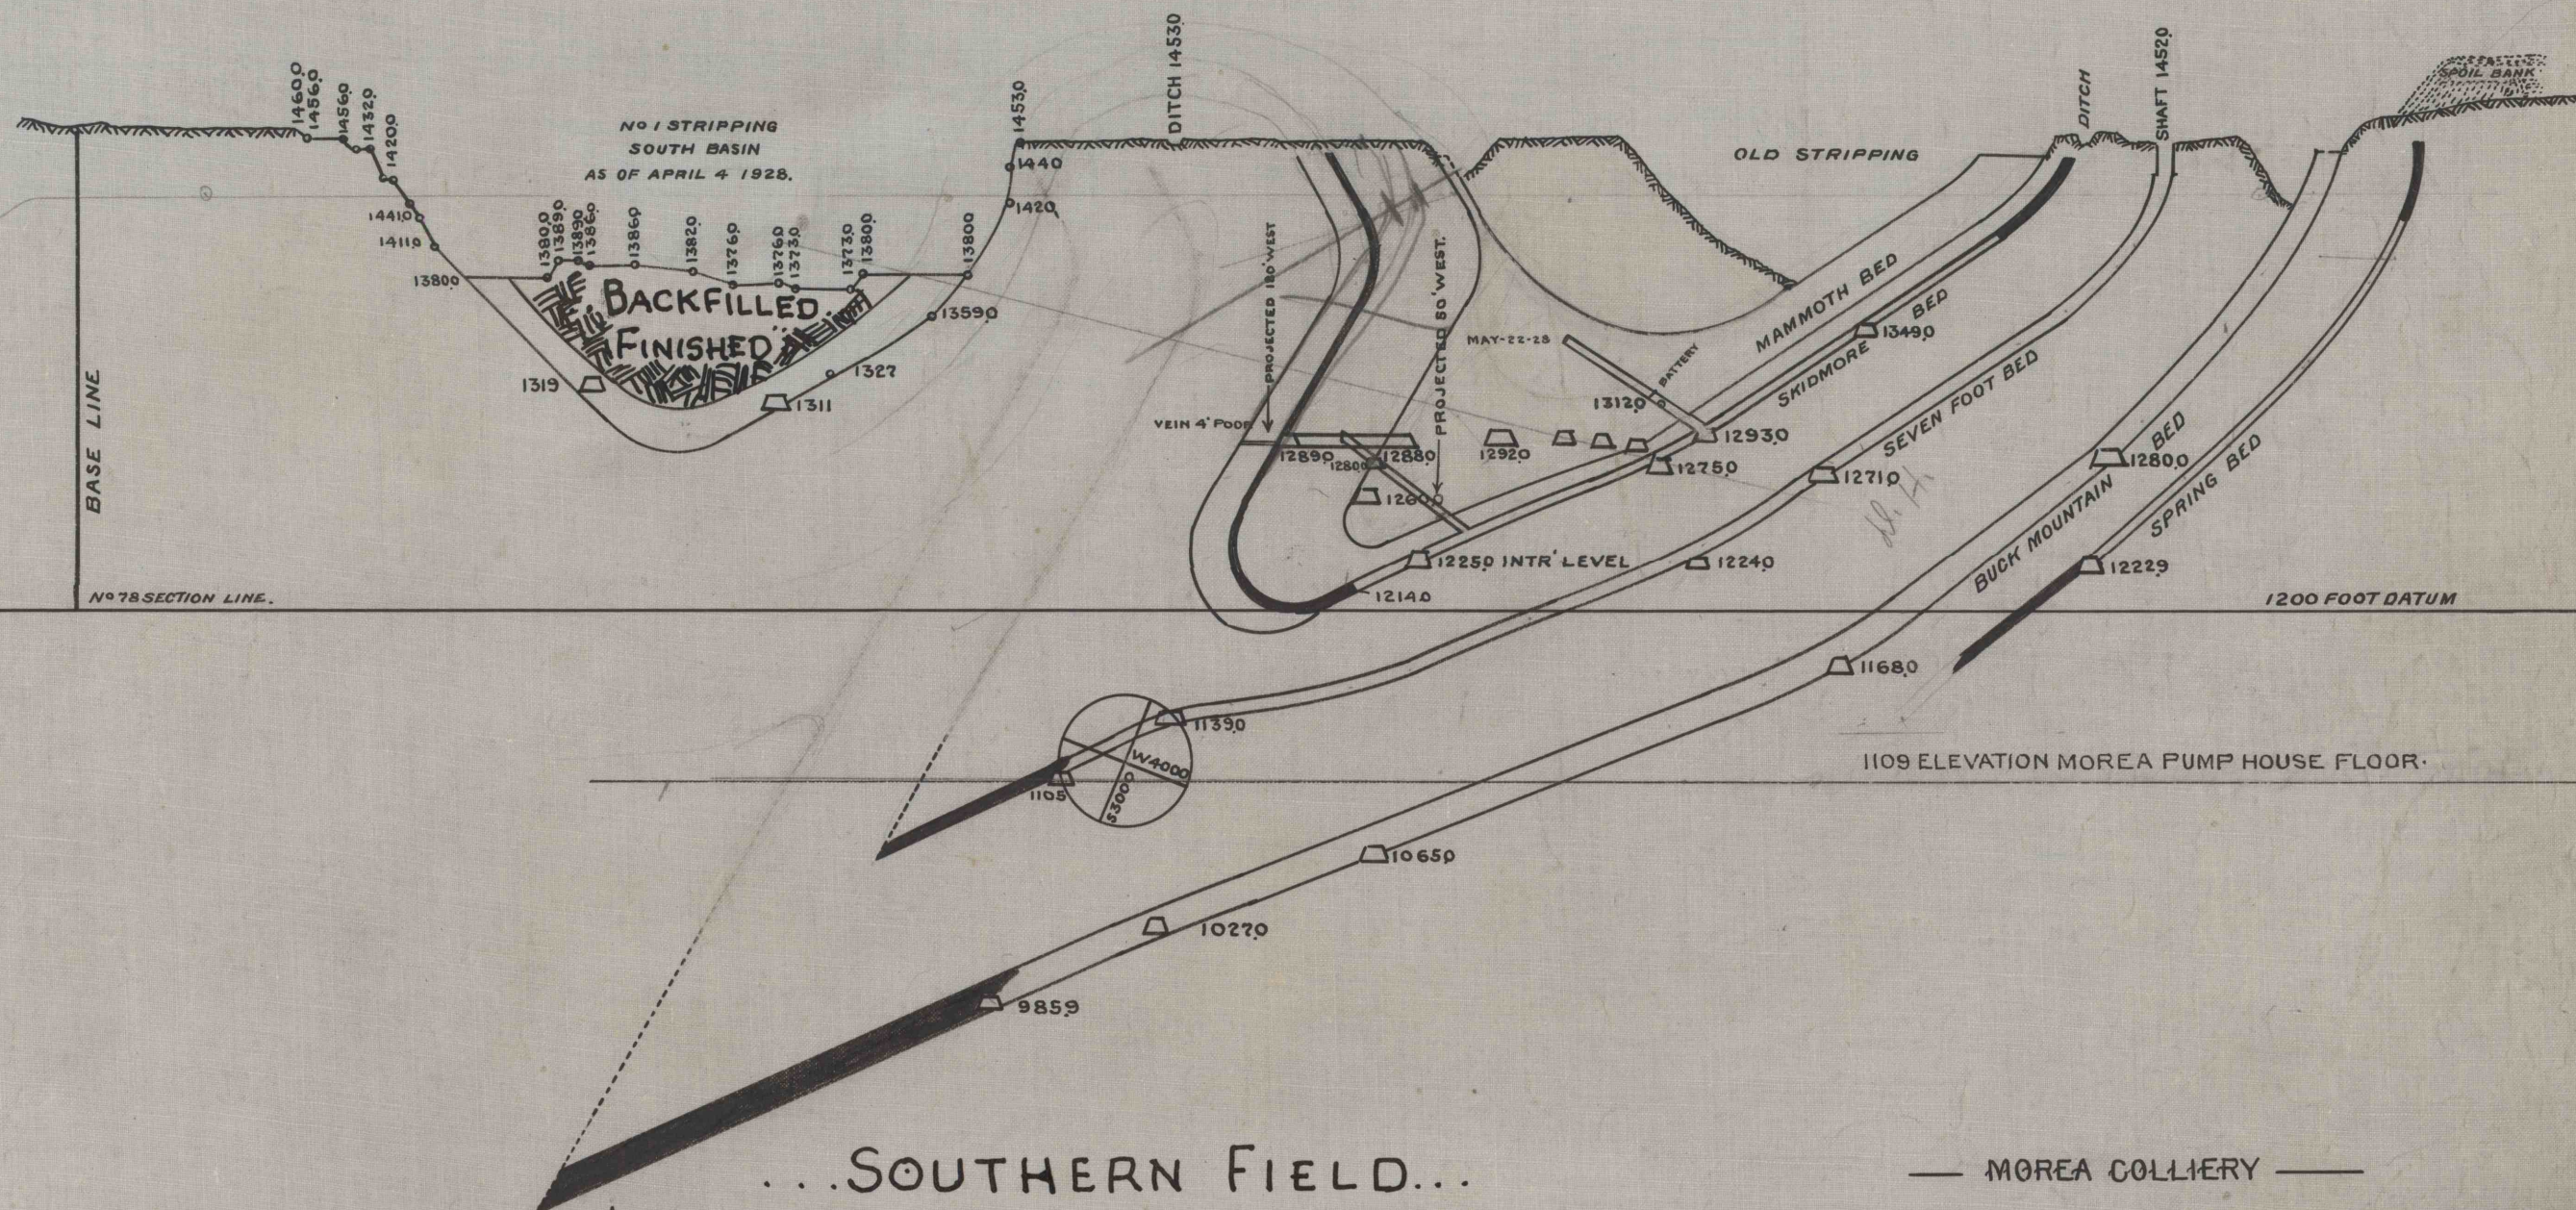

...SOUTHERN FIELD...
 Mahanoy Twp., Schuylkill County, PA.,
 14 E. Schuylkill District.
 DODSON COAL CO., MADEIRA HILL COAL CO.,

— MOREA COLLIERY —
 — N° 8 A —
 Through N° 78 Section Line, N° 1 Stripping
 Also through N° 37 Breast in the First West Buck Mountain S.D.
 — Scale 100 feet per Inch. —
 May-18-1928.