


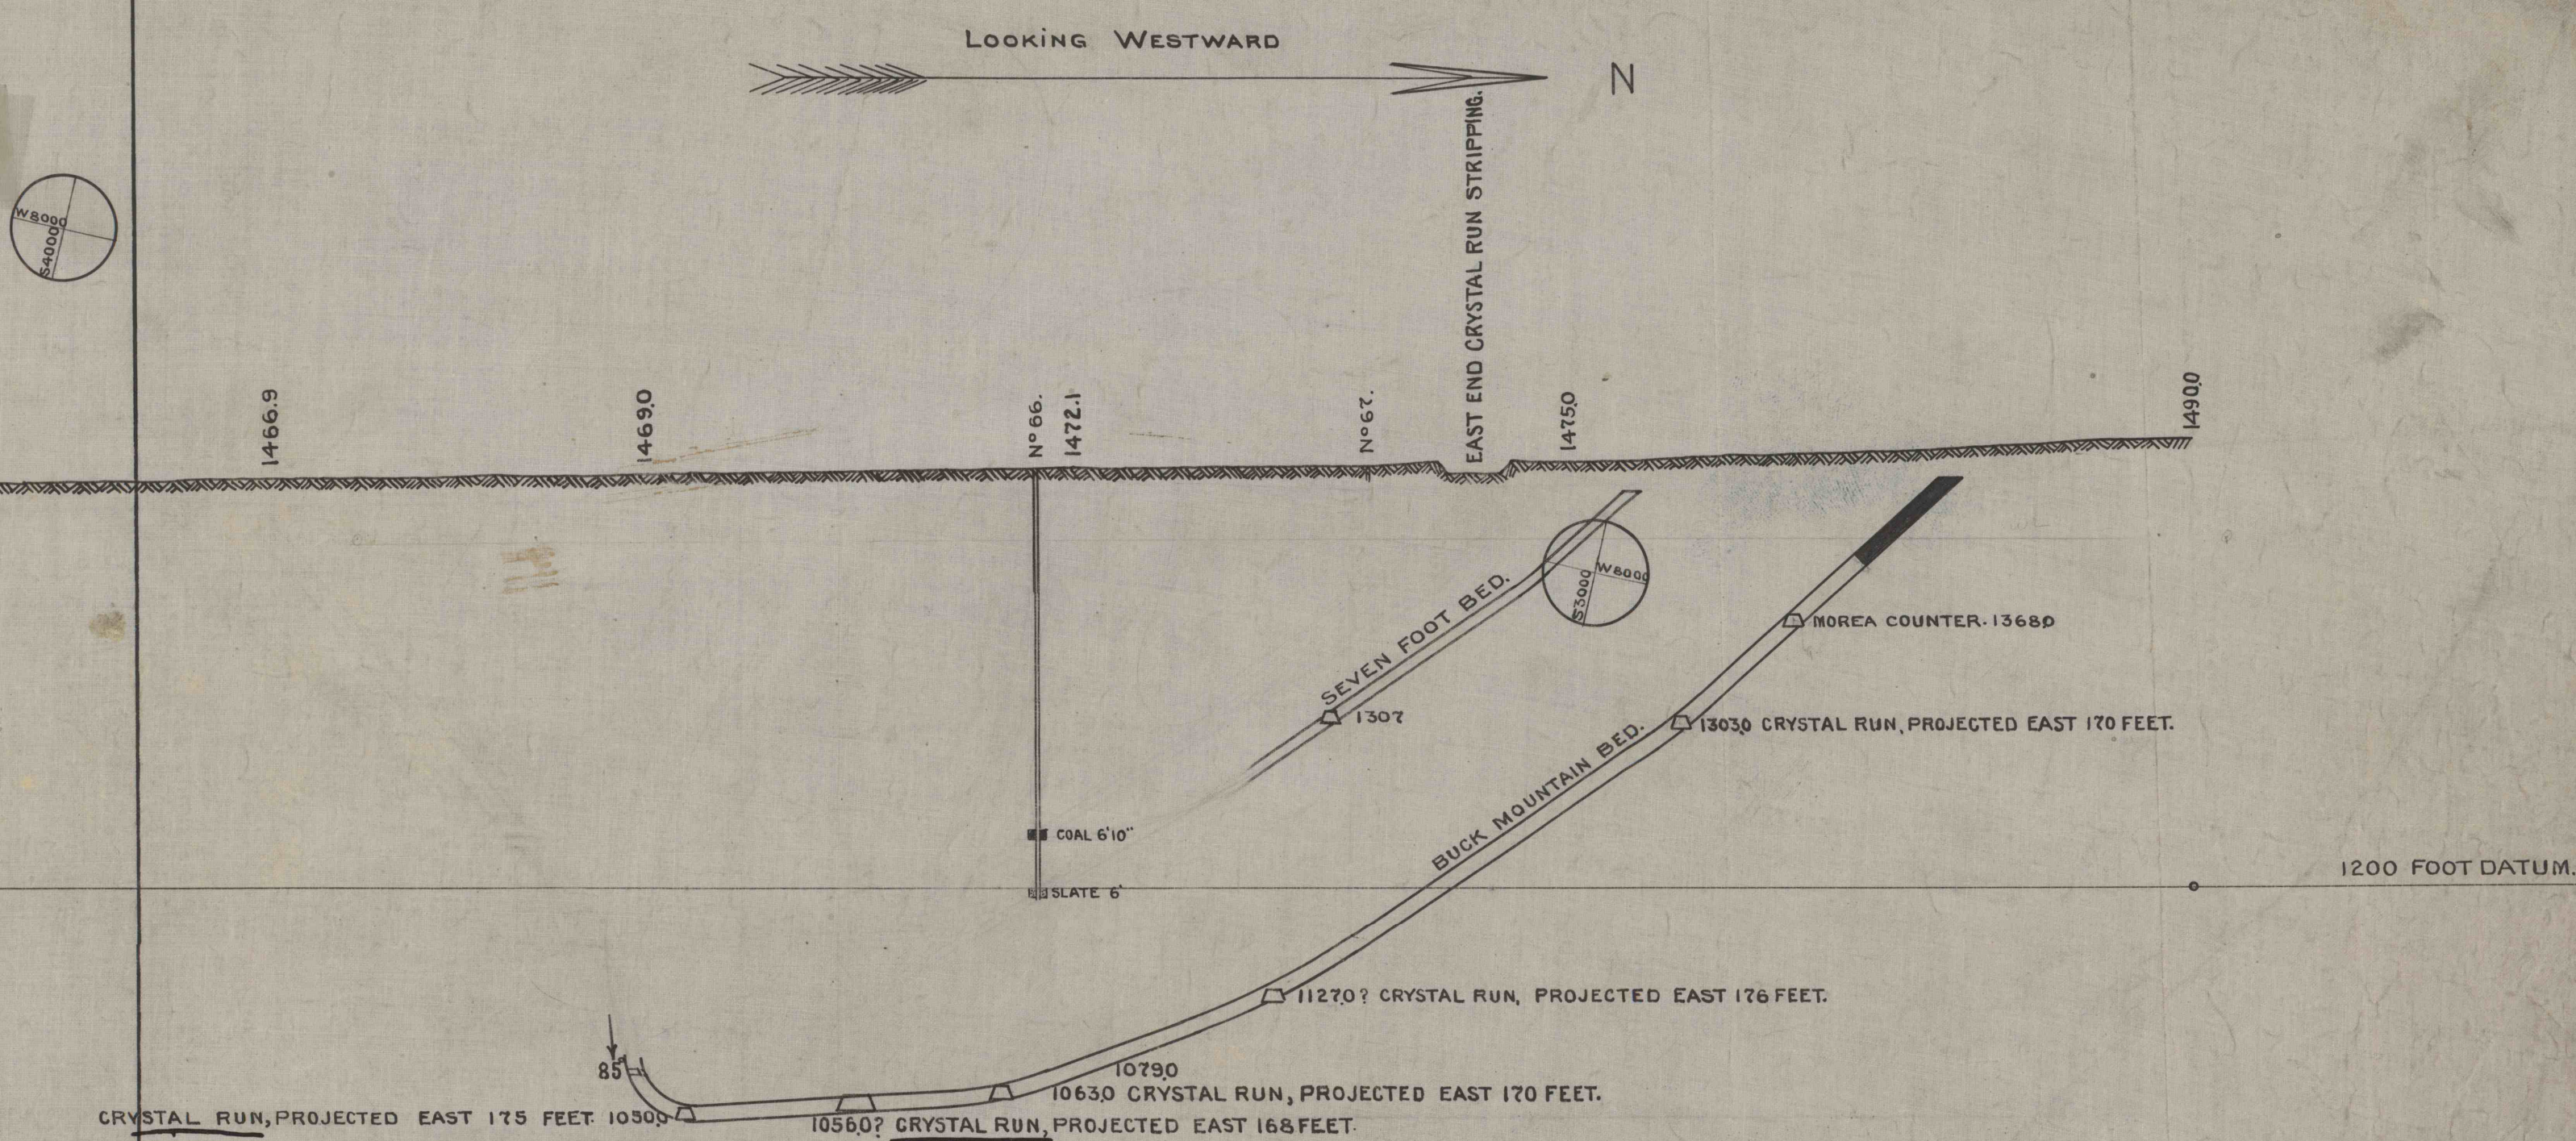

...SOUTHERN FIELD...

MAHANAY TWP., SCHUYLKILL COUNTY, PA.,

14 E. SCHUYLKILL DISTRICT.

DODSON COAL CO., MADEIRA HILL COAL CO.

— N° 2-A —

MOREA COLLIERY

SECTION 100 FEET EAST OF THE REHLE WEST LINE.

100 FOOT SCALE