


LOOKING WESTWARD

N

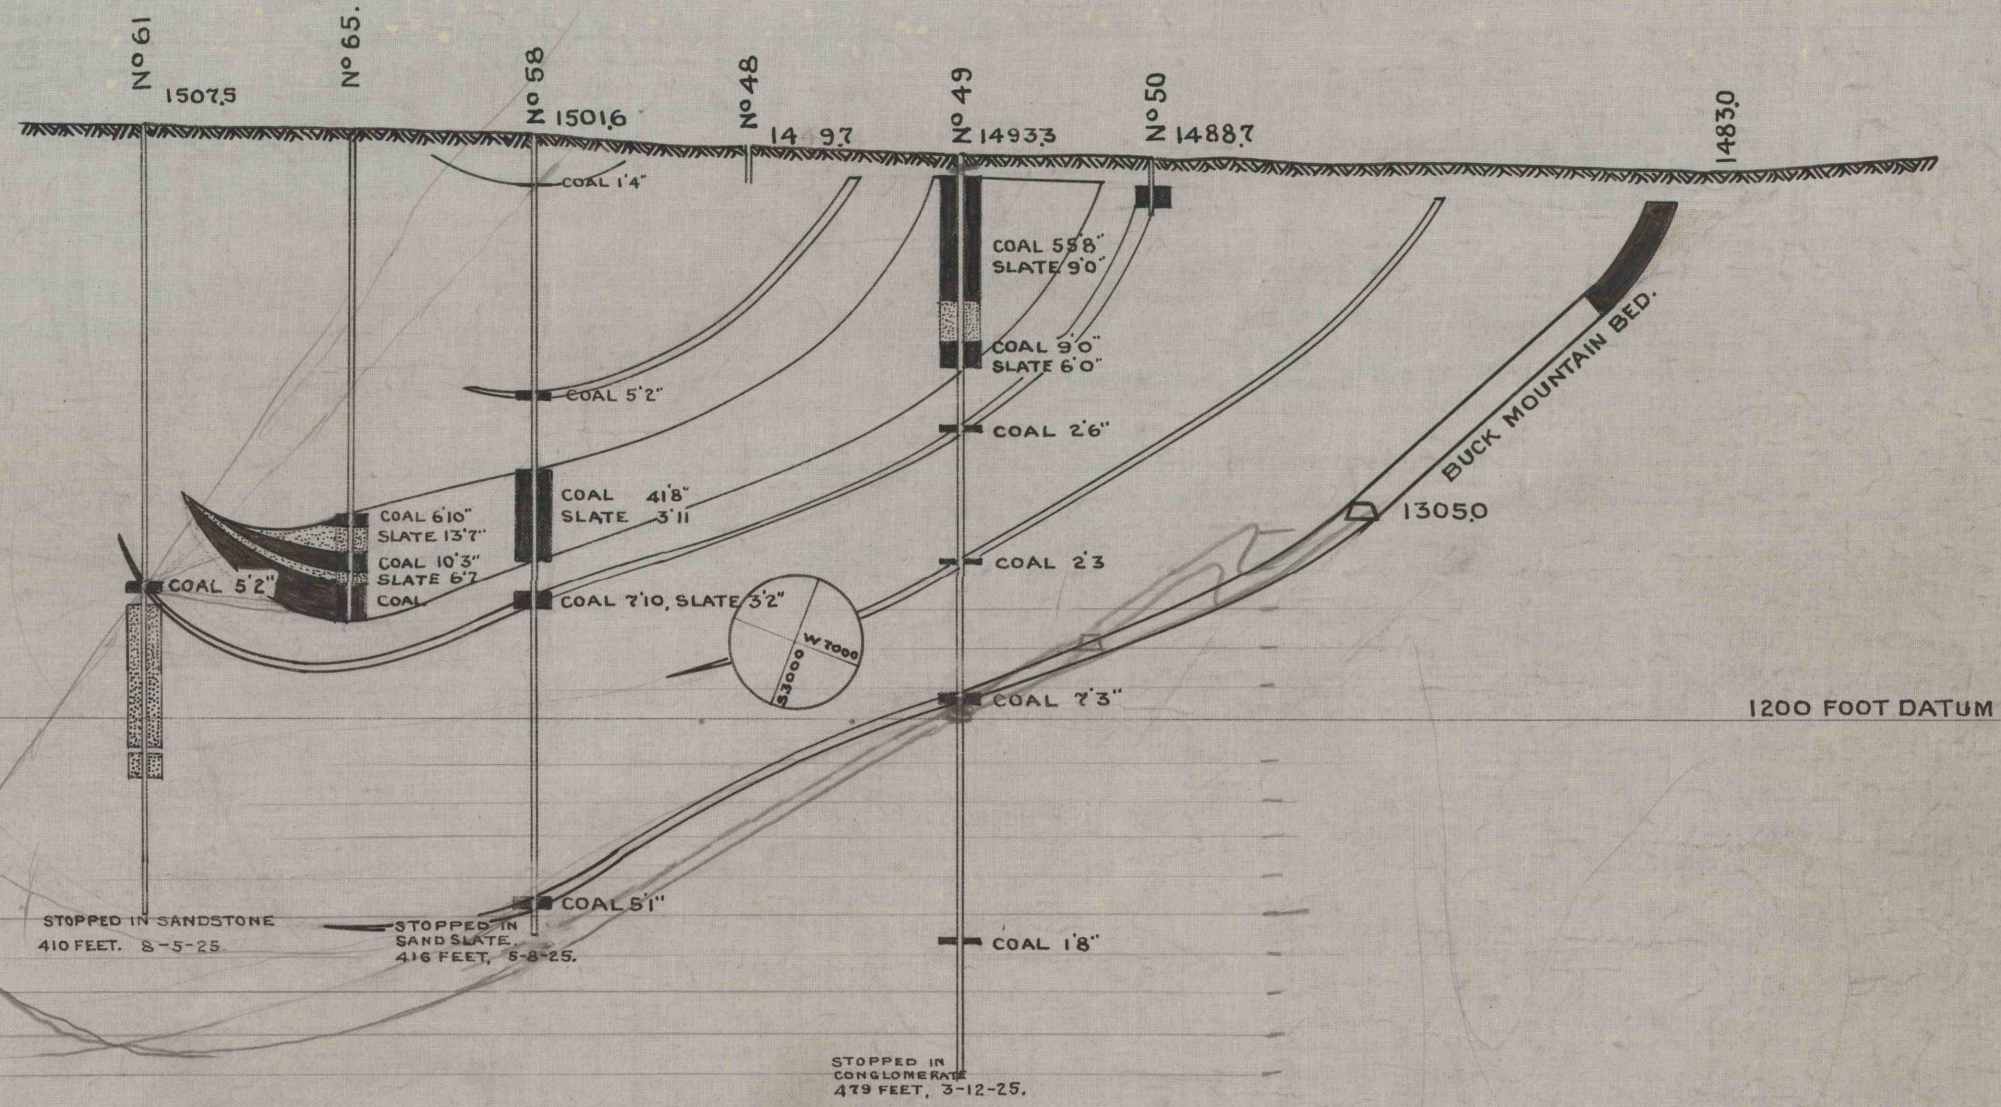

SOUTHERN COAL FIELD
MAHANOTWIP No 3A SCHUYLKILL CO.,
MOREA COLLIERY

SECTION THROUGH LINE No 10, OR THROUGH BREAST No 104.

— IN THE —

FIRST WEST BUCK MOUNTAIN SOUTH DIP GANGWAY

SCALE 1 INCH=100 FEET.