
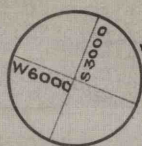


LOOKING WESTWARD

N

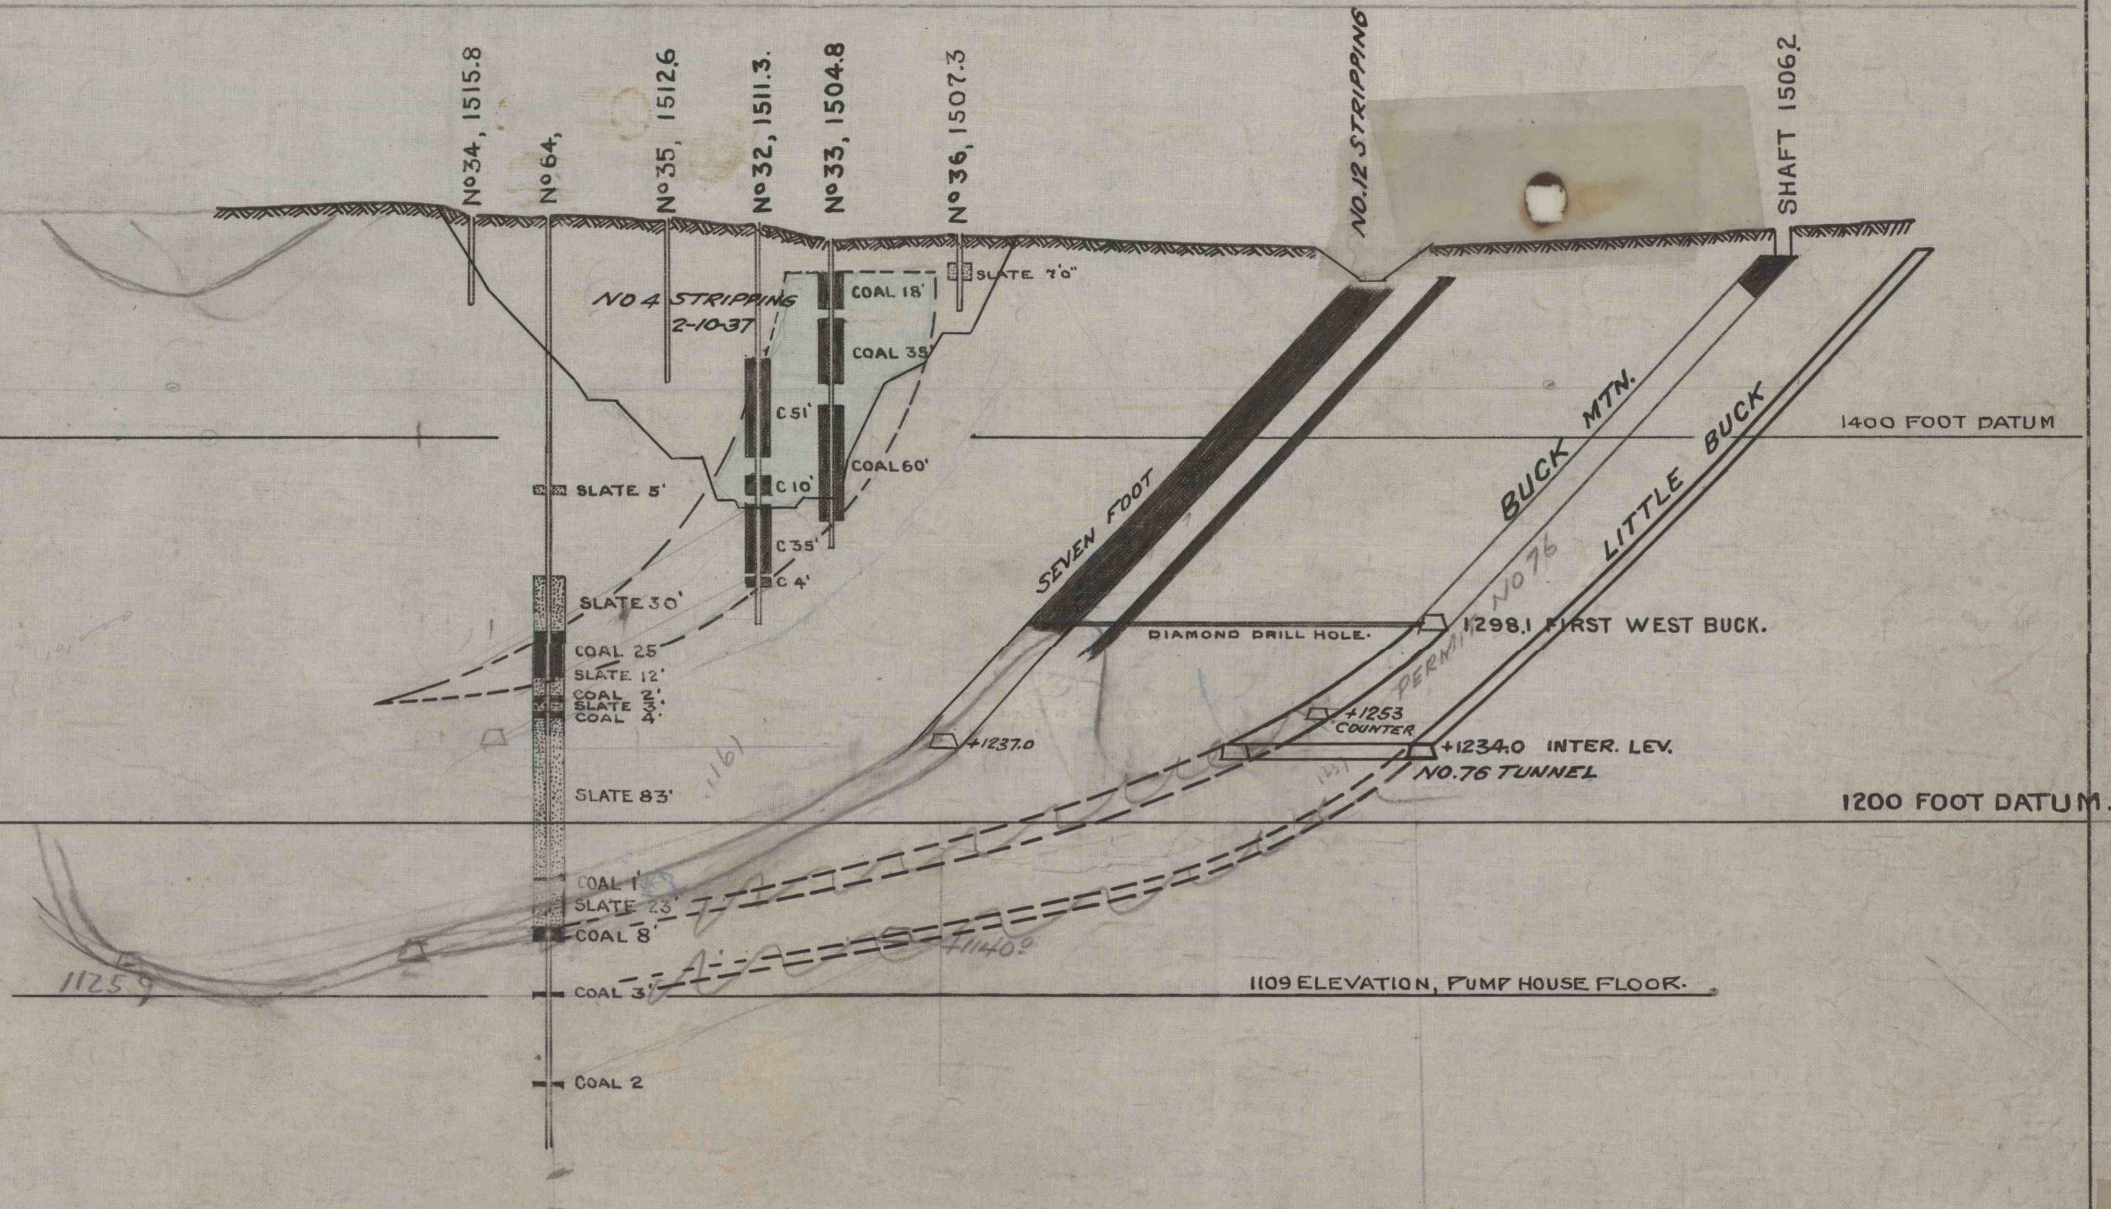

SOUTHERN FIELD..
MAHANOTWP, SCHUYLKILL
COUNTY PA. 14 E. SCHUYLK. DIST.

NO. 4 A

MOREA COLLIERY

SECTION THROUGH LINE NO. 9, OR THROUGH BREAST NO. 91

— IN THE —

Dodson Coal Co., Madeira Hill Coal Co., FIRST WEST BUCK MOUNTAIN SOUTH DIP GANGWAY.

SCALE: 1-INCH 100 FEET.