


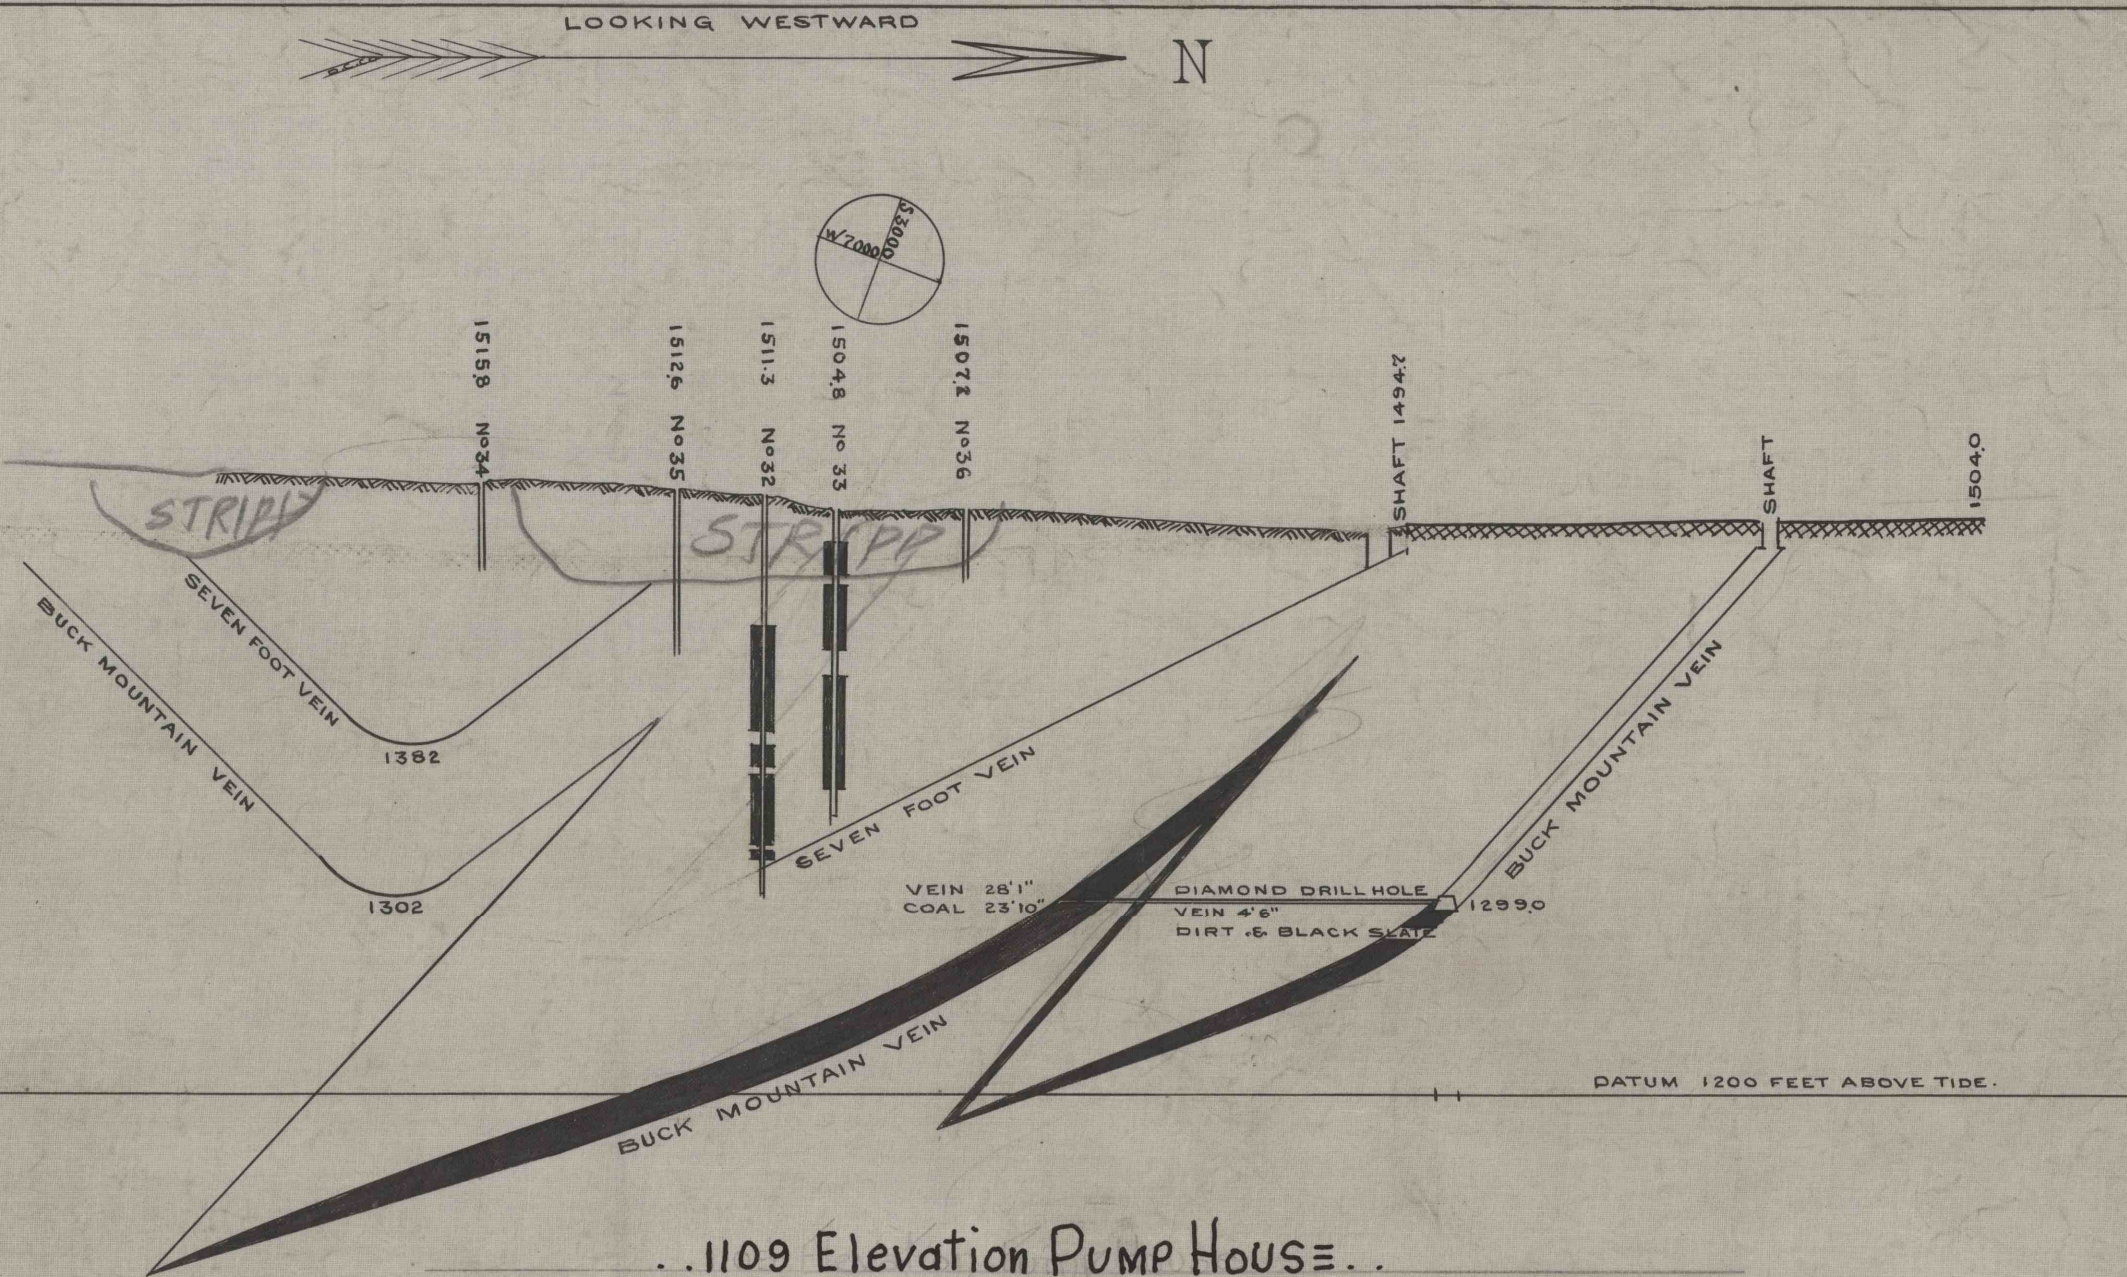

14 EAST SCHUYLKILL DISTRICT,
Dodson Coal Co., Madeira Hill Coal Co.,

SOUTHERN COAL FIELD
MAHANOTWAP. No 5 ÷ SCHUYLKILL CO.,

— MOREA COLLIERY —
SECTION 4410 FEET WEST OF THE
DELANO WEST LINE
OR THROUGH BREAST No 91 IN THE
FIRST WEST SOUTH DIP
BUCK MOUNTAIN VEIN GANGWAY.

100 FOOT SCALE

10-23-1922.