


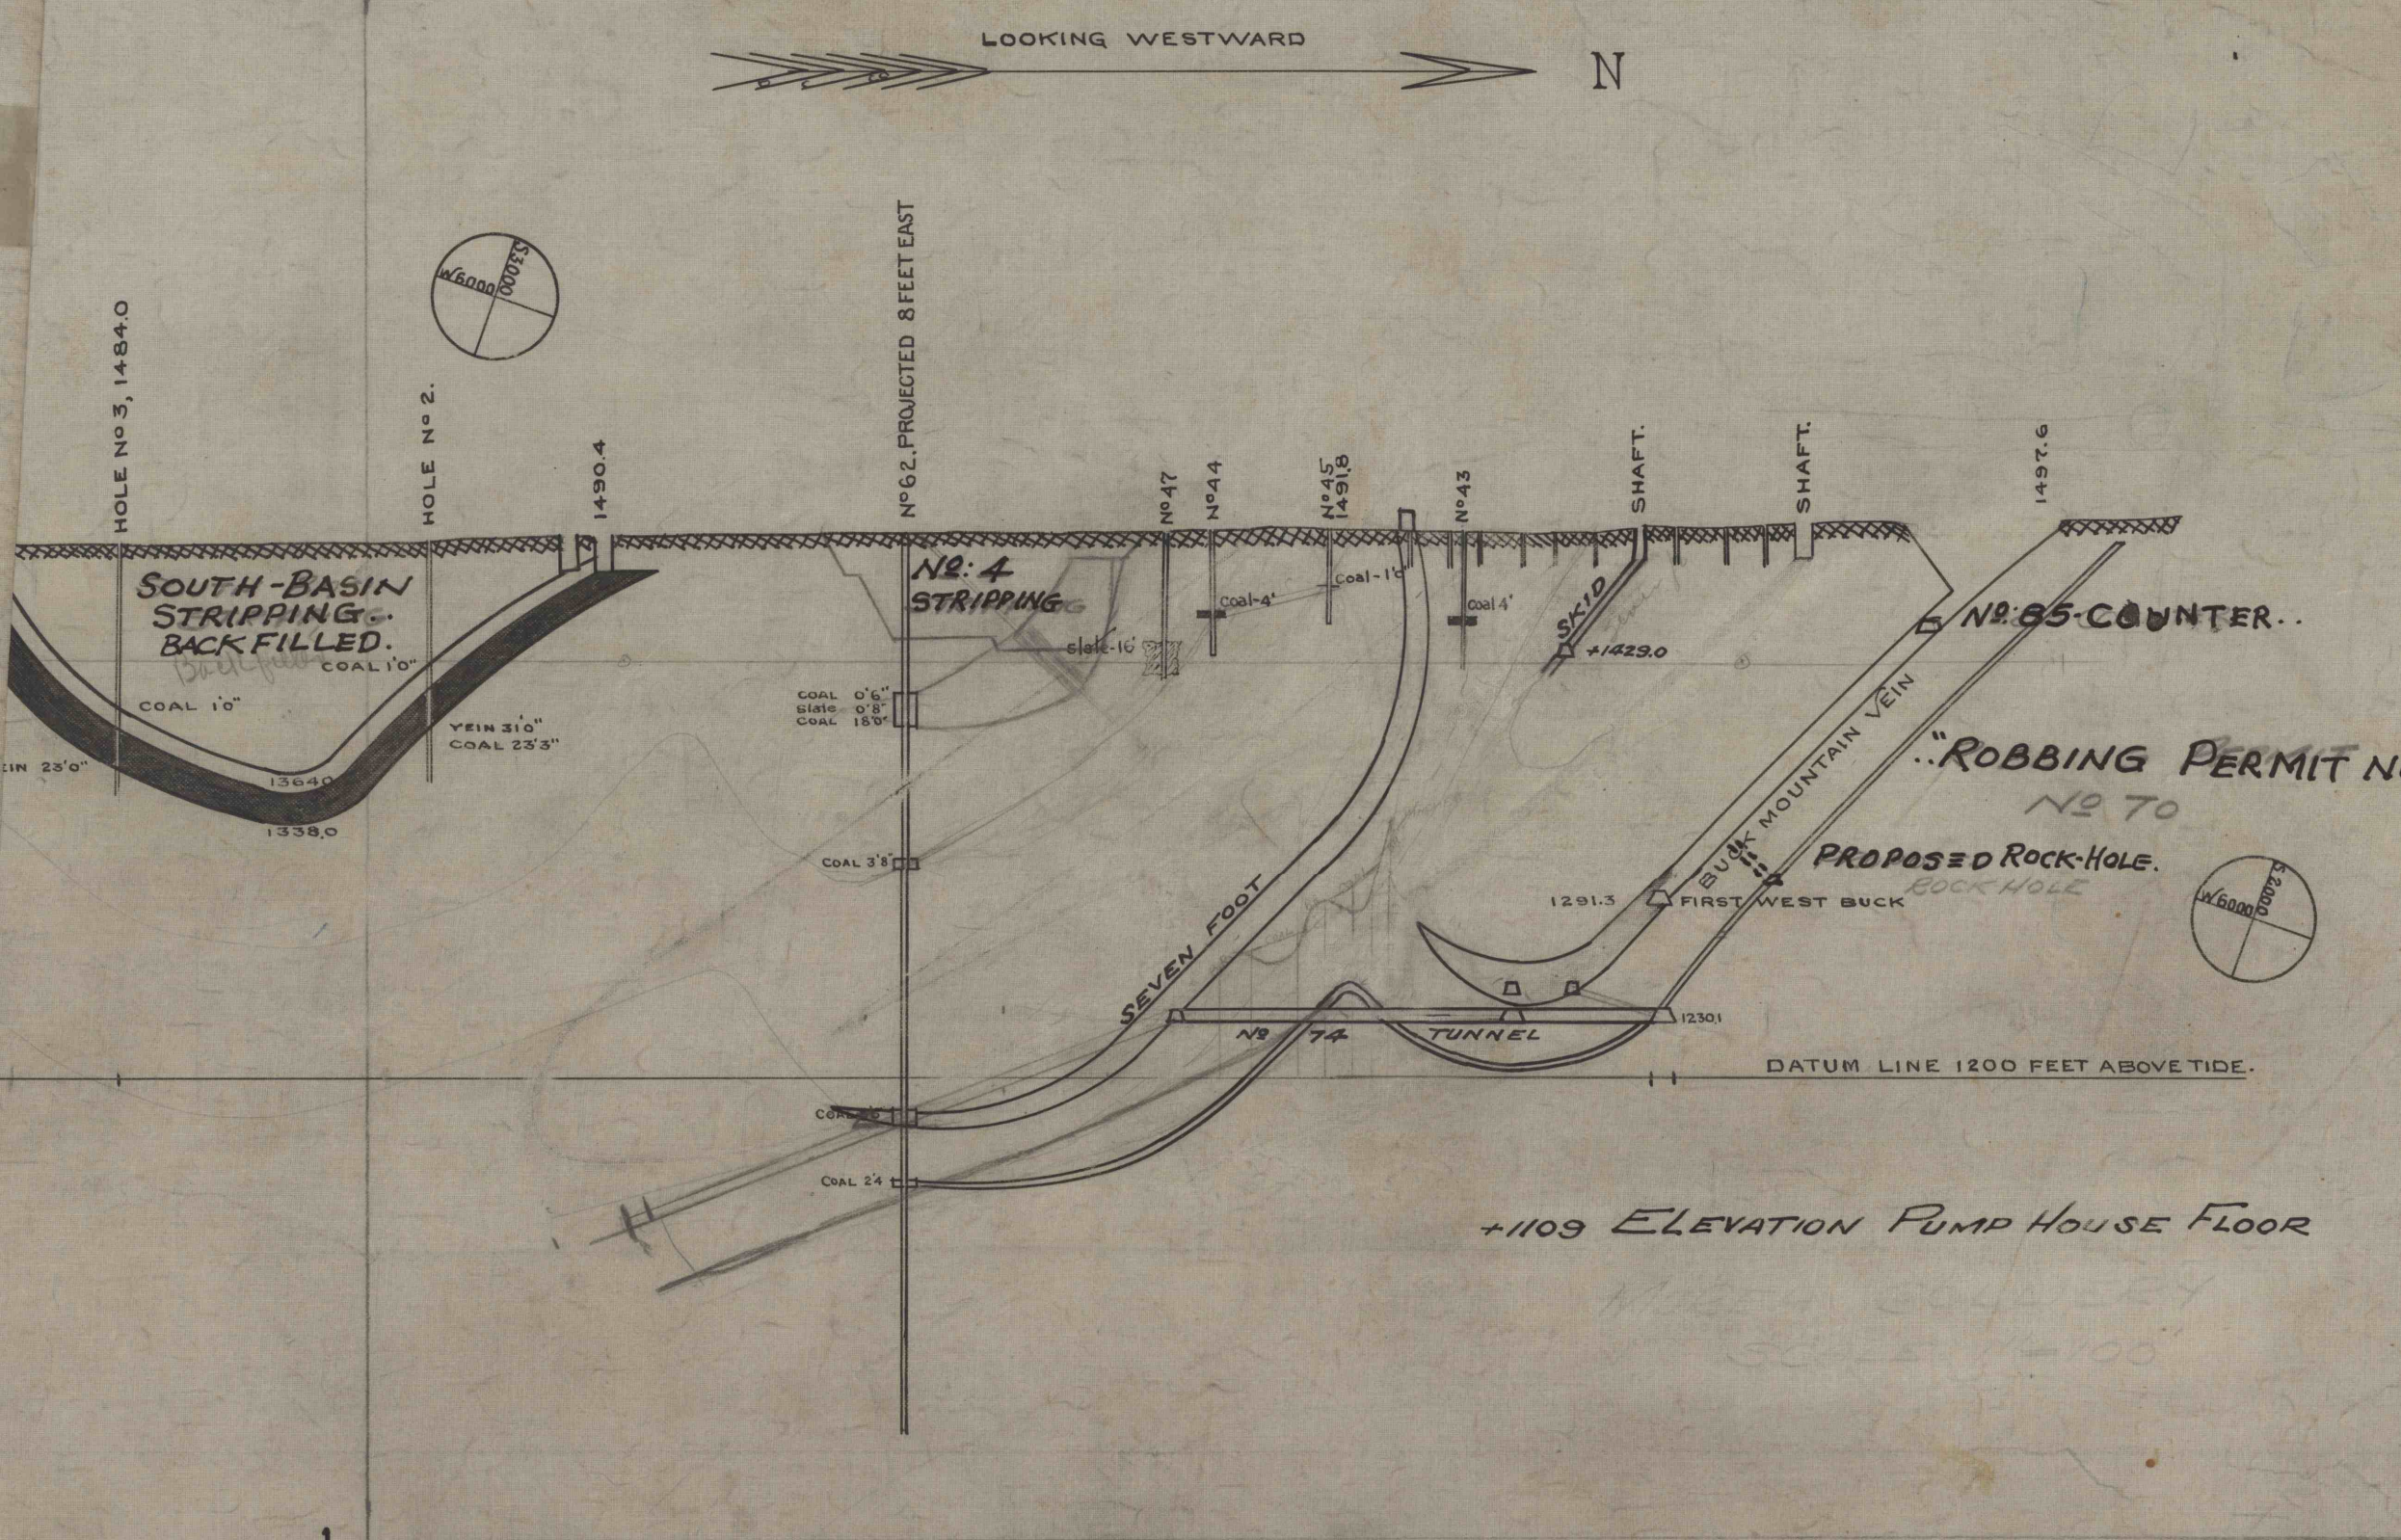

..SOUTHERN FIELD..Mahanoy Twp.,
Schuylkill County PA., 14 E. Schuylkill District.
Dodson Coal Co., Madeira Hill Coal Co.,

— No 6 —
— MOREA COLLIERY —
..SECTION 3500 FEET WEST OF THE
DELANO WEST LINE,
OR THROUGH BREAST No 71 IN THE
FIRST WEST SOUTH DIP,
BUCK MOUNTAIN VEIN GANGWAY.

— 100 FOOT SCALE —

10-23-1922