


LOOKING WESTWARD

N

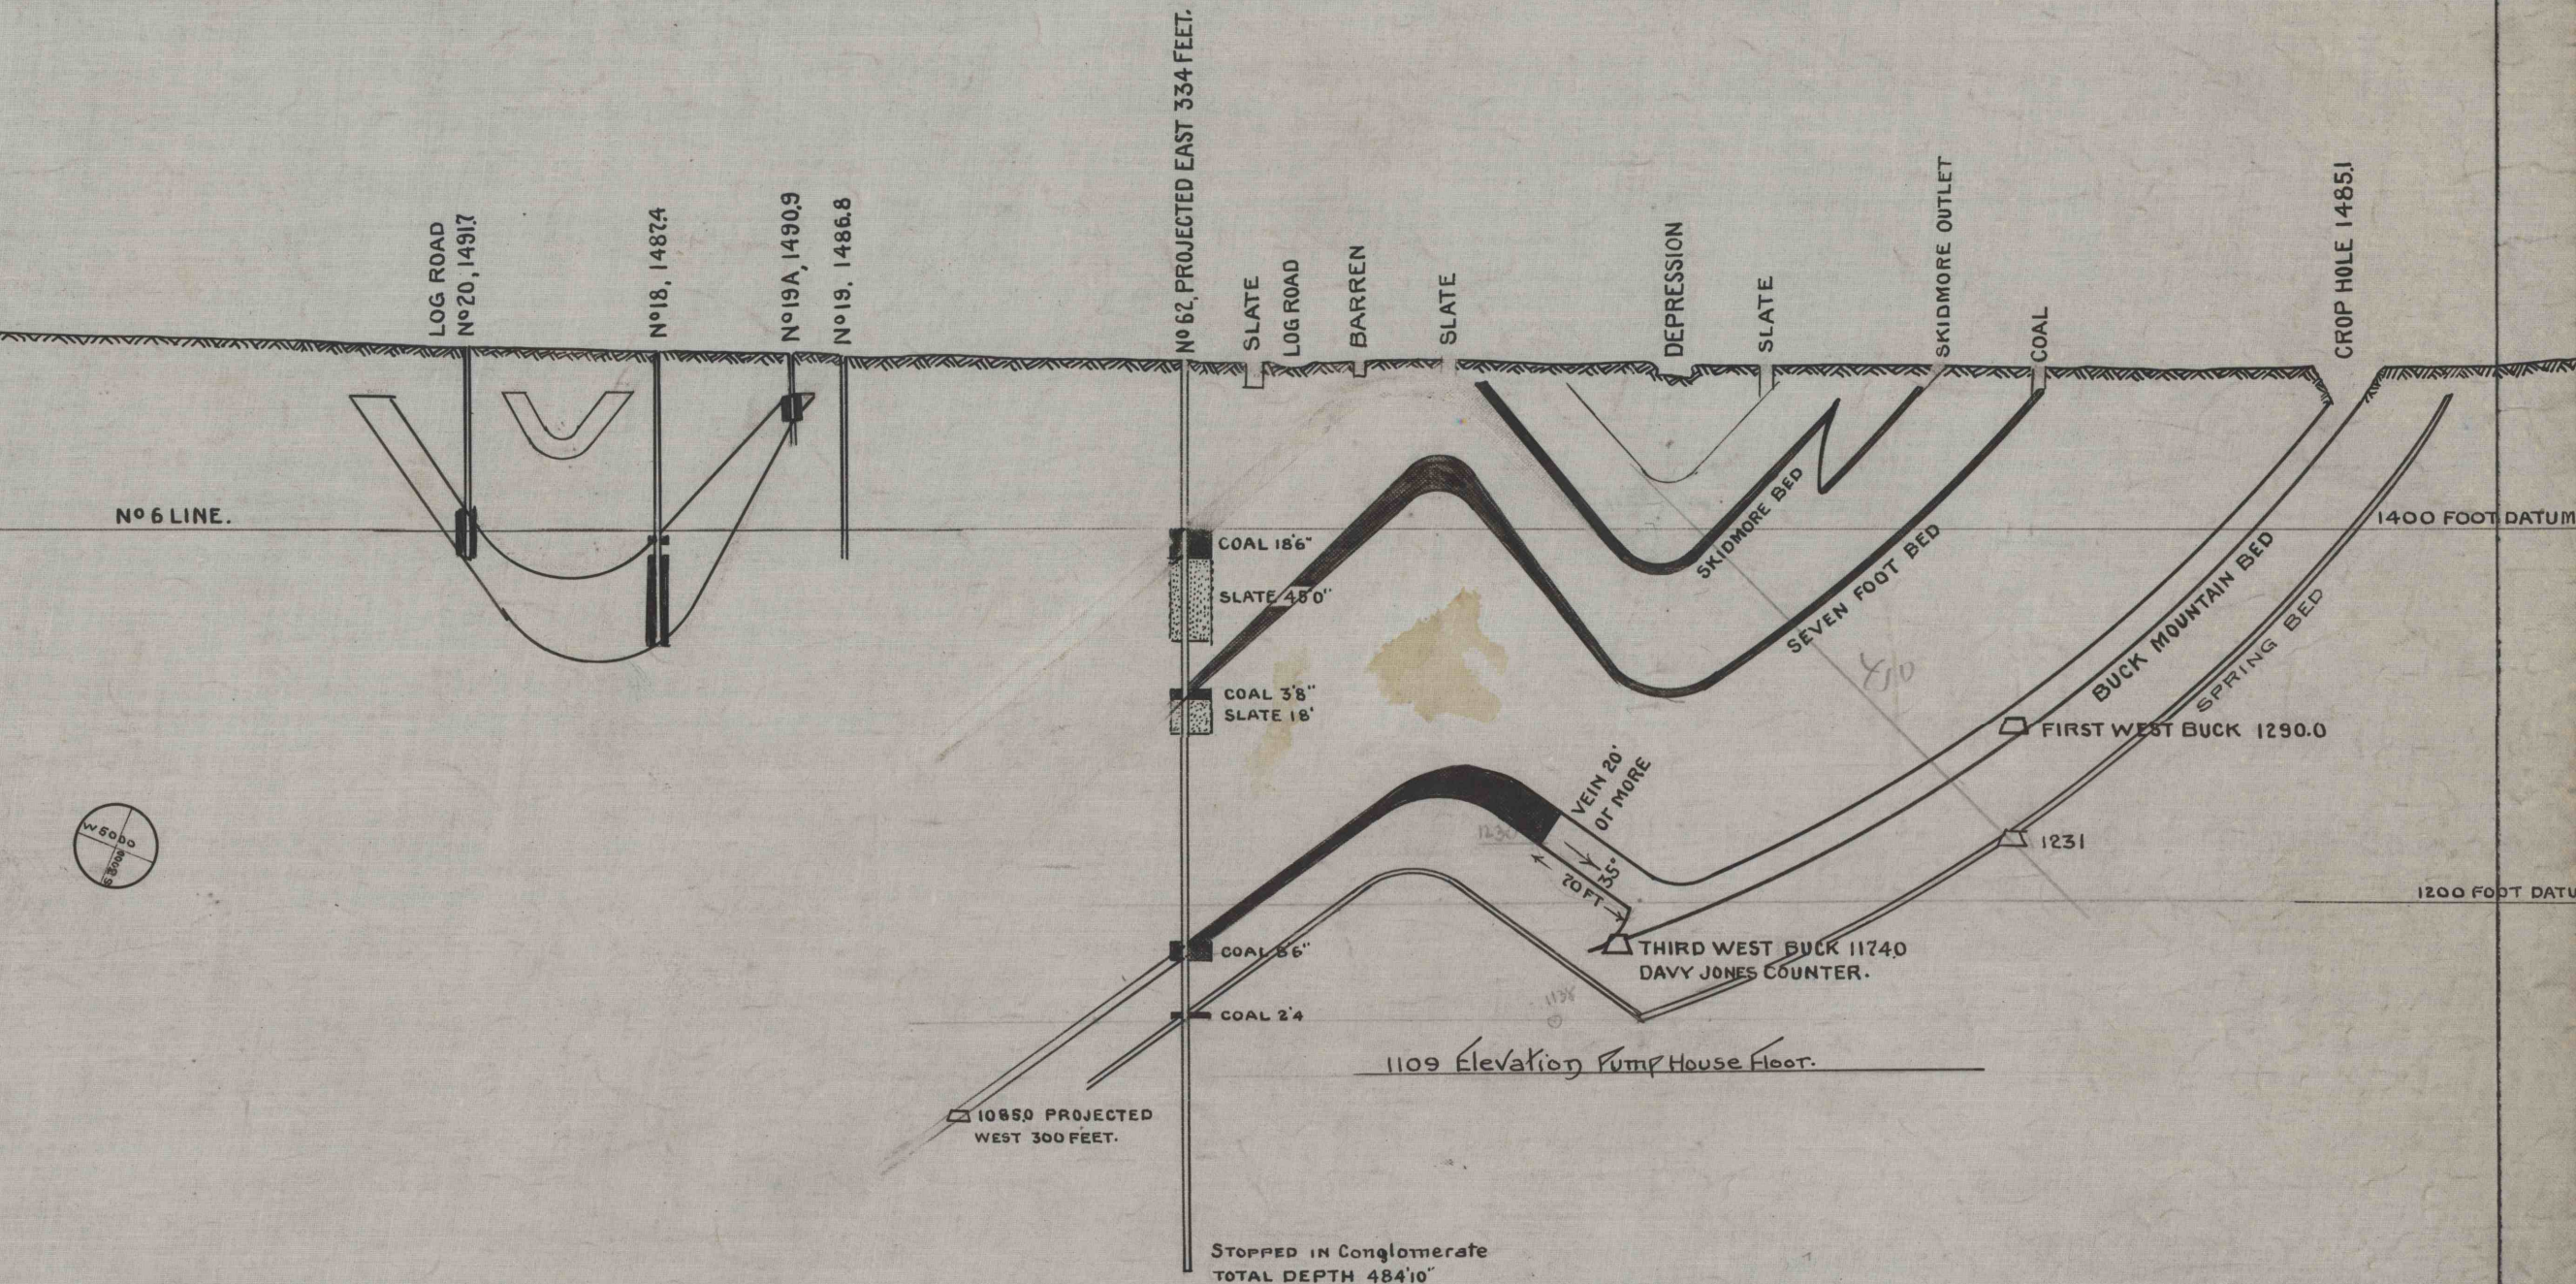

14-E. Schuylkill District. Dodson Coal Co.
MADEIRA Hill Coal Co.

SOUTHERN COAL FIELD

— MOREA COLLIERY —

SECTION THROUGH LINE No 6, OR THROUGH BREAST No 65

— IN THE —

FIRST WEST BUCK MOUNTAIN SOUTH DIP GANGWAY

SCALE 1 INCH = 100 FEET

MAHAN0Y TWP. SCHUYLKILL CO.,