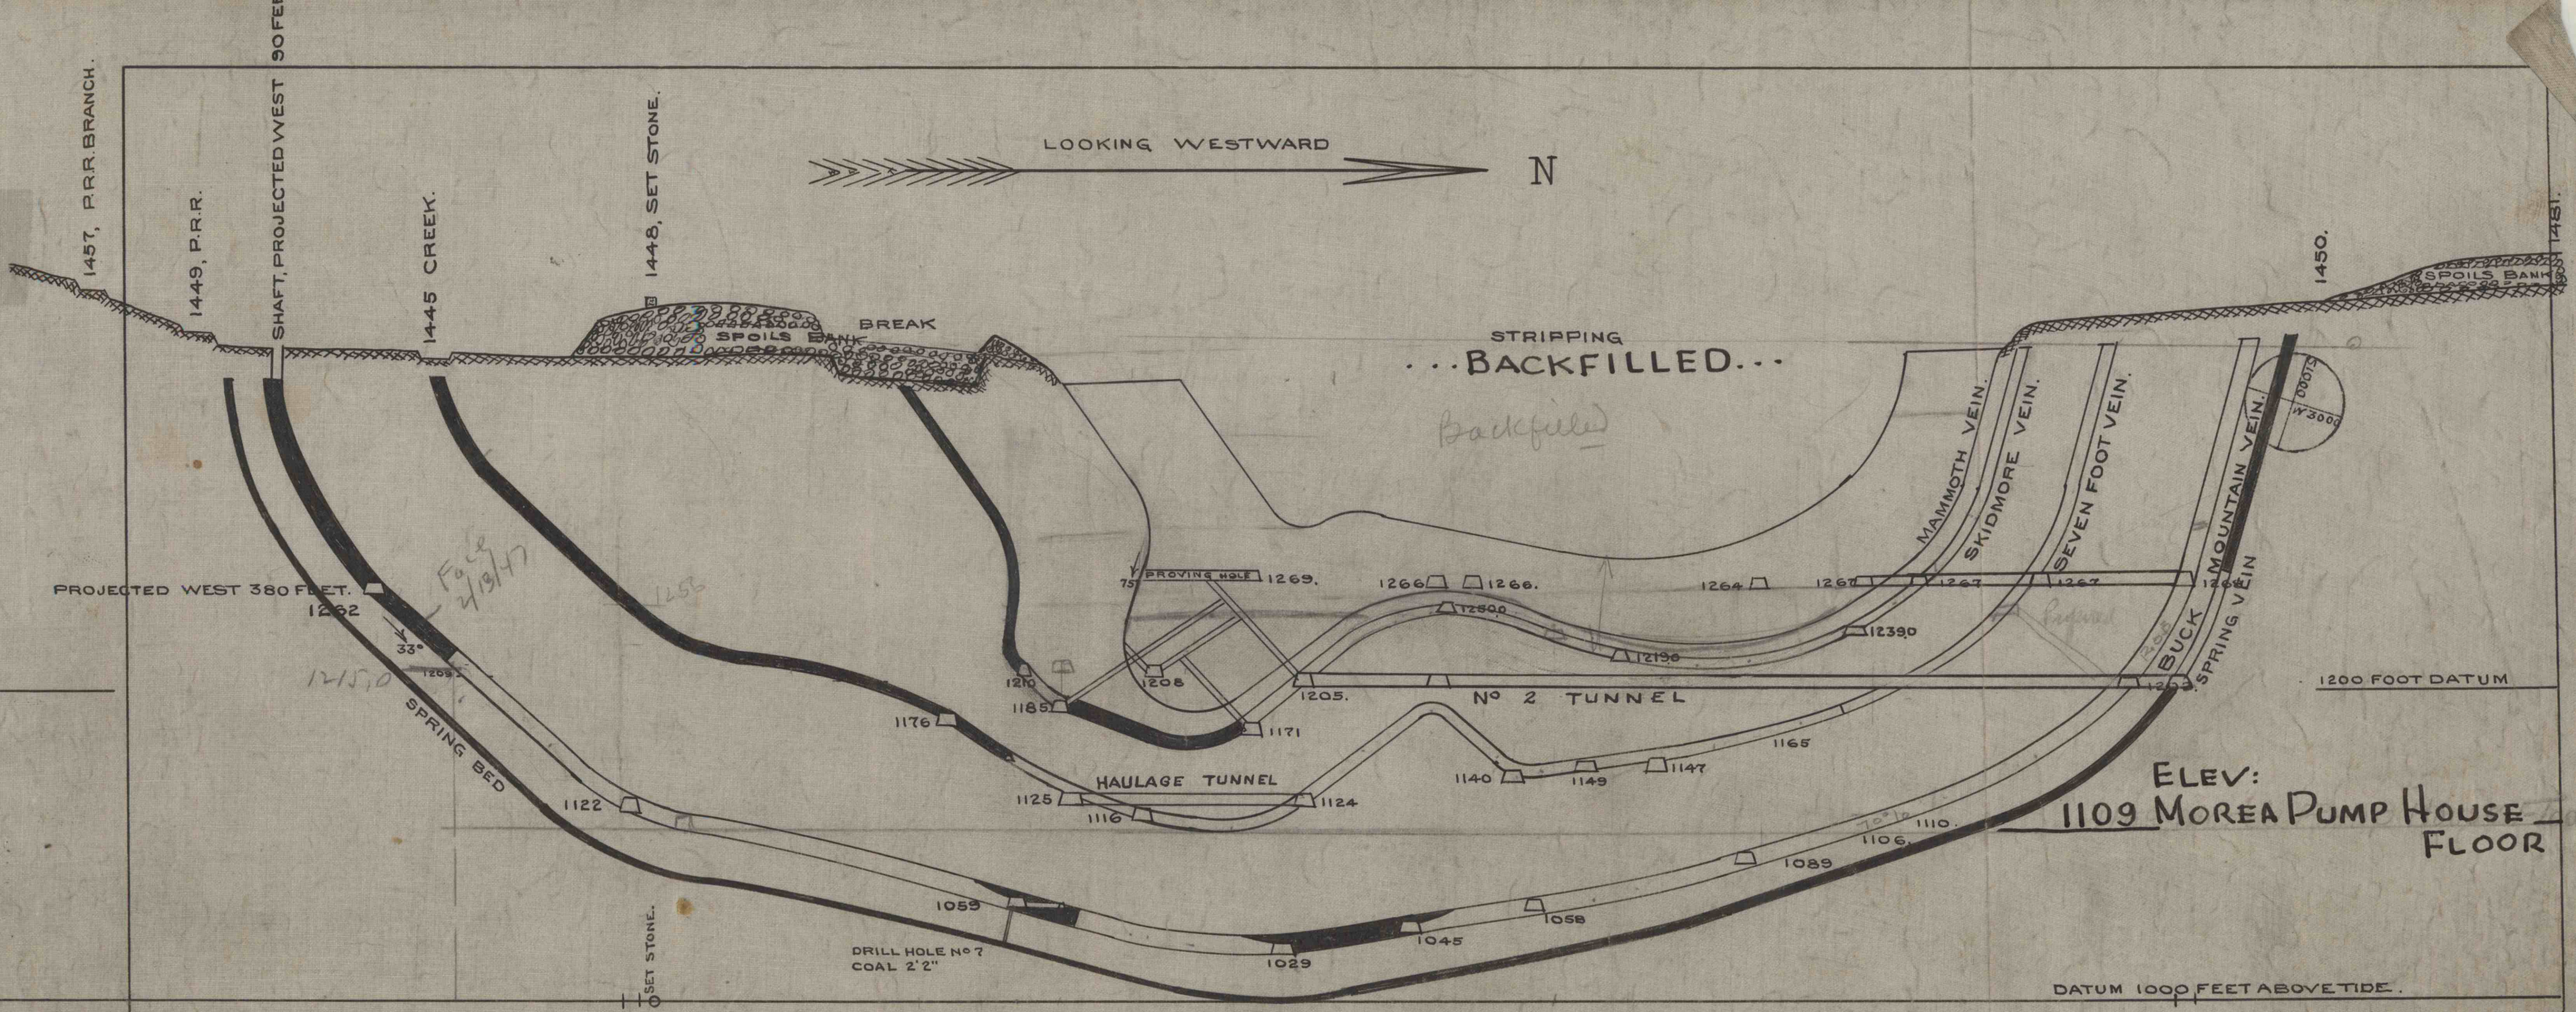

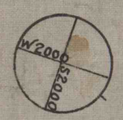

...SOUTHERN FIELD..MAHANOY TWP.,
SCHUYLKILL COUNTY PA., 14 E. Schuylkill DIST.;
DODSON Coal Co., MADEIRA Hill COAL CO.,

—No 13—
—MOREA COLLIERY—
"SECTION THROUGH THE DELANO WEST LINE".
100 FOOT SCALE
10-30-22.