


PENNSYLVANIA RAILROAD BRANCH 14

PENNSYLVANIA RAILROAD 14550

LOOKING WESTWARD N

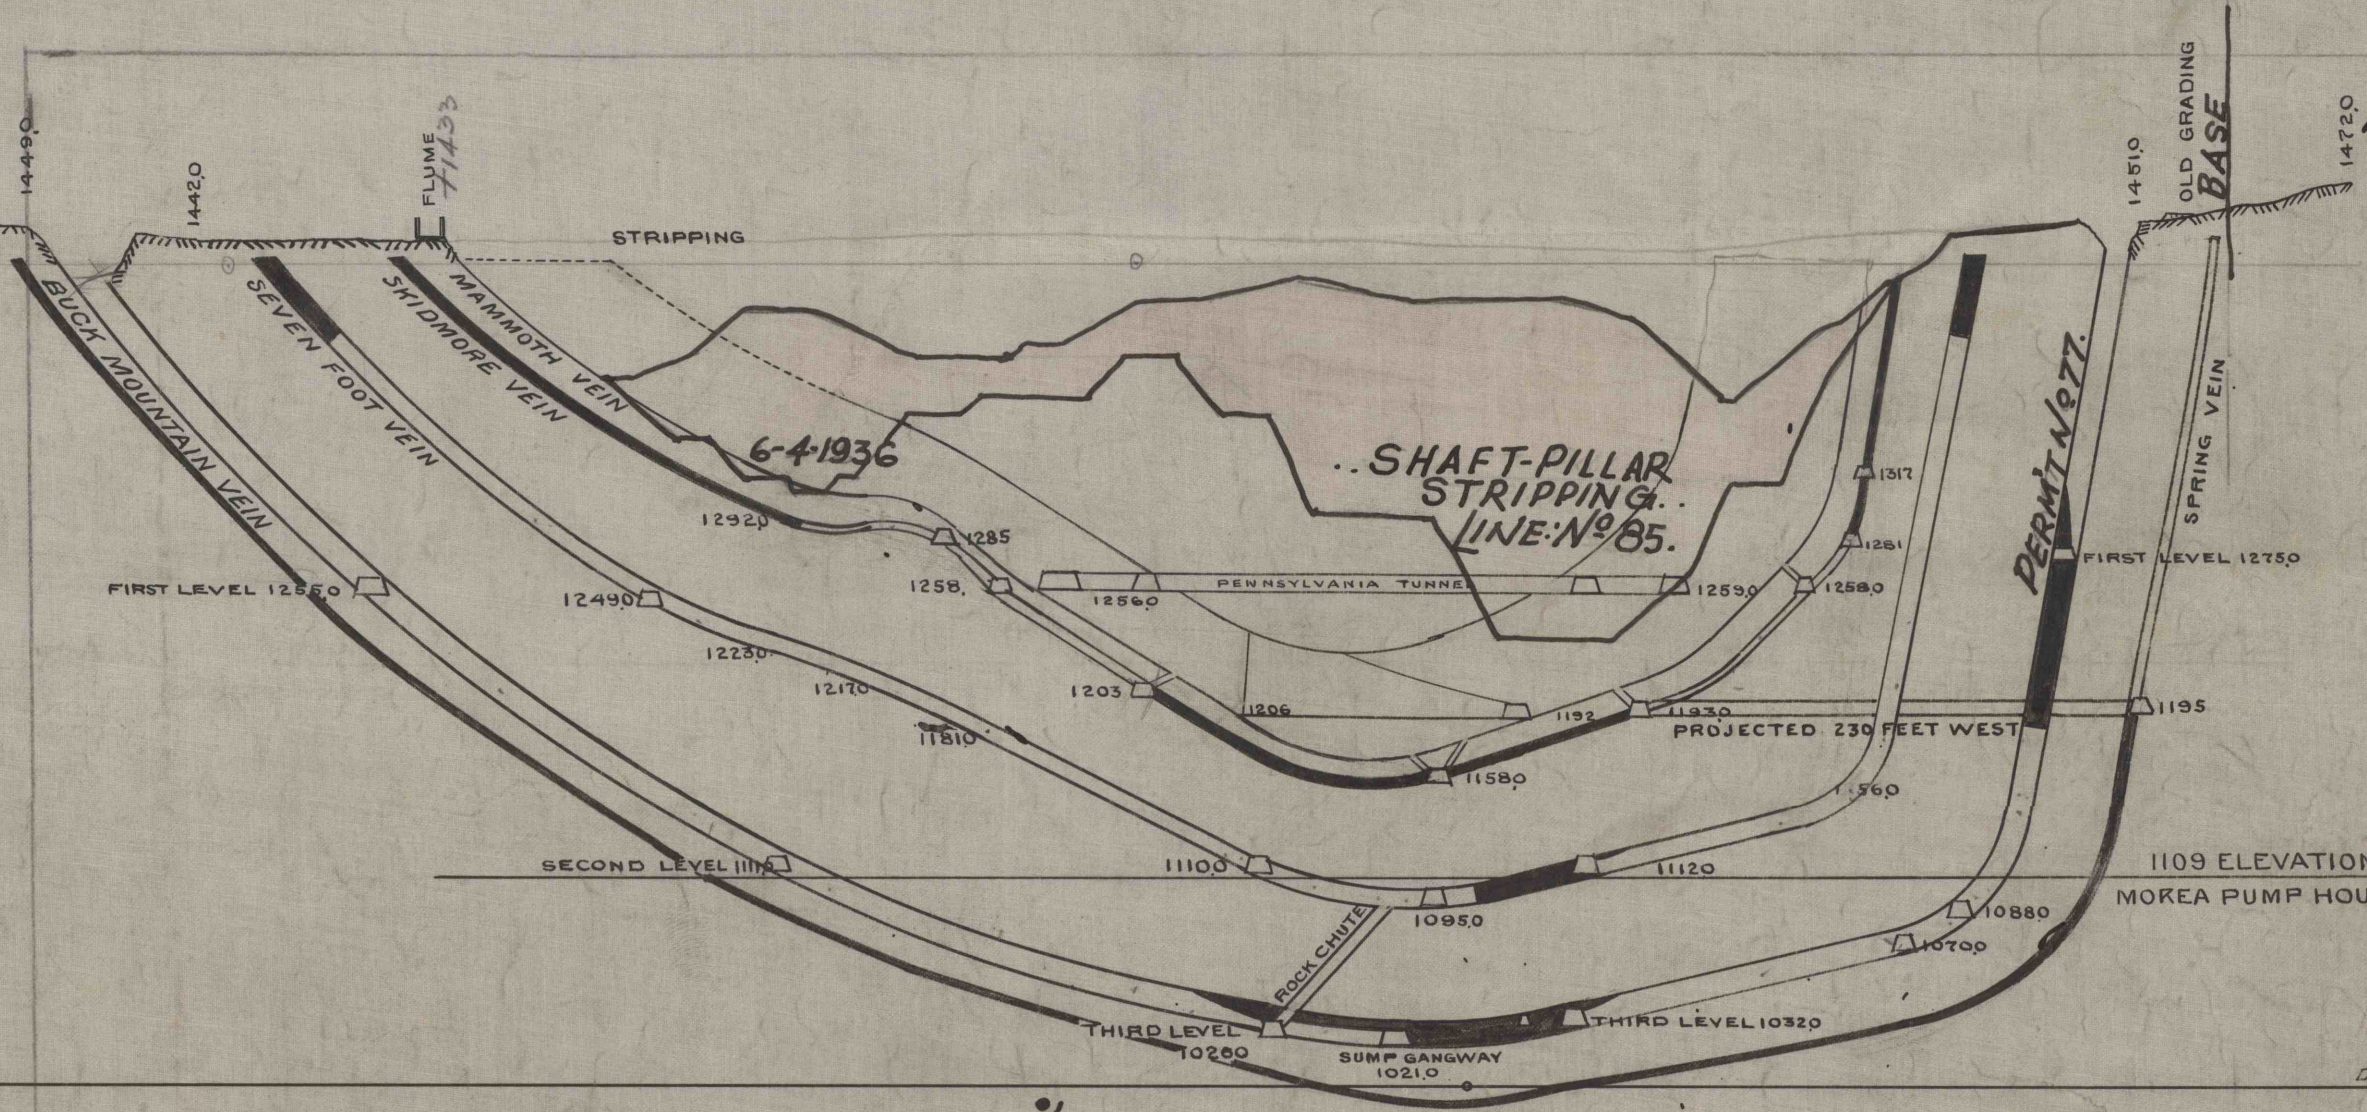

..SOUTHERN FIELD..MAHANOHY TOWNSHIP,
SCHUYLKILL COUNTY PA., 14-E. SCHUYLKILL DISTRICT.
Dodson COAL CO., Madeira - No 15 - Hill COAL CO.,
- MOREA COLLIERY -

..SECTION THROUGH No 32-BREAST-FIRST WEST BUCK MOUNTAIN GANGWAY..

..SCALE: 100 FEET..