


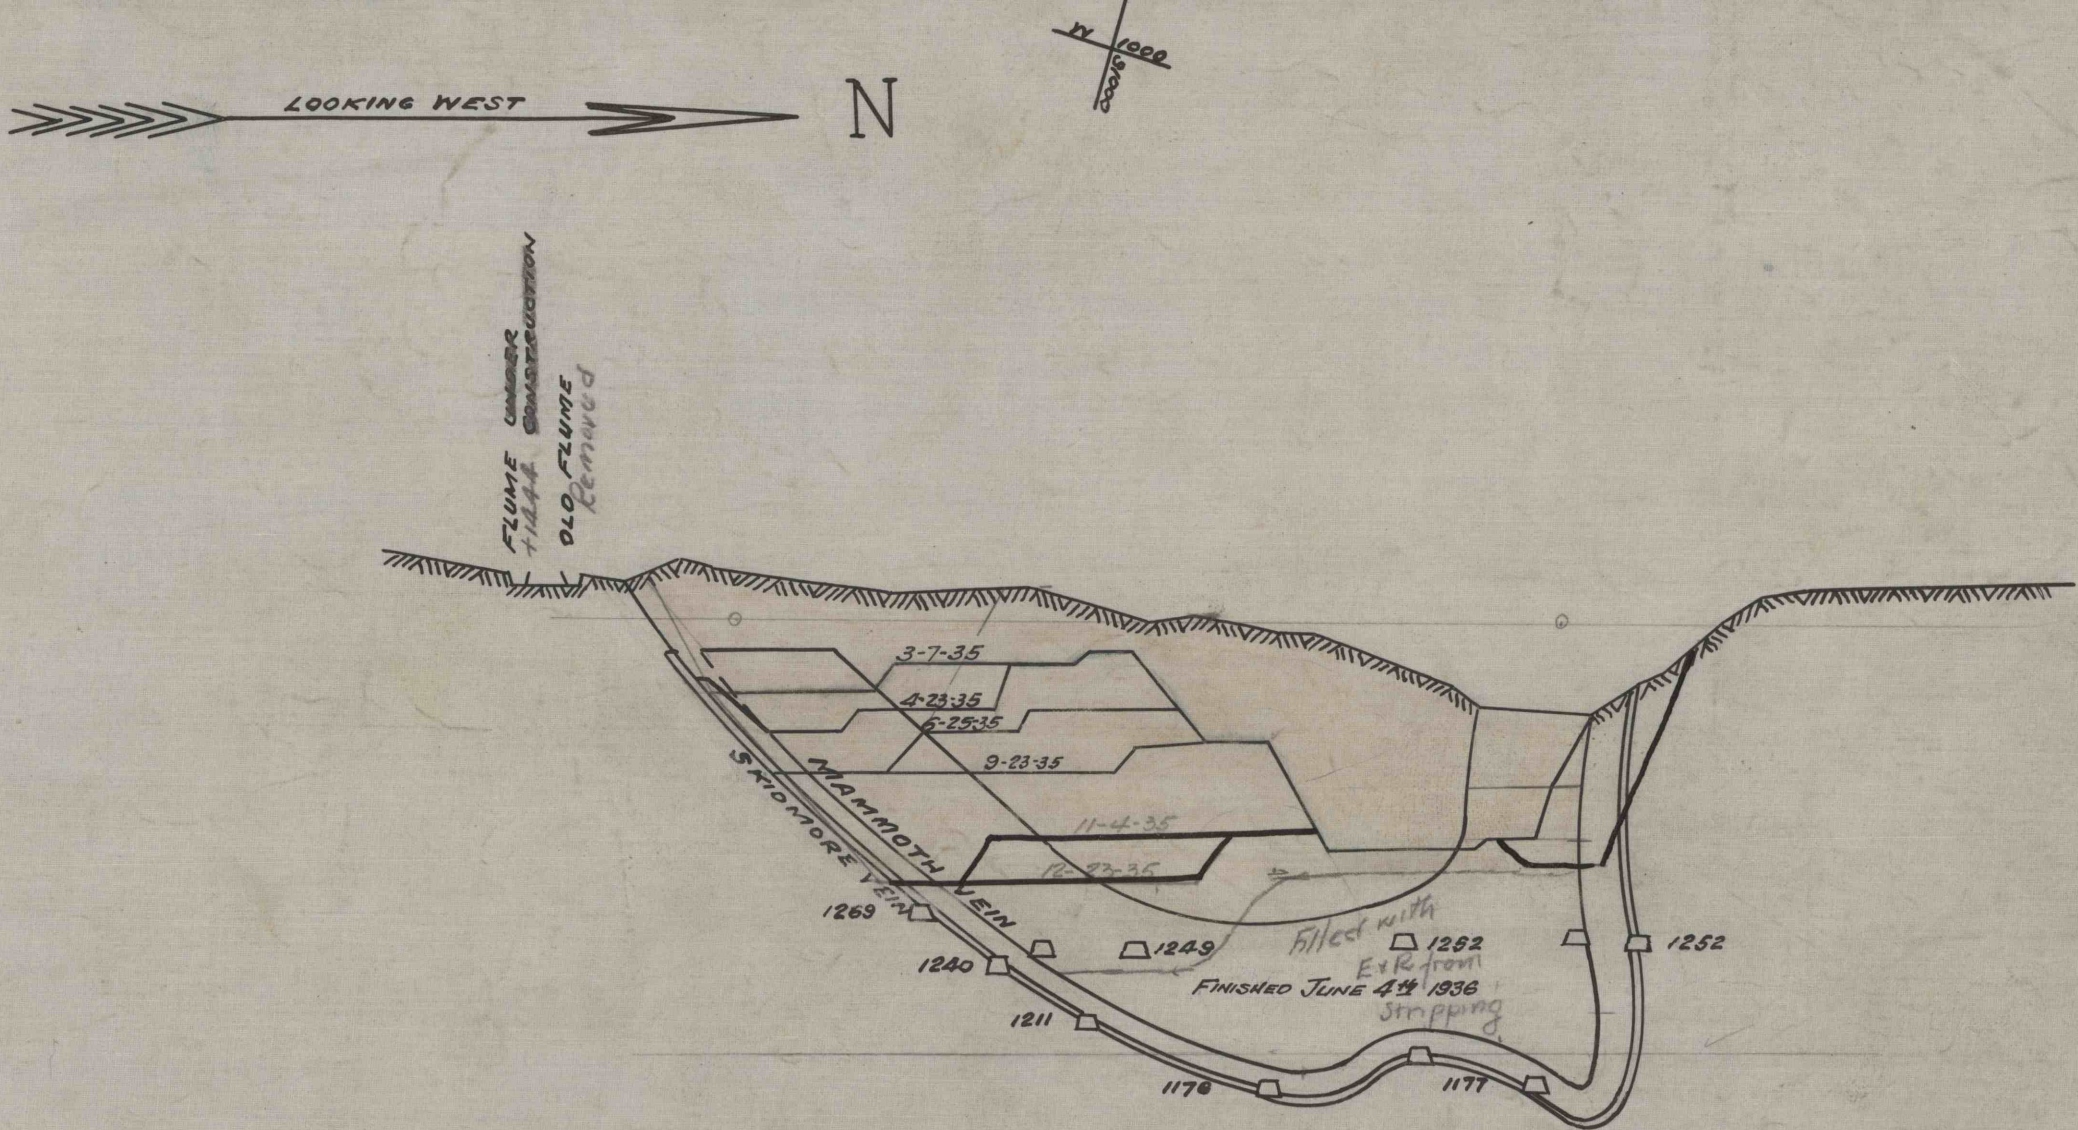

DATUM +1000 FEET

Southern FIELD..MAHANoy TWP.,SCHUYLKILL COUNTY, PA.,
14.E.SCHUYLKILL DISTRICT.
DODSON COAL CO.,MADEIRA HILL COAL CO.,

.. NO: 16-A. .
.. MOREA COLLIERY. .
.. LINE NO: 37. .
EAST-BOTTOM-LIMIT
SHAFT-PILLAR-STRIPPING
SCALE: 1"=100'. . . APRIL 30-1935