


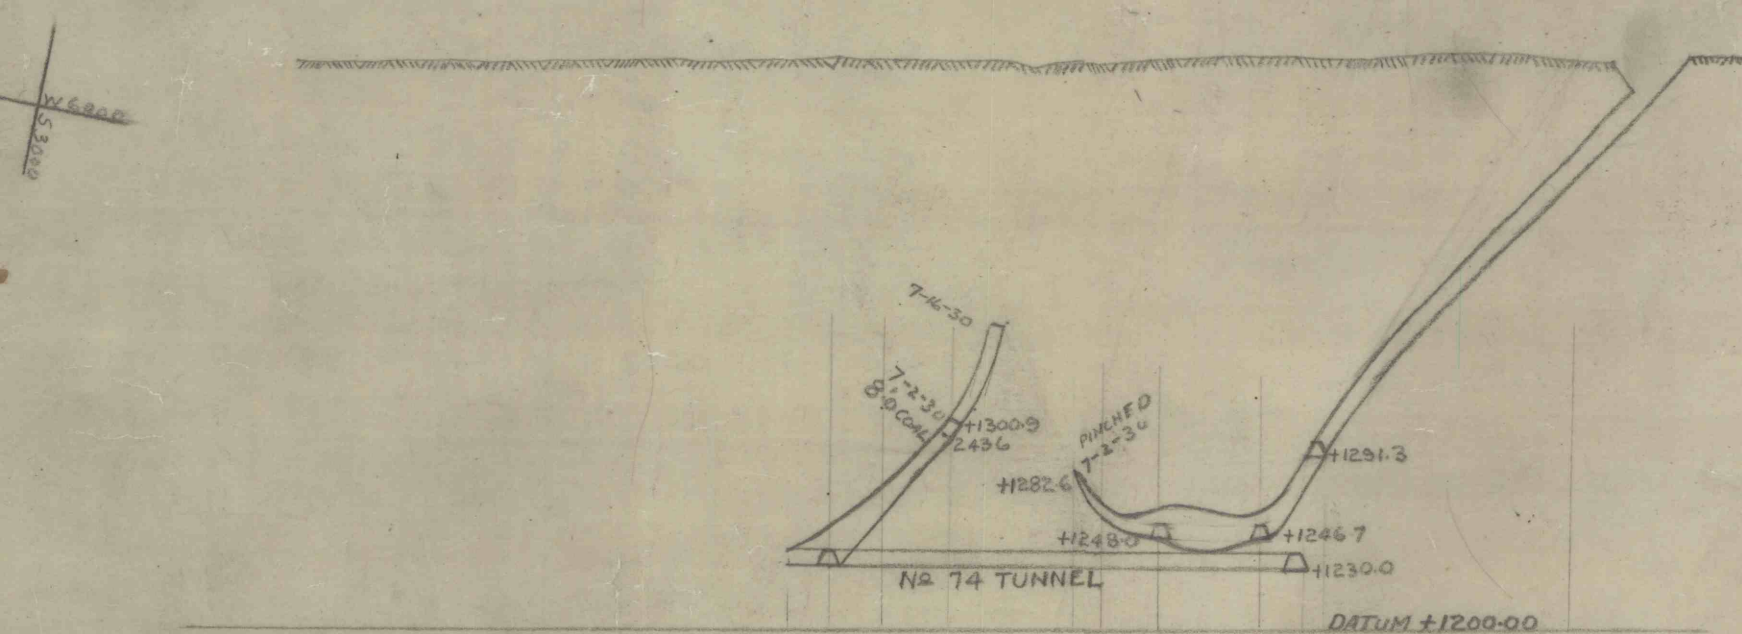

SOUTHERN COAL FIELD
SECTION SHOWING FORMATION OF
BUCK MOUNTAIN VEIN #74 TUNNEL
MOREA COLLIERY
**MAHANOTWP, SCHUYLKILL
COUNTY, PA.**