


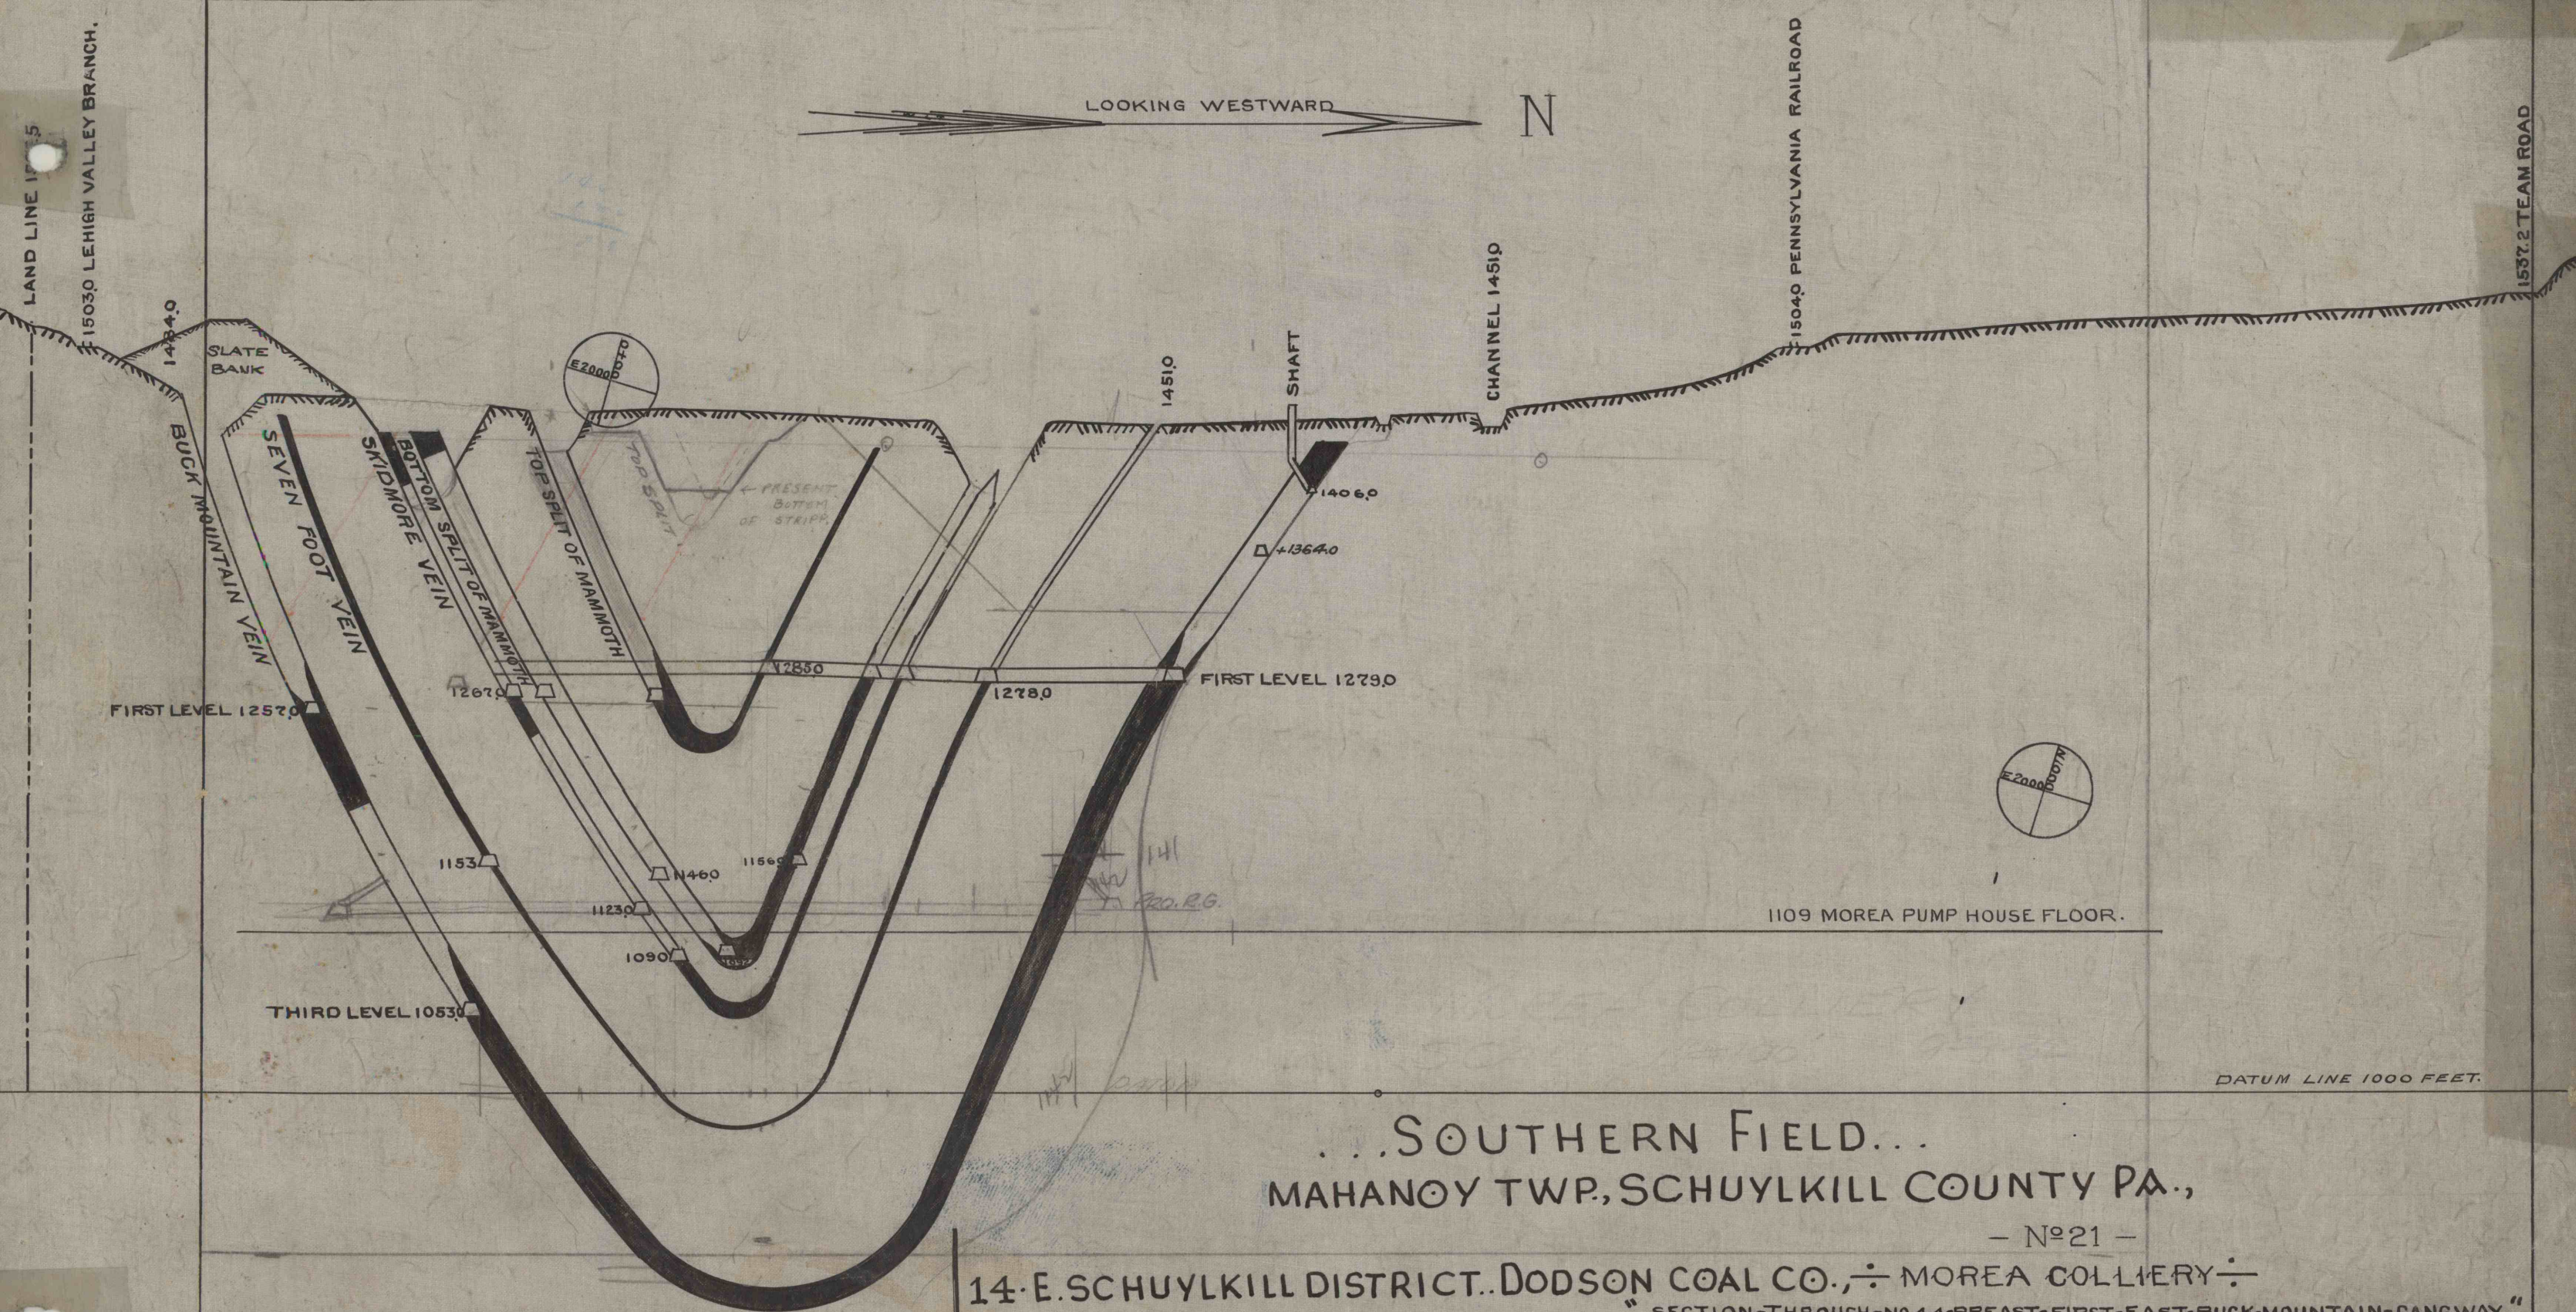

...SOUTHERN FIELD...
MAHANOTWP, SCHUYLKILL COUNTY PA.,

- No 21 -

14 E. SCHUYLKILL DISTRICT. DODSON COAL CO., ÷ MOREA COLLIERY ÷

"SECTION THROUGH NO 44 BREAST, FIRST EAST BUCK MOUNTAIN GANGWAY."

MADEIRA HILL COAL CO. 9 SEPT. 1932. A.D.

SCALE: 100 FEET.