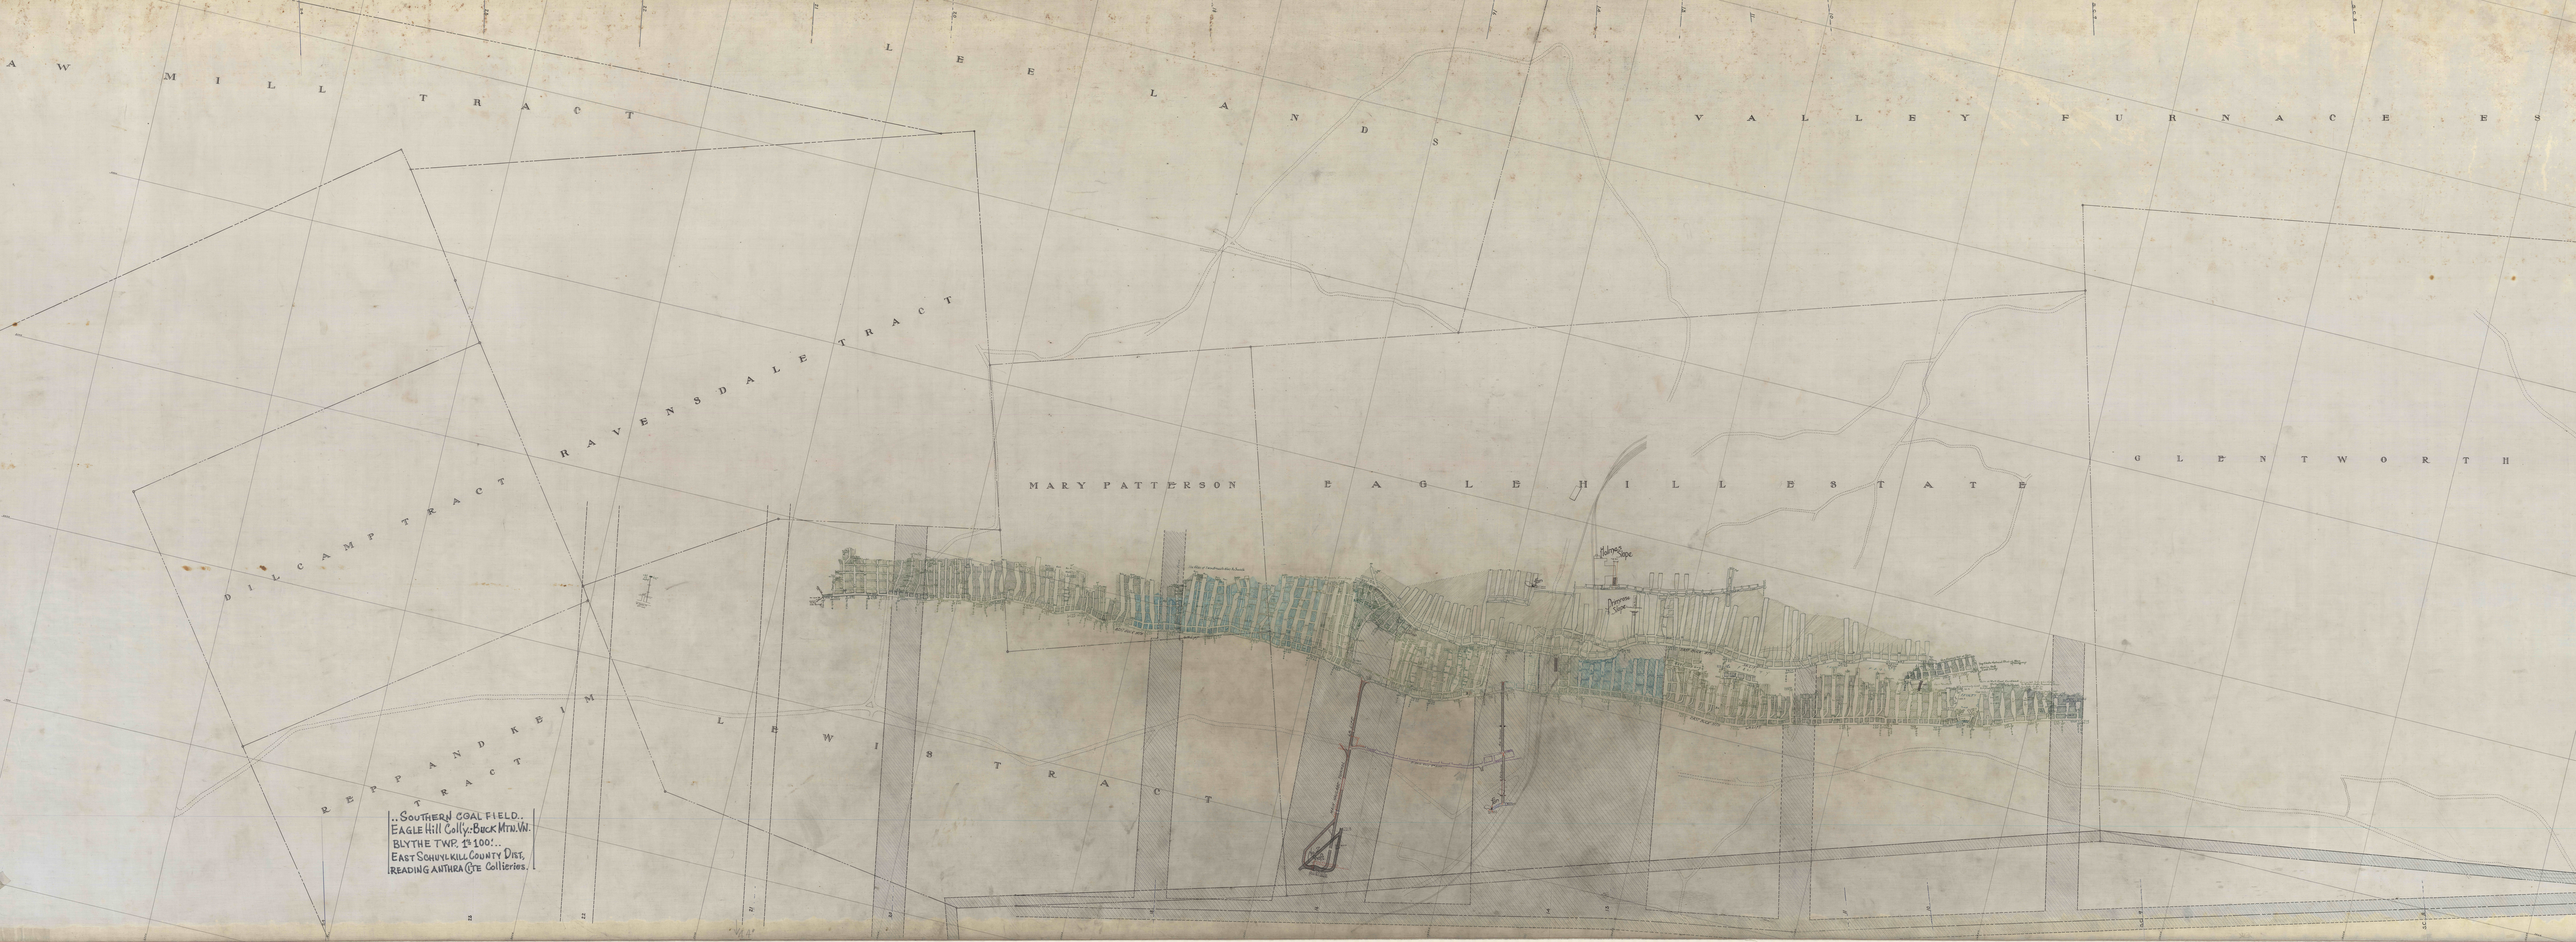
A W M I L L T R A C T
L E E L A N D S
V A L L E Y F U R N A C E E S
R A V E N S D A L E T R A C T
M A R Y P A T T E R S O N E A G L E H I L L E S T A T E
G L E N T W O R T H
D I L C A M P T R A C T
L E W I S T R A C T
R E P P A N D K E I M T R A C T
Mining Slope
Pumping Slope
..SOUTHERN COAL FIELD..
EAGLE Hill Colly:-BUCK MTN.VA.
BLYTHE TWP. 1st 100'..
EAST SCHUYLKILL COUNTY DIST,
READING ANTHRACITE Collieries.