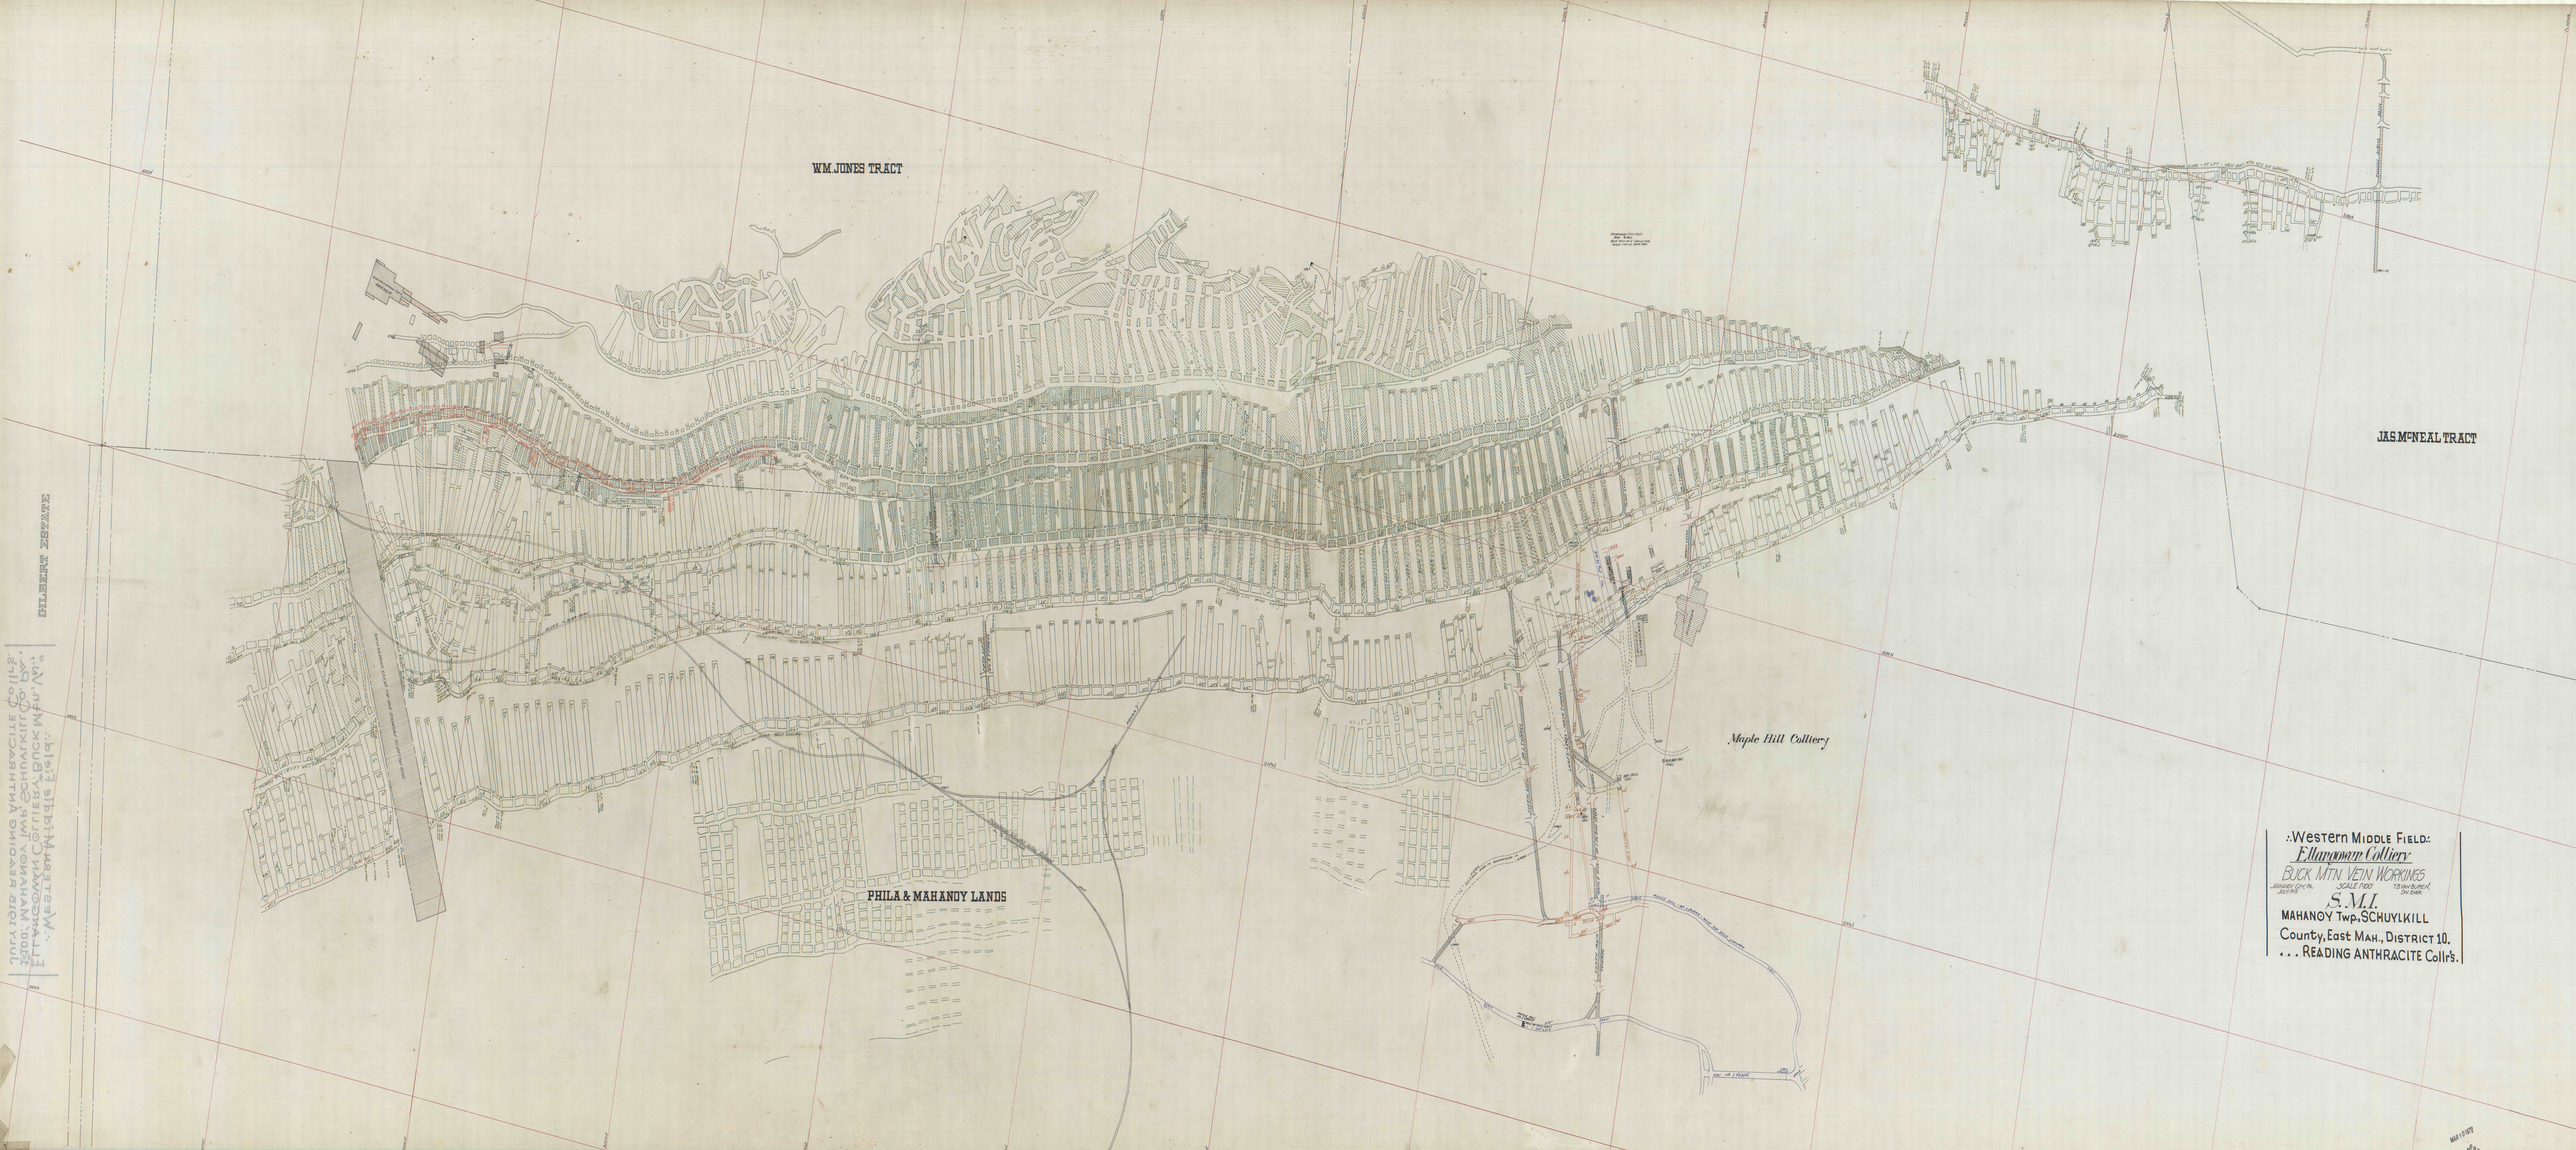

WM. JONES TRACT
GILBERT ESTATE
JAS. McNEAL TRACT
Maple Hill Colliery
PHILA & MAHANOY LANDS

:.Western Middle Field.:

Ellangowan Colliery

BUCK MTN. VEIN WORKINGS

MAHANOY CITY, PA., JULY-1915
SCALE 1"=100'
T.B. VAN BUREN, DIV. ENG'R.

S.M.I.

MAHANOY Twp., SCHUYLKILL
County, East Mah., District 10.
. . . READING ANTHRACITE Coll'r's.

MAR 10 1972