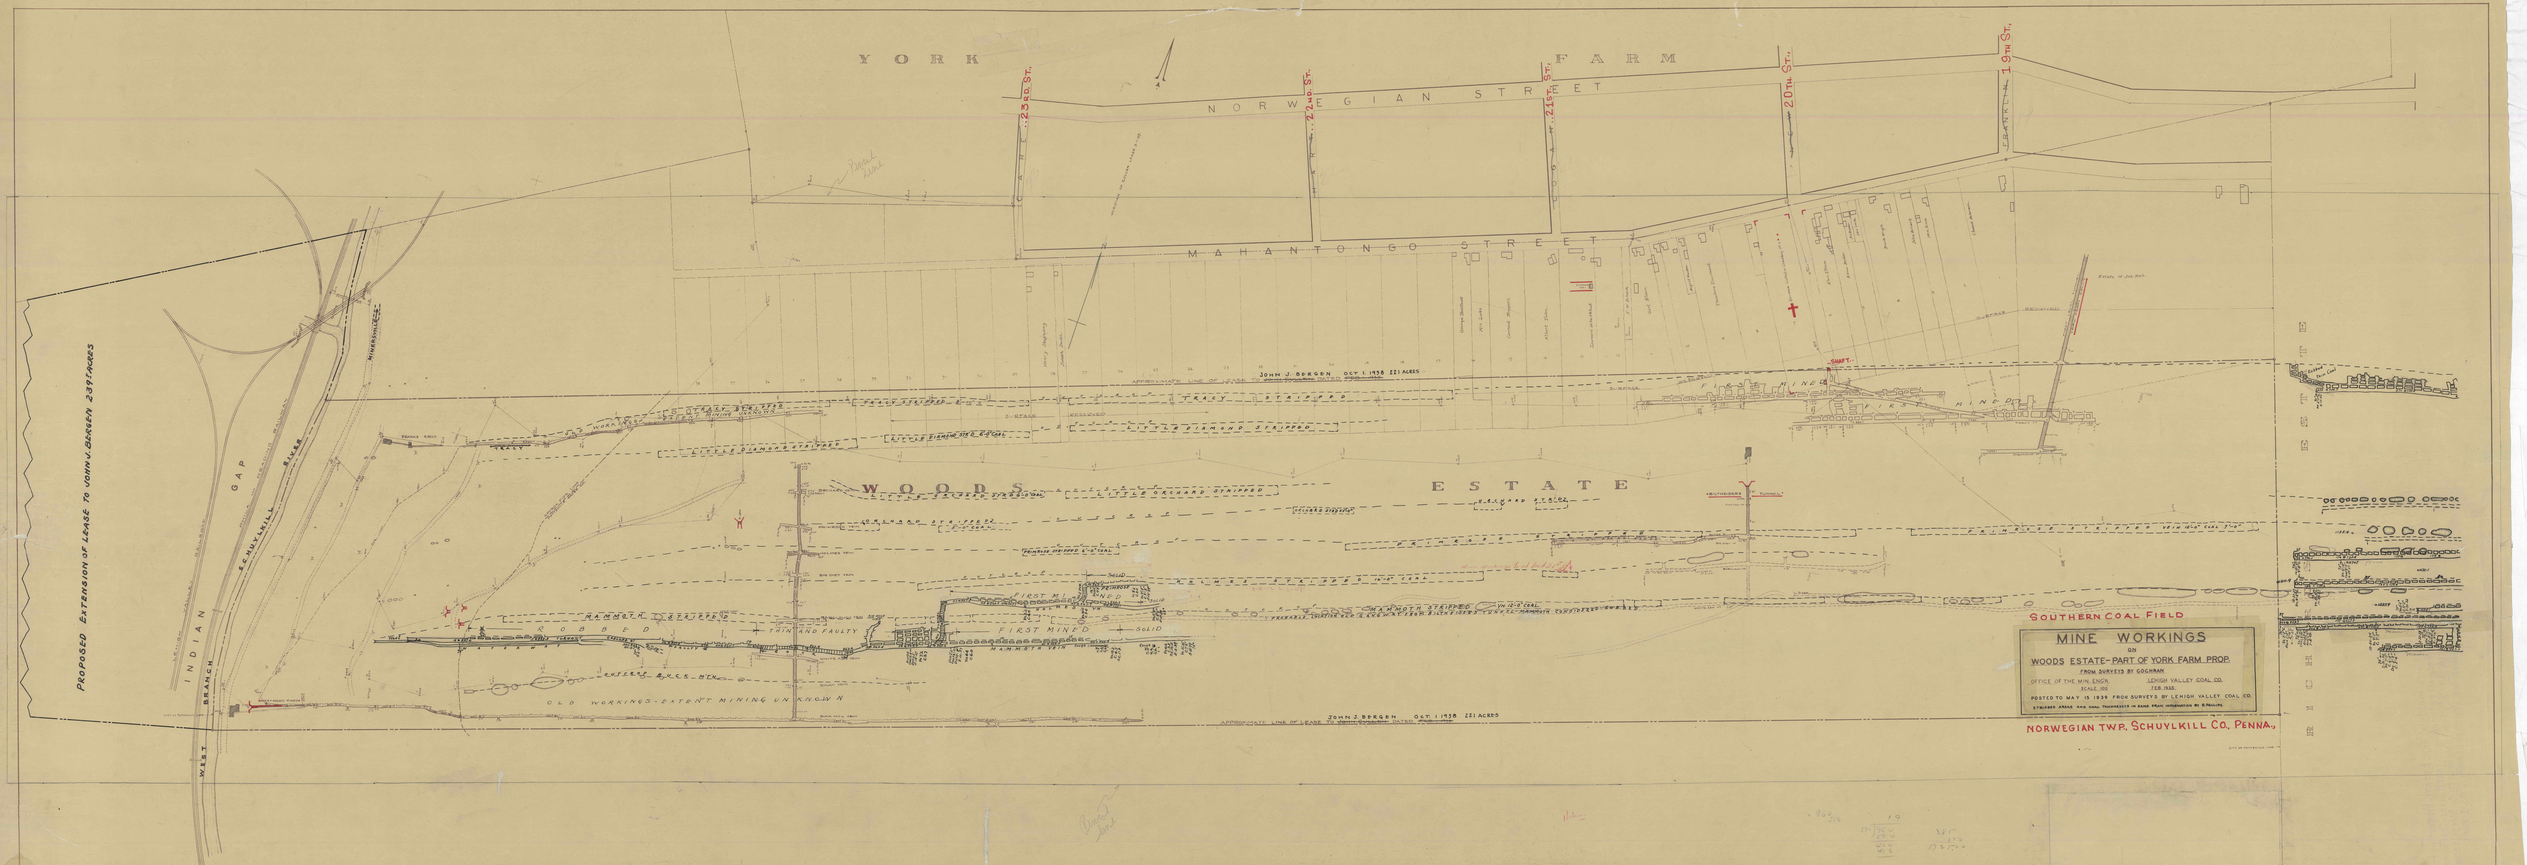
YORK FARM
NORWEGIAN STREET
MAHANTONGO STREET
23RD ST.
20TH ST.
19TH ST.
PROPOSED EXTENSION OF LEASE TO JOHN J. BERGEN 239 ACRES
INDIAN GAP
SCHUYLKILL RIVER
WEST BRANCH
WOODS ESTATE
JOHN J. BERGEN OCT. 1 1938 221 ACRES
APPROXIMATE LINE OF LEASE TO JOHN J. BERGEN OCT. 1 1938
TRACY STRIPPED
LITTLE DIAMOND STRIPPED
LITTLE DIAMOND SEAM
LITTLE DIAMOND STRIPPED
MAMMOTH STRIPPED
MAMMOTH STRIPPED ON D-D COAL
THIN AND FAULTY
FIRST MINED
SOLID
OLD WORKINGS - EXTENT MINING UNKNOWN
SHAFT
SOUTHERN COAL FIELD
MINE WORKINGS
ON
WOODS ESTATE - PART OF YORK FARM PROP.
OFFICE OF THE MIN. ENGR. LEHIGH VALLEY COAL CO.
SCALE 100
FEB. 1935
POSTED TO MAY 15 1939 FROM SURVEYS BY LEHIGH VALLEY COAL CO.
STRIPPED AREAS PER COAL TRANSFERS IN BANK MAPS COMPARED BY R. SHULTS
NORWEGIAN TWP. SCHUYLKILL CO. PENNA.