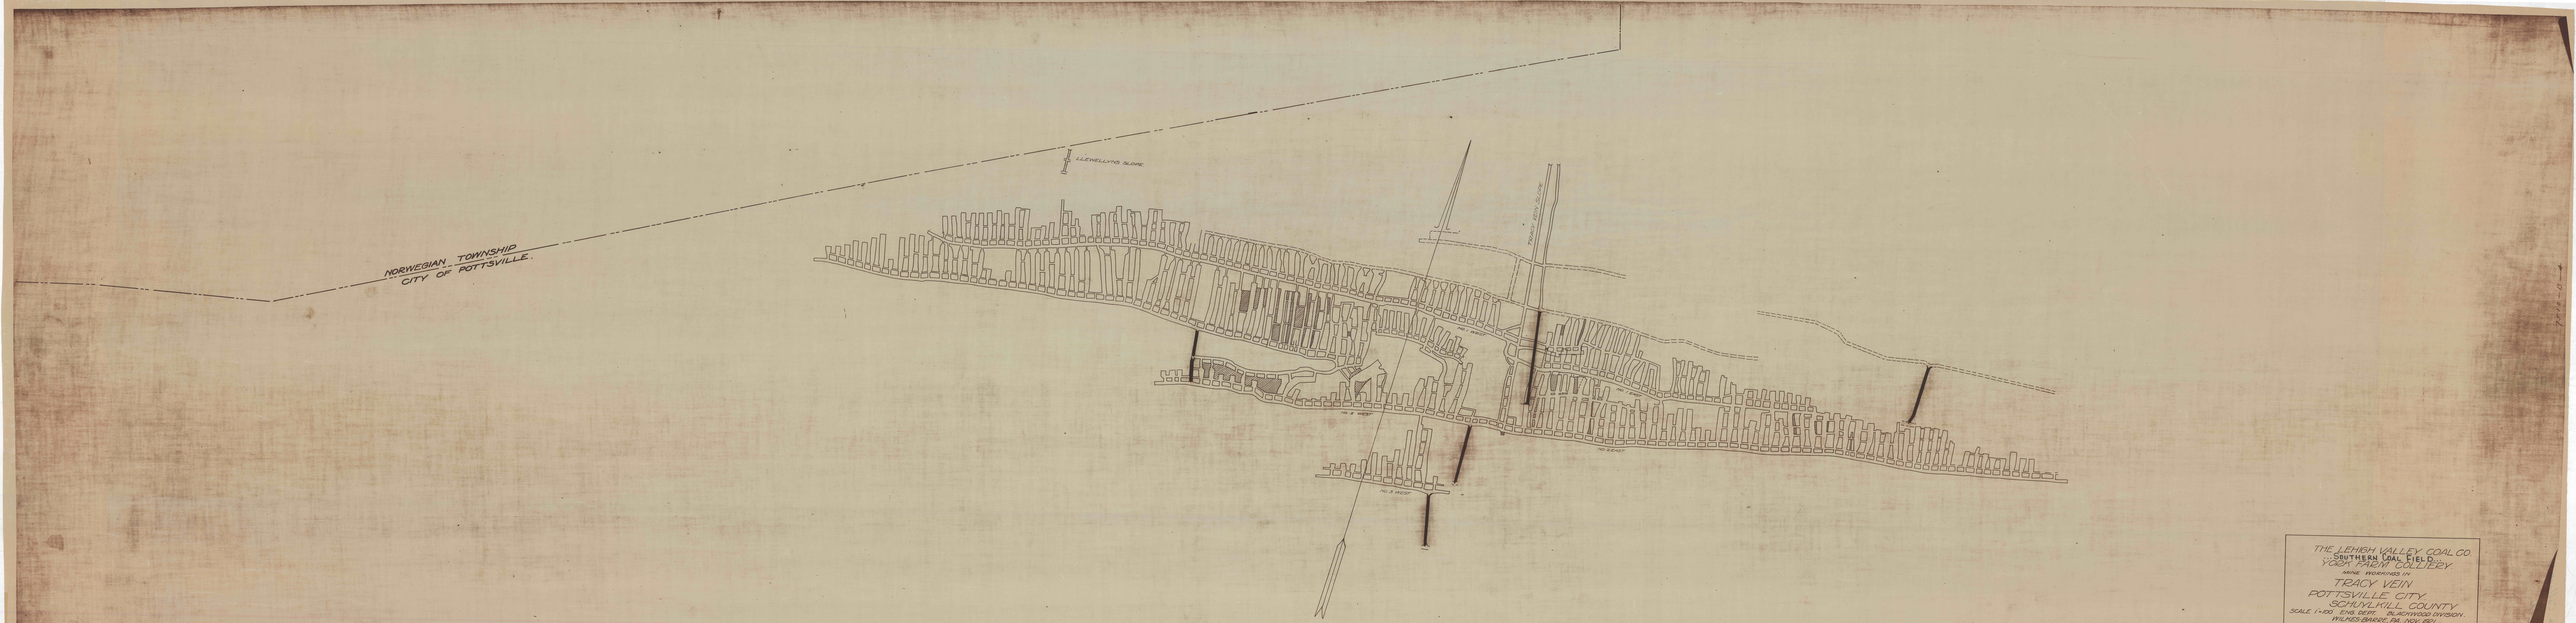


THE LEHIGH VALLEY COAL CO
SOUTHERN COAL FIELD
YORK FARM COLLIERY
MINE WORKINGS IN
TRACY VEIN
POTTSVILLE CITY
SCHUYLKILL COUNTY
SCALE 1-100 ENG. DEPT. BLACKWOOD DIVISION
WILKES-BARRE, PA. NOV. 1921


