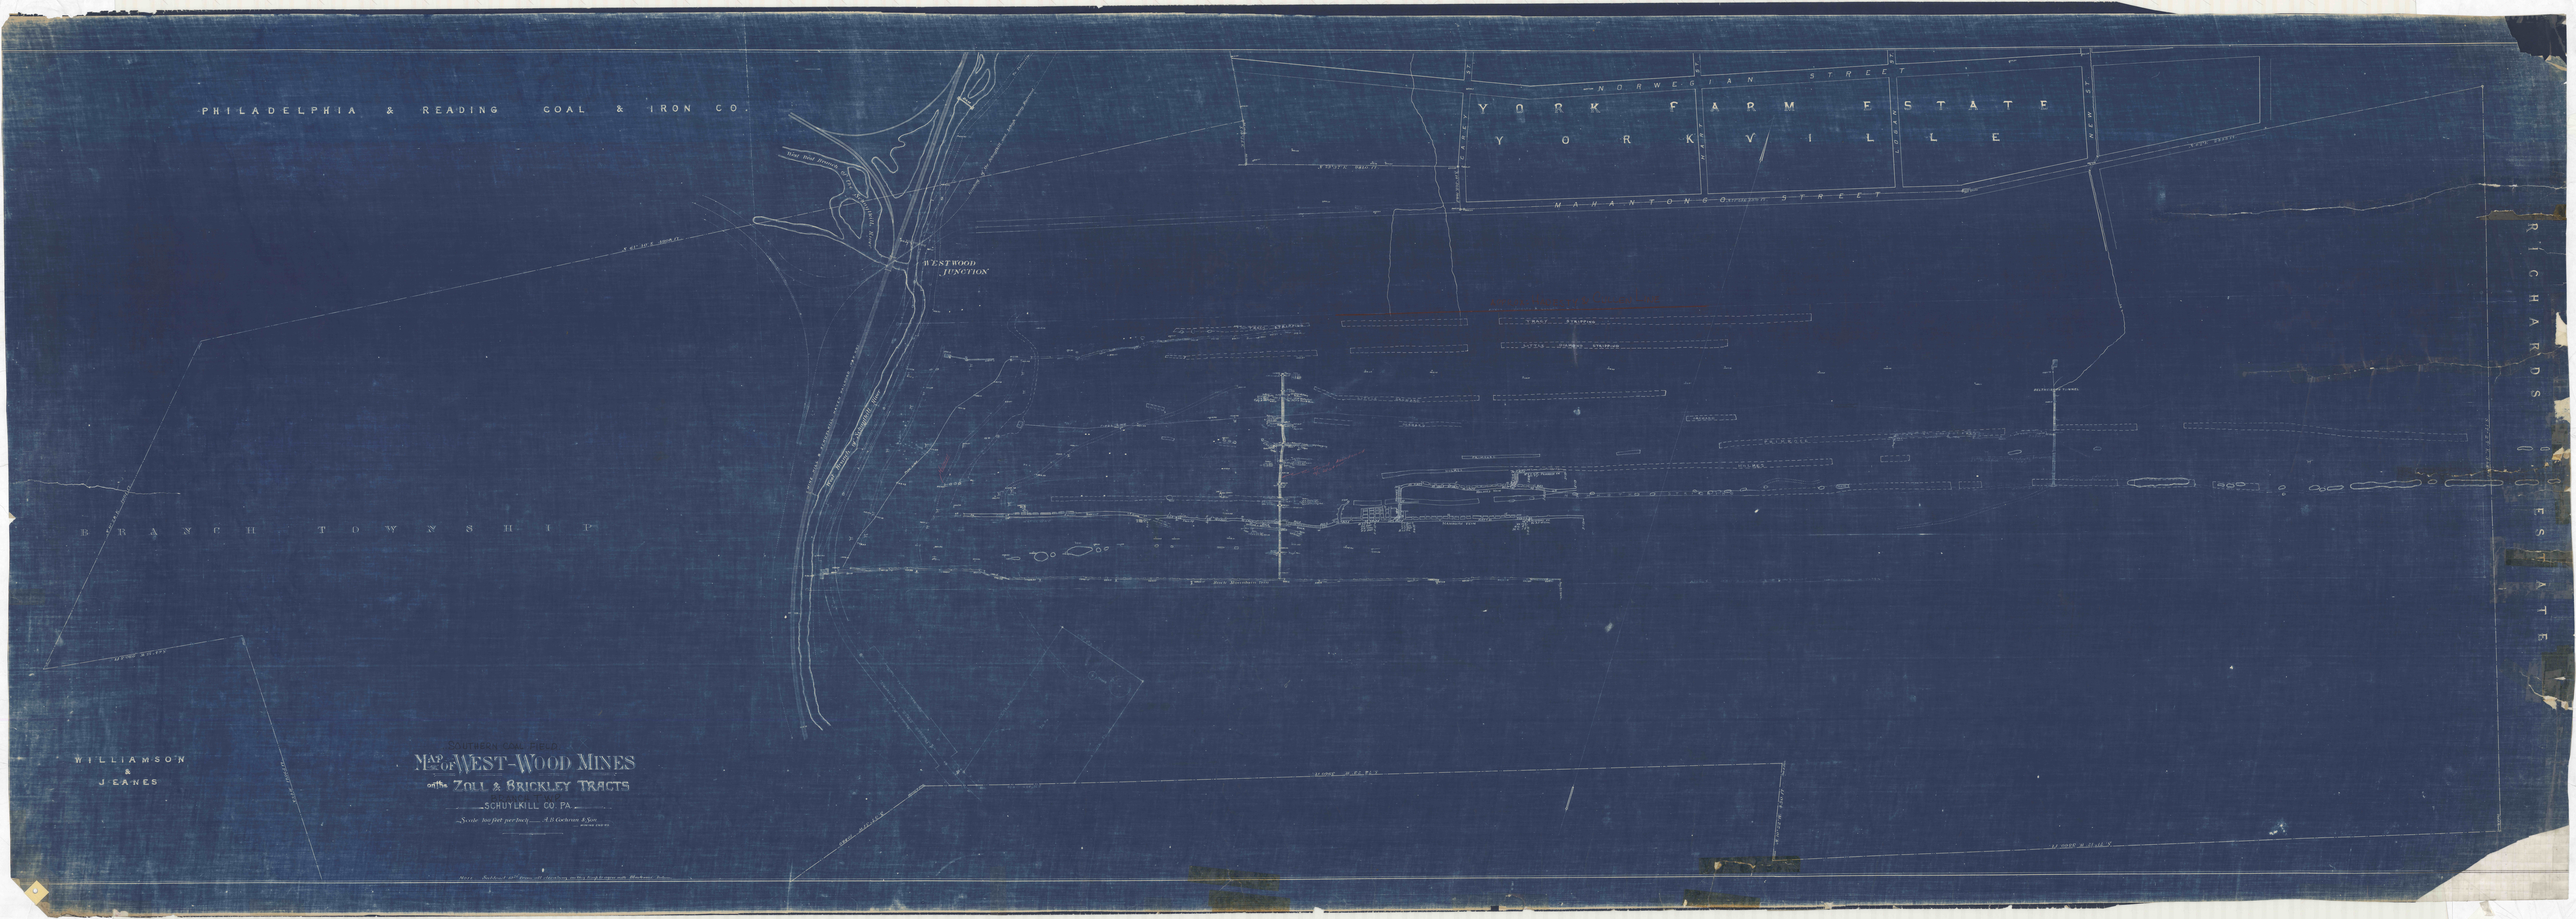
PHILADELPHIA & READING COAL & IRON CO.
BRANCH TOWNSHIP
WILLIAMSON & JEANES
WESTWOOD JUNCTION
YORK FARM ESTATE
YORK VILLE
NORWEGIAN STREET
MANANTONGO STREET
RICHARDS ESTATE
Map of WEST-WOOD MINES on the ZOLL & BRICKLEY TRACTS
SCHUYLKILL CO. PA.
Scale 100 feet per inch. A.B. Gehman & Son