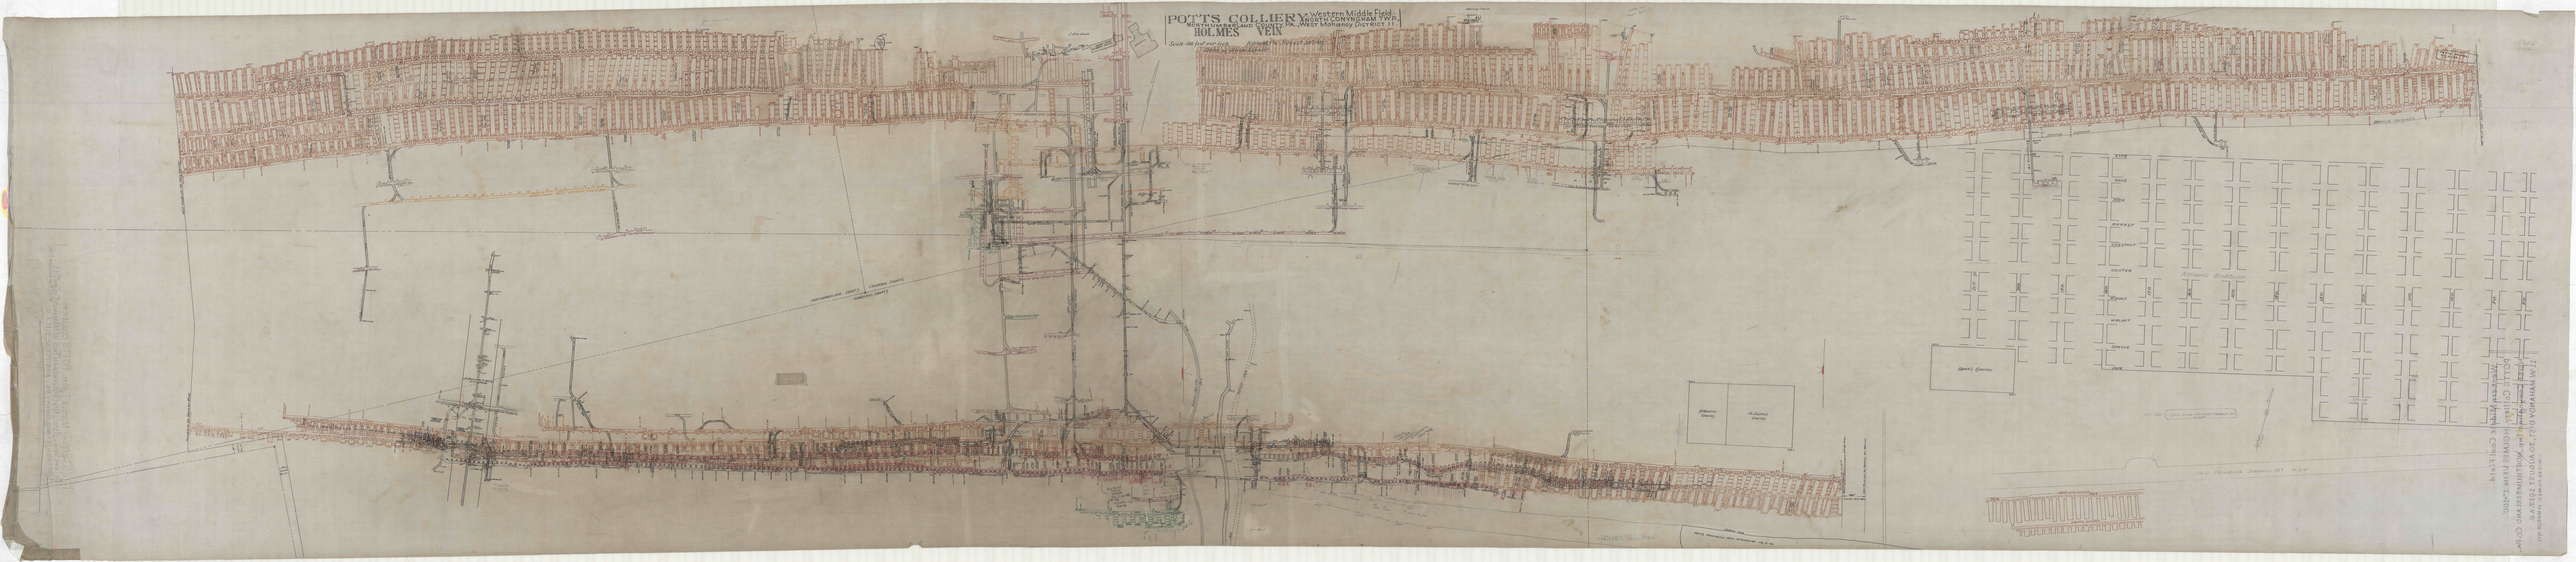

POTTS COLLIERY
Western Middle Field
North Conyngham Twp.
West Mahanoy District
HOLMES VEIN
Scale 100 feet per inch
Surface Plan
Original Survey
