


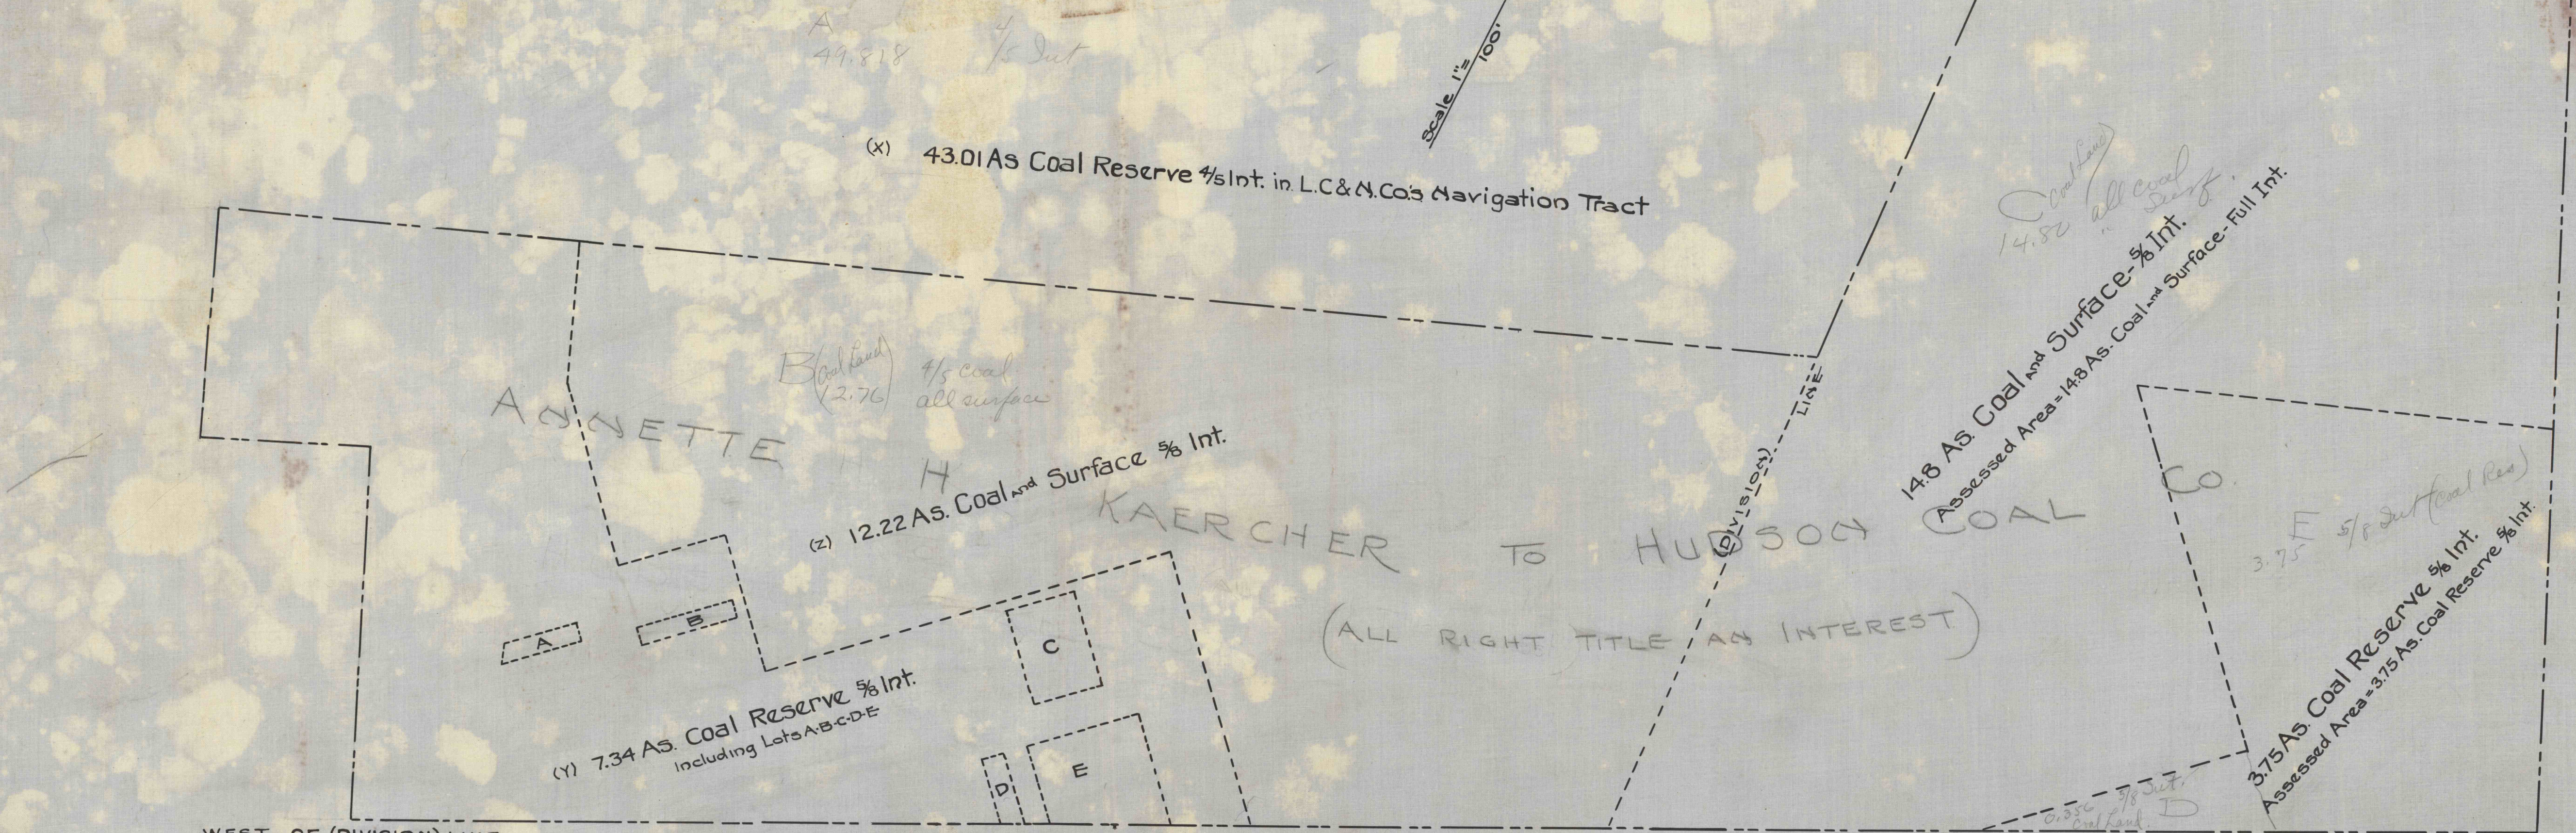

(X) 43.01 As. Coal Reserve on L.C. & N. Co's Navigation Tract $\frac{4}{5}$ Int.
 (Y) + 7.34 As. " " " " Farnum and McGinnis Tract $\frac{5}{8}$ Int.
 50.35 As.

- 61.4 As. Area of Lots A-B-C-D-E
 { 49.736 As. Actual Area of Coal Reserve
 { 49.85 As. Assessed Area of Coal Reserve Full Int.

(Z) 12.22 As. Coal and Surface
 61.4 As. Area of Lots A-B-C-D-E
 { 12.836 As. Actual Area of Coal and Surface
 { 12.76 As. Assessed Area of Coal and Surface $\frac{5}{8}$ Int.

{ 0.614 As. Actual Area of Coal and Surface in Lots A-B-C-D-E
 { 0.386 As. Assessed Area $\frac{5}{8}$ Int.

EAST OF (DIVISION) LINE
 { 18.85 As. Assessed in City East of E. Line of Kaercher Tract (Not in this Computation)
 { 14.80 As. Coal and Surface $\frac{5}{8}$ Int.
 { 14.80 As. Assessed Area of Coal and Surface Full Int.

{ 3.75 As. Coal Reserve $\frac{5}{8}$ Int.
 { 3.75 As. Assessed Area of Coal Reserve $\frac{5}{8}$ Int.

Note: Data on this map is incorrect (B.M.)

HUDSON COAL CO.	
OFFICE OF DIV. ENG. POTTSVILLE, PA.	
Sketch Showing Portion of Ownership Of L.C. & N. Co. in First and Sixth Ward as Offered for Sale about Oct. 1922 Also L.C. & N. Co. Assessments of 1924	
SCHUYLKILL COUNTY PENNA	
Scale 1" = 100'	Jan. 1925
No 1220 S.W. 39	Draw No. 24