


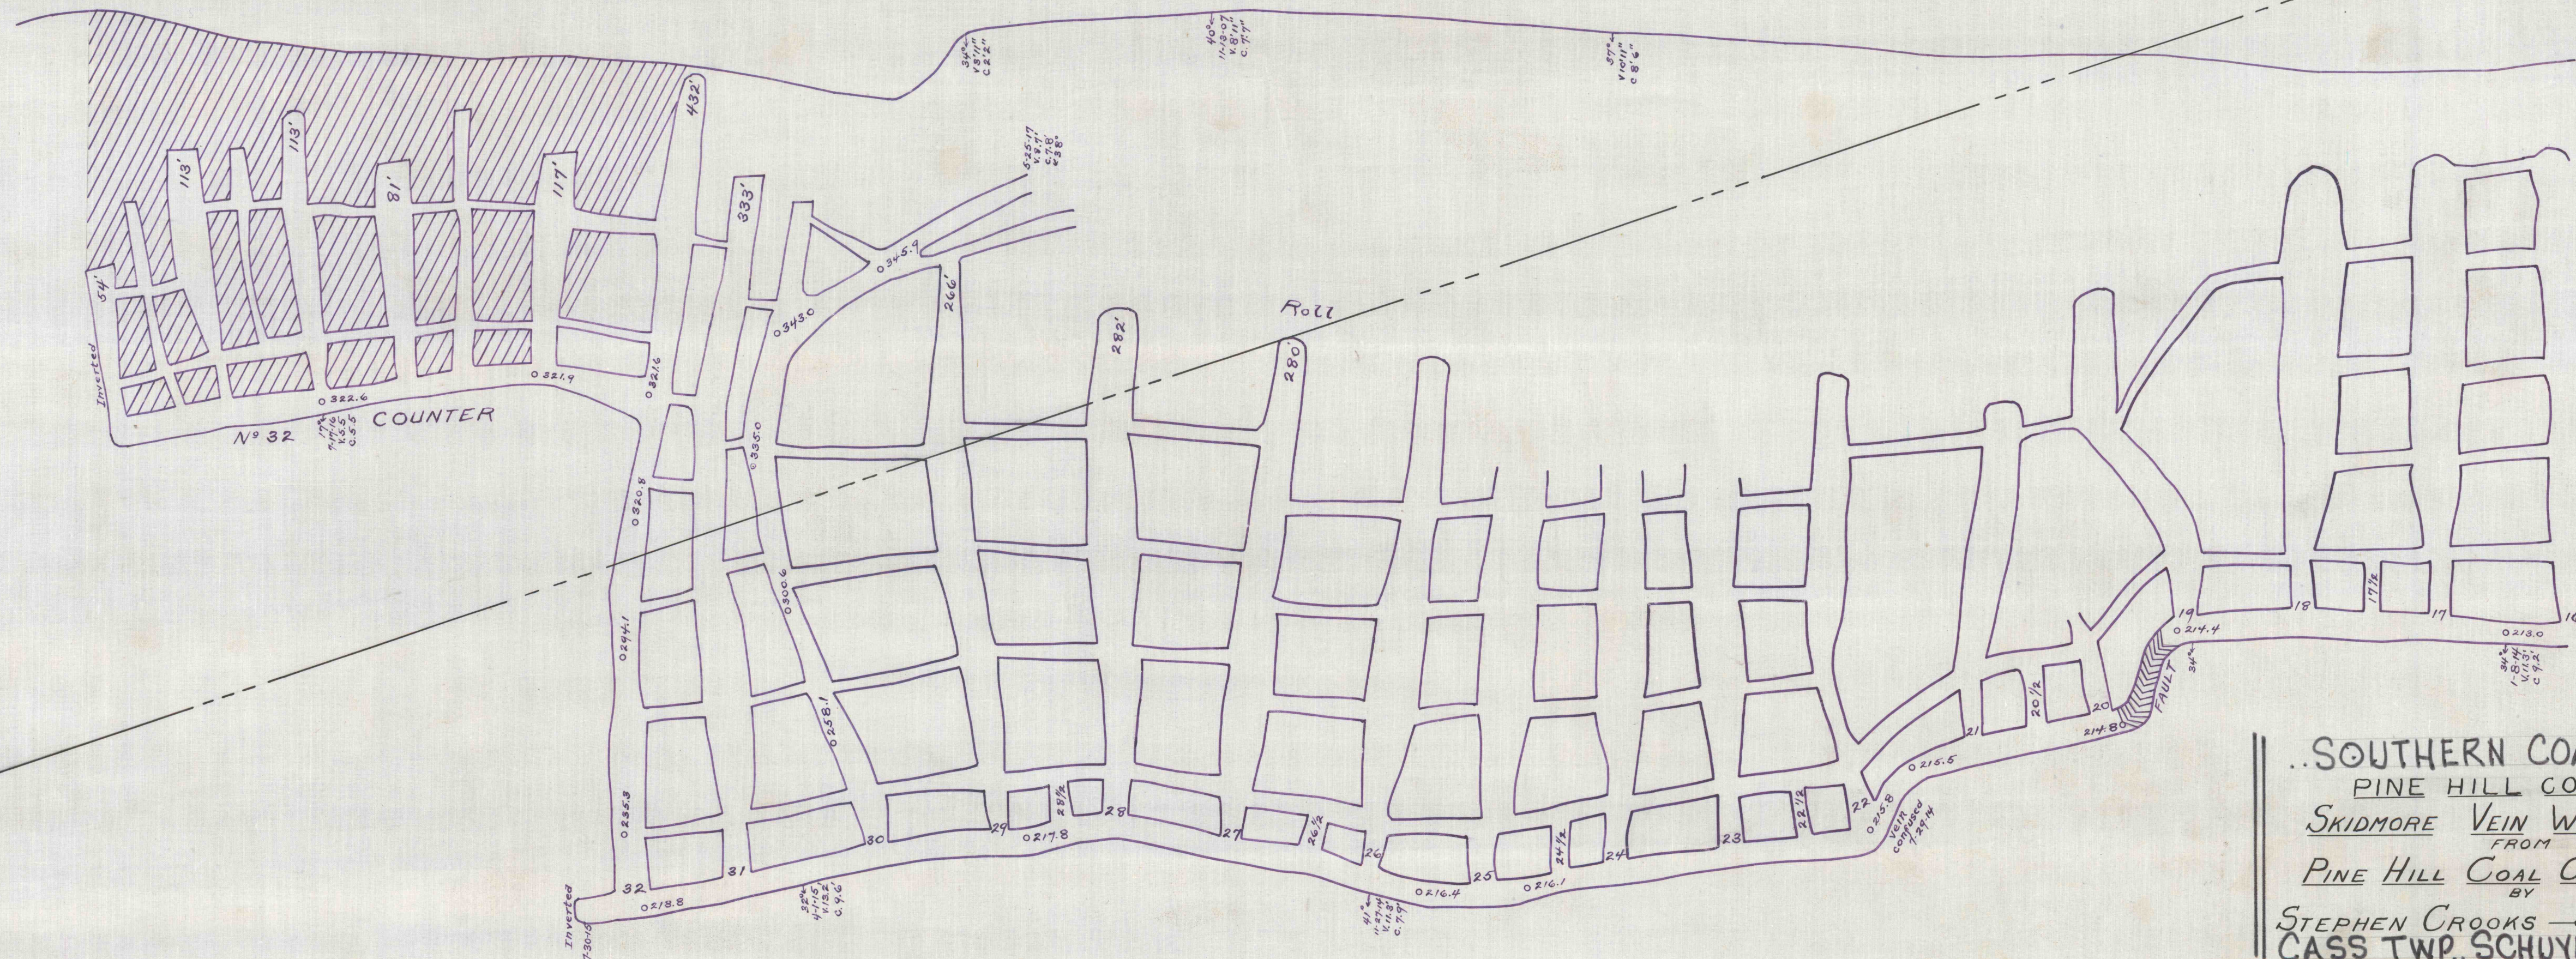

..SOUTHERN COAL FIELD..
 PINE HILL COLLIERY
 SKIDMORE VEIN WORKINGS
 FROM
 PINE HILL COAL CO'S WORKINGS
 BY
 STEPHEN CROOKS — JUNE 29-1917.
 CASS TWP., SCHUYLKILL COUNTY