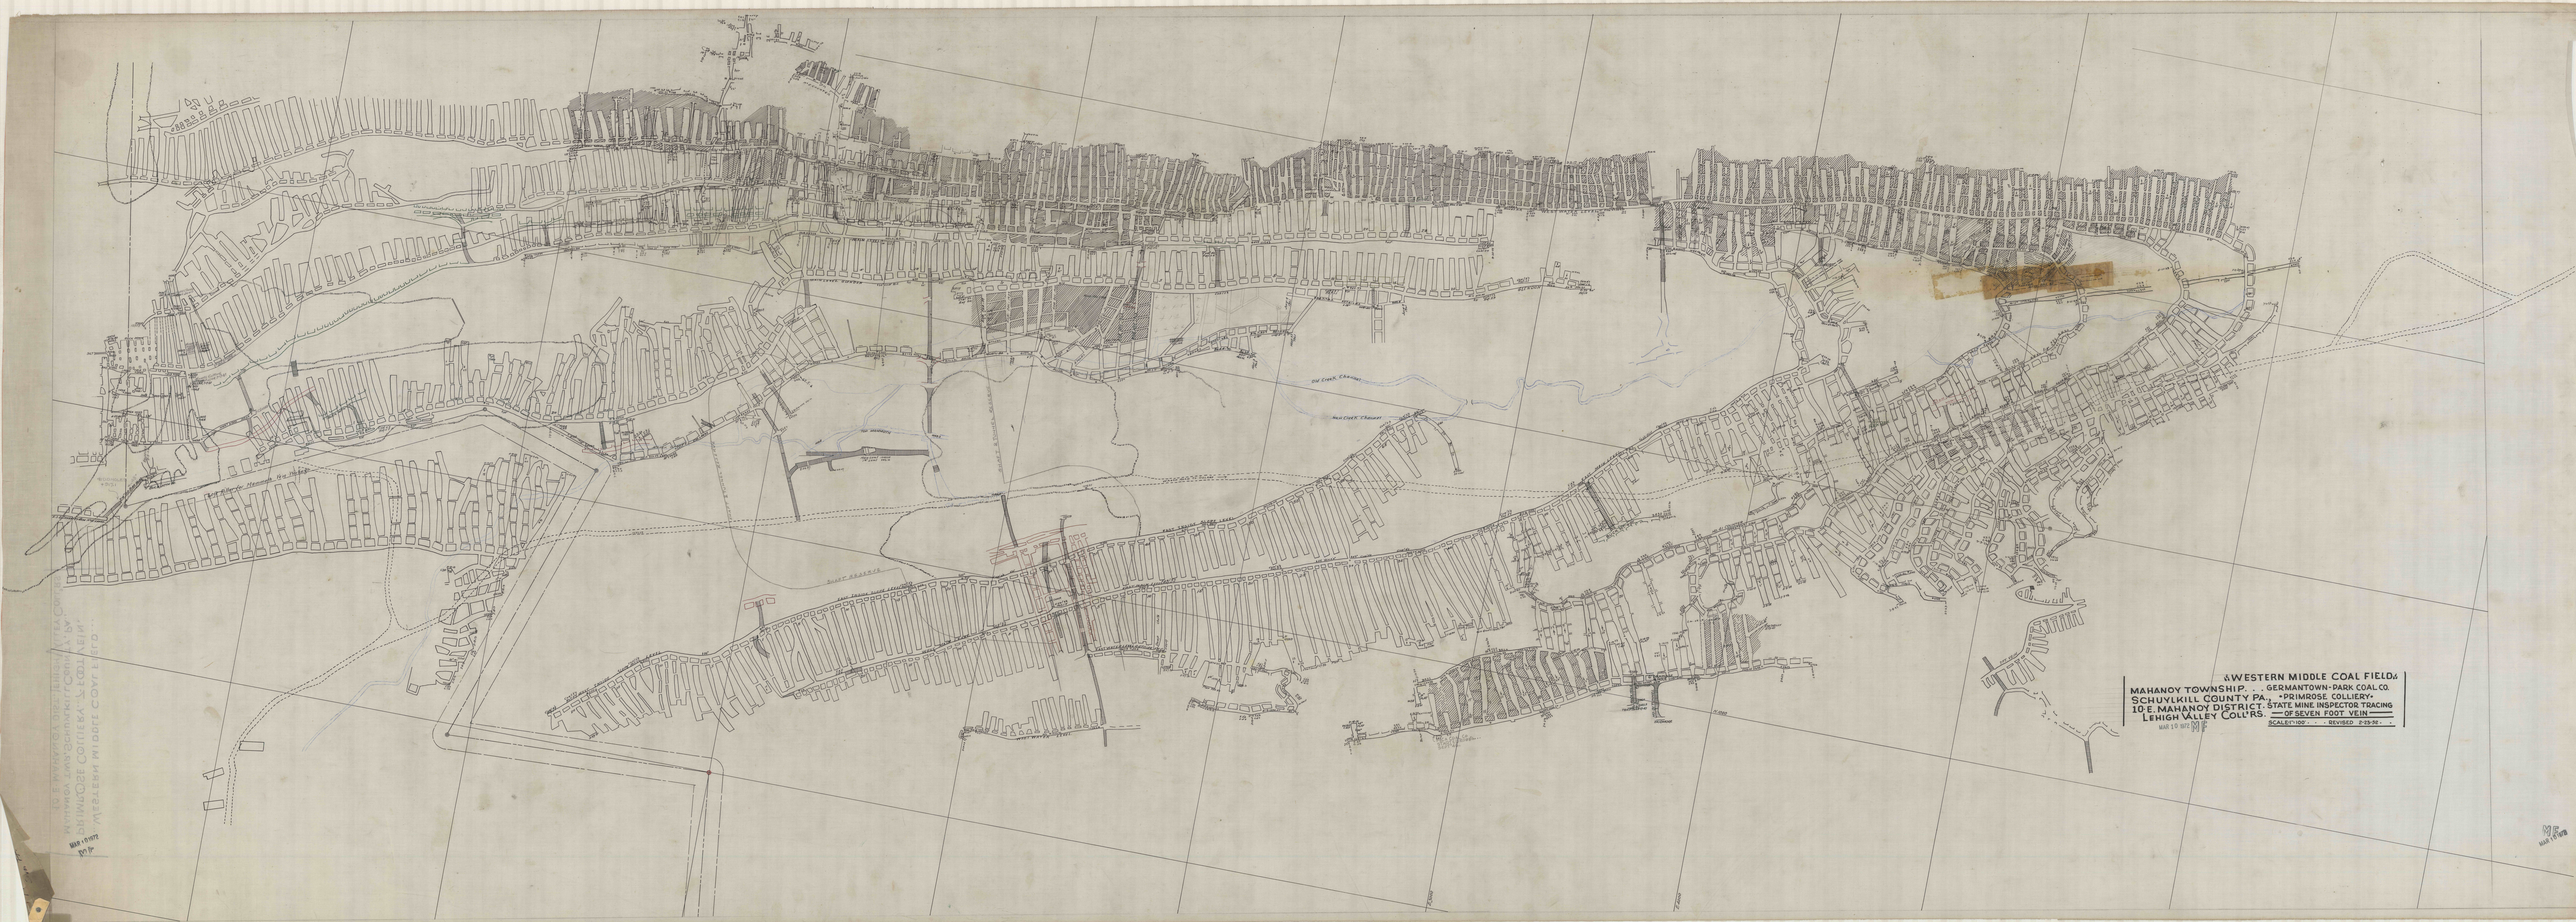

WESTERN MIDDLE COAL FIELD
MAHANOY TOWNSHIP. . . GERMANTOWN-PARK COAL CO.
SCHUYLKILL COUNTY PA. "PRIMROSE COLLIERY"
10 E. MAHANOY DISTRICT. STATE MINE INSPECTOR TRACING
LEHIGH VALLEY COAL CO'S. OF SEVEN FOOT VEIN
SCALE 1"=100' REVISED 7-23-32