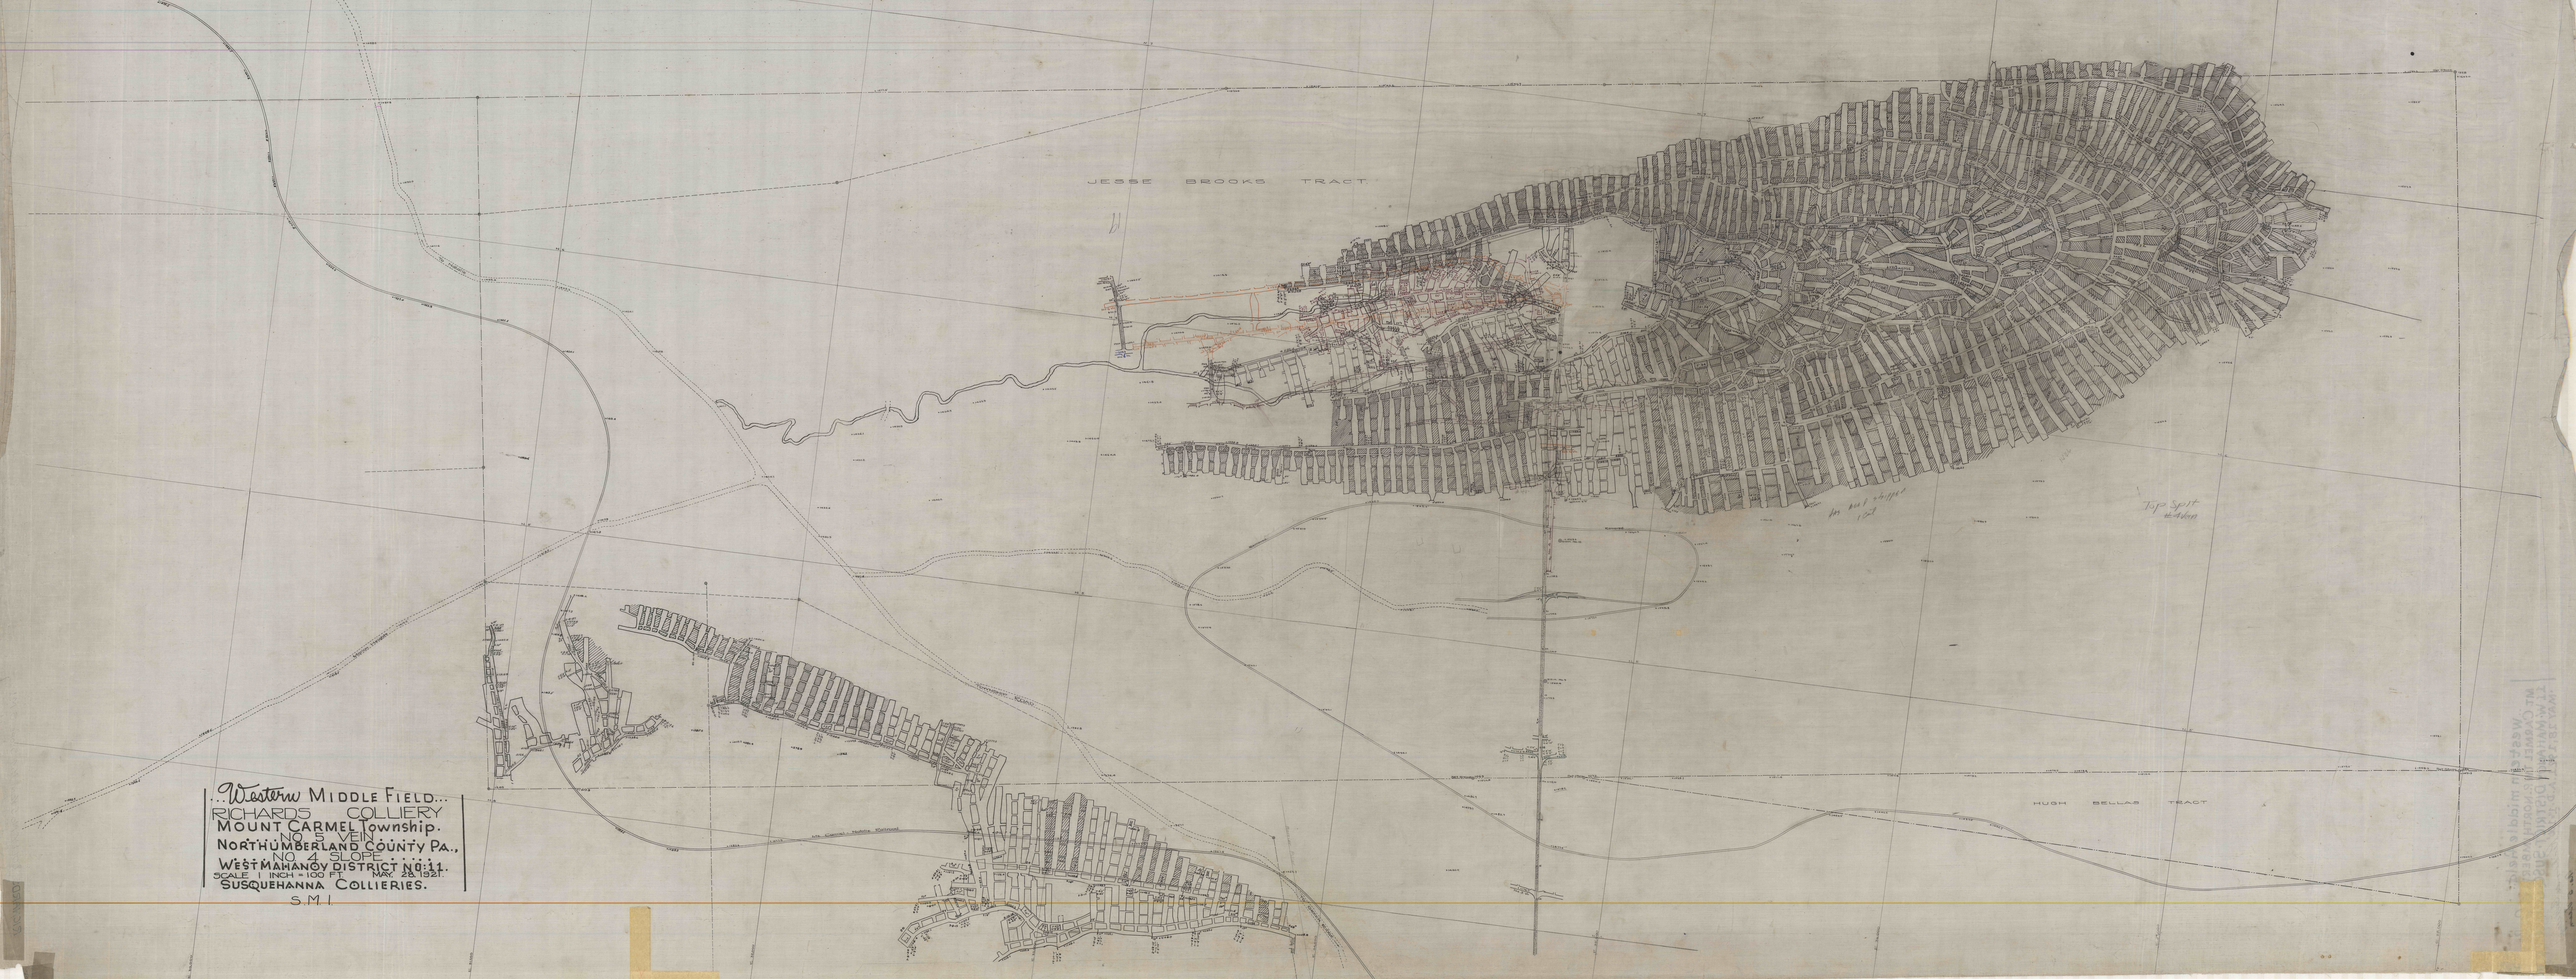

JESSE BROOKS TRACT
HUGH BELLAS TRACT
Top Split
Western MIDDLE FIELD...
RICHARDS COLLIERY
MOUNT CARMEL Township.
NO 5 VEIN
NORTHUMBERLAND COUNTY PA.,
NO 4 SLOPE
WEST MAHANOY DISTRICT NO 11.
SCALE 1 INCH = 100 FT. MAY 28 1921.
SUSQUEHANNA COLLIERIES.
S.M.I.