


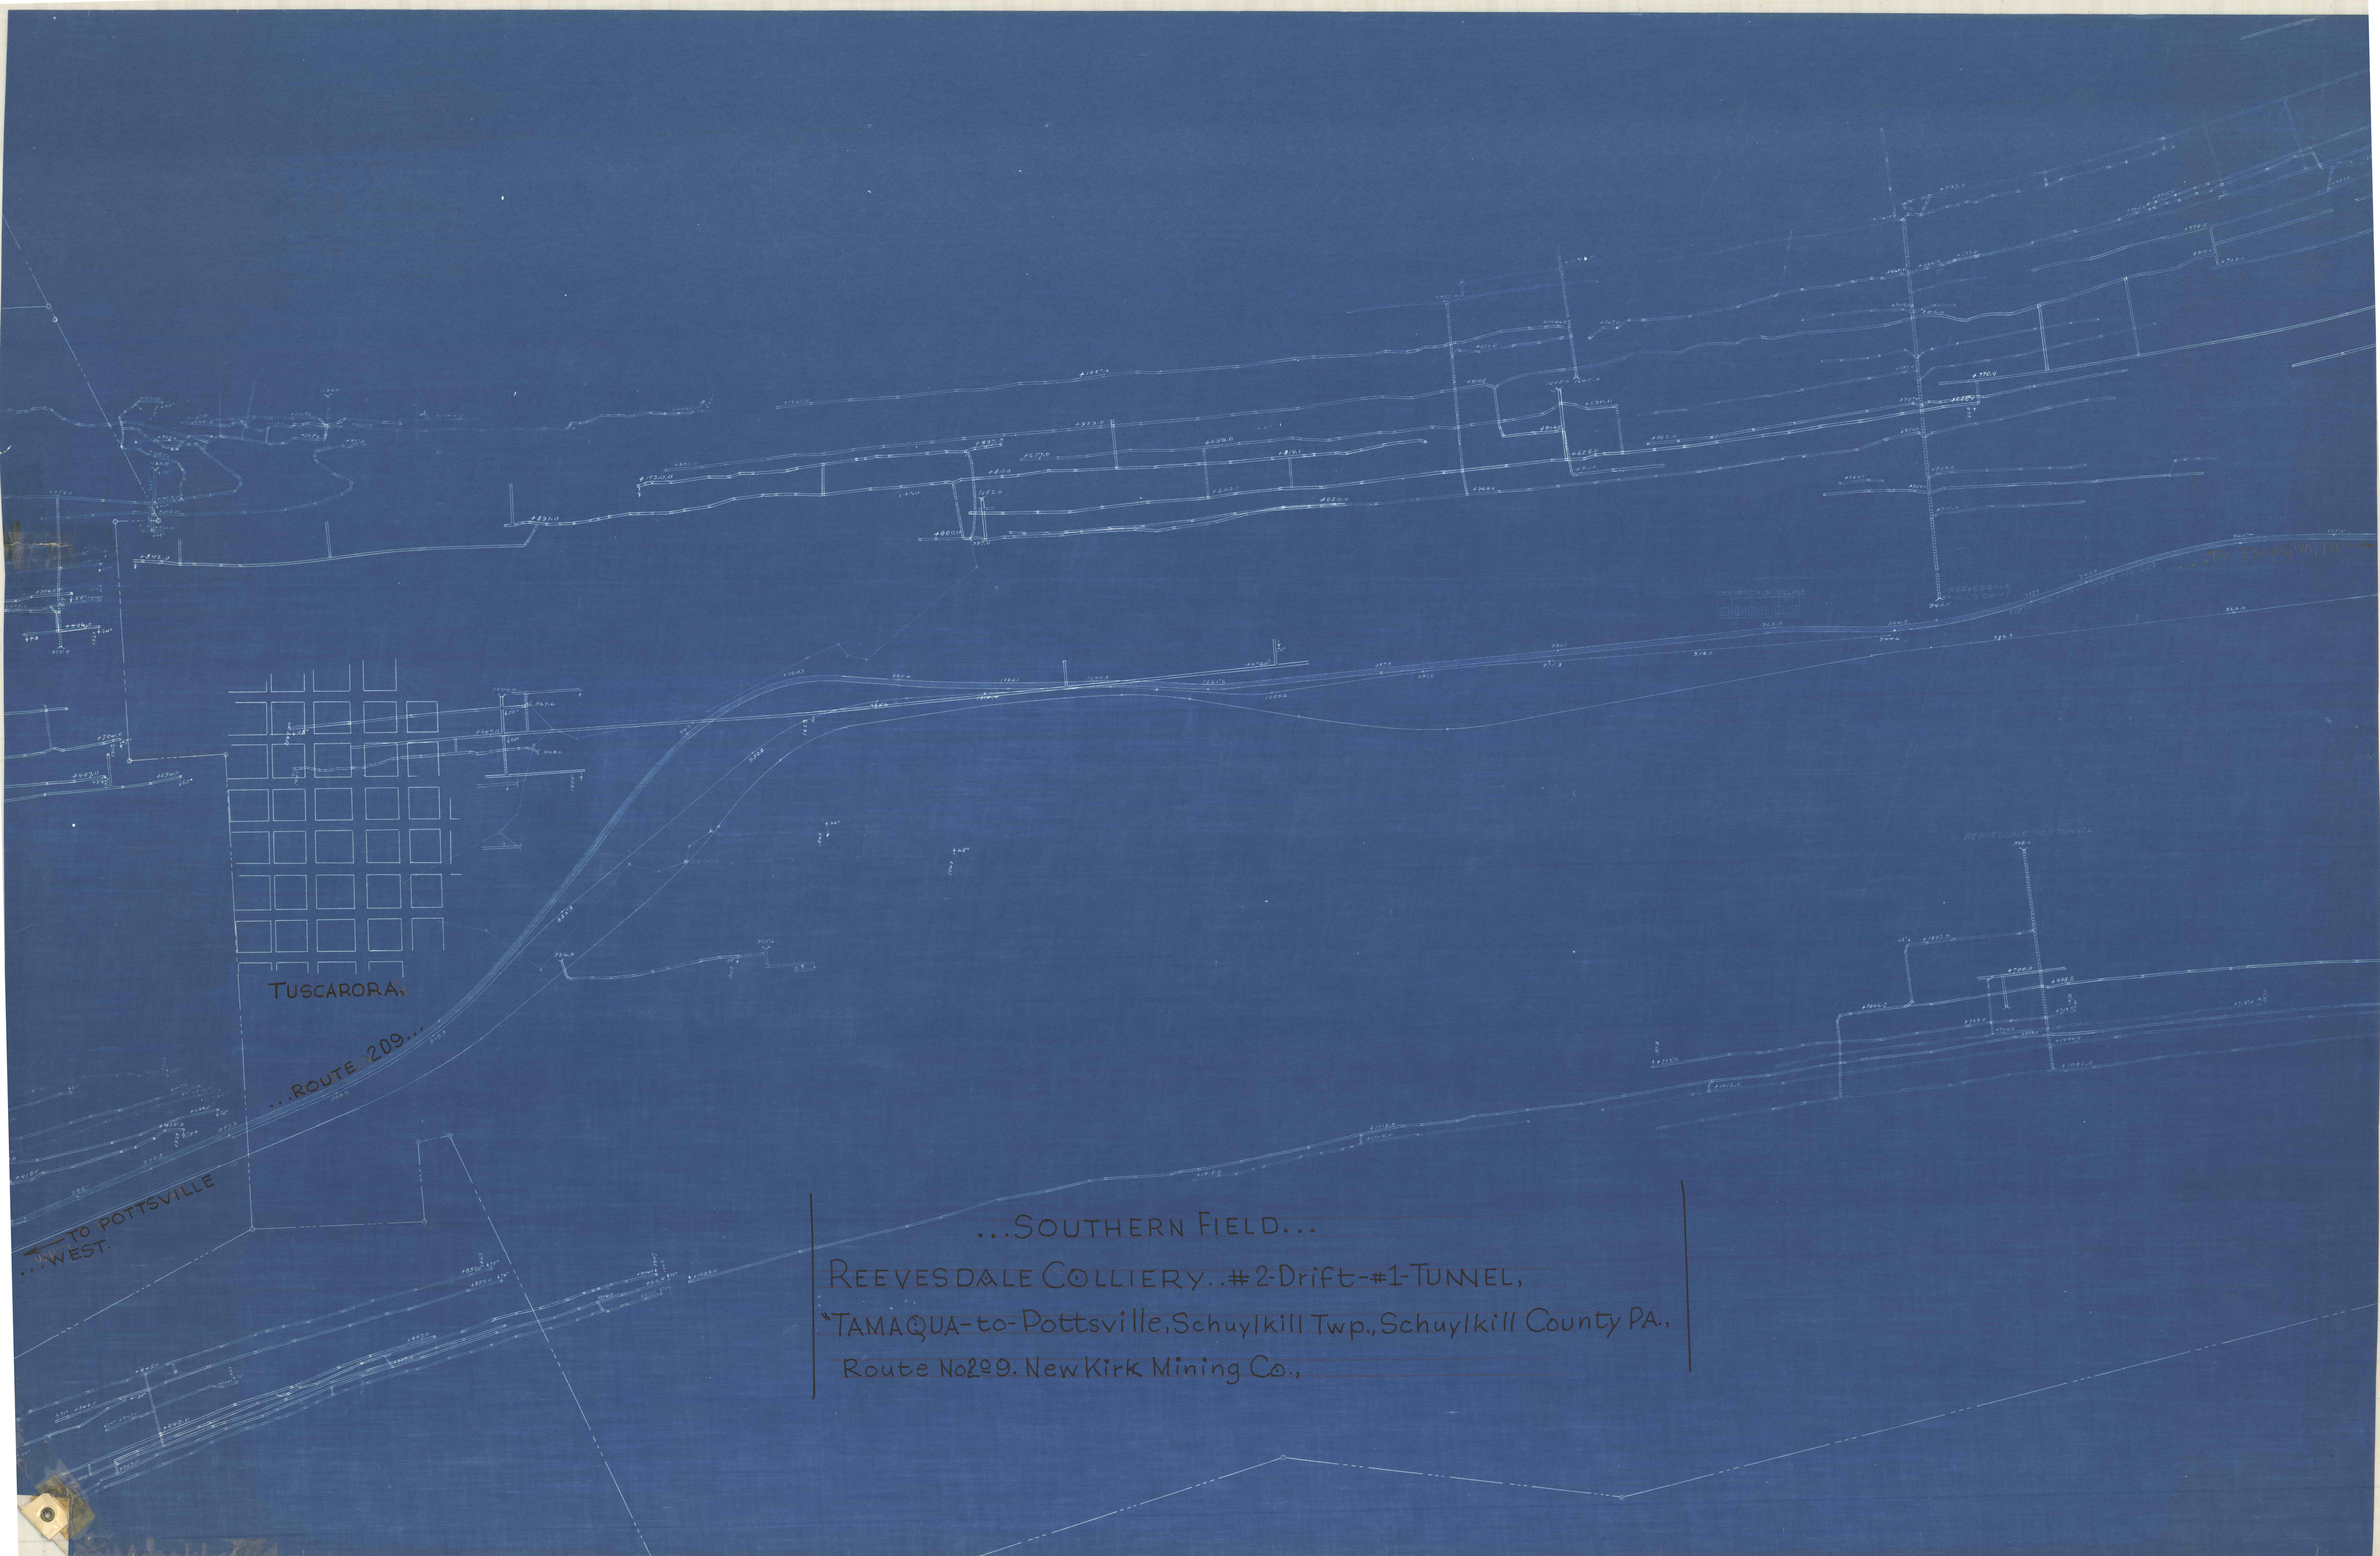

TUSCARORA

...ROUTE 209...

TO POTTSVILLE
WEST

...SOUTHERN FIELD...

REEVESDALE COLLIERY..#2-Drift-#1-TUNNEL,
TAMAQUA-to-Pottsville,Schuylkill Twp.,Schuylkill County PA.,
Route No209. New Kirk Mining Co.,

TO TAMAQUA, PA.

REEVESDALE NO. 1 TUNNEL