


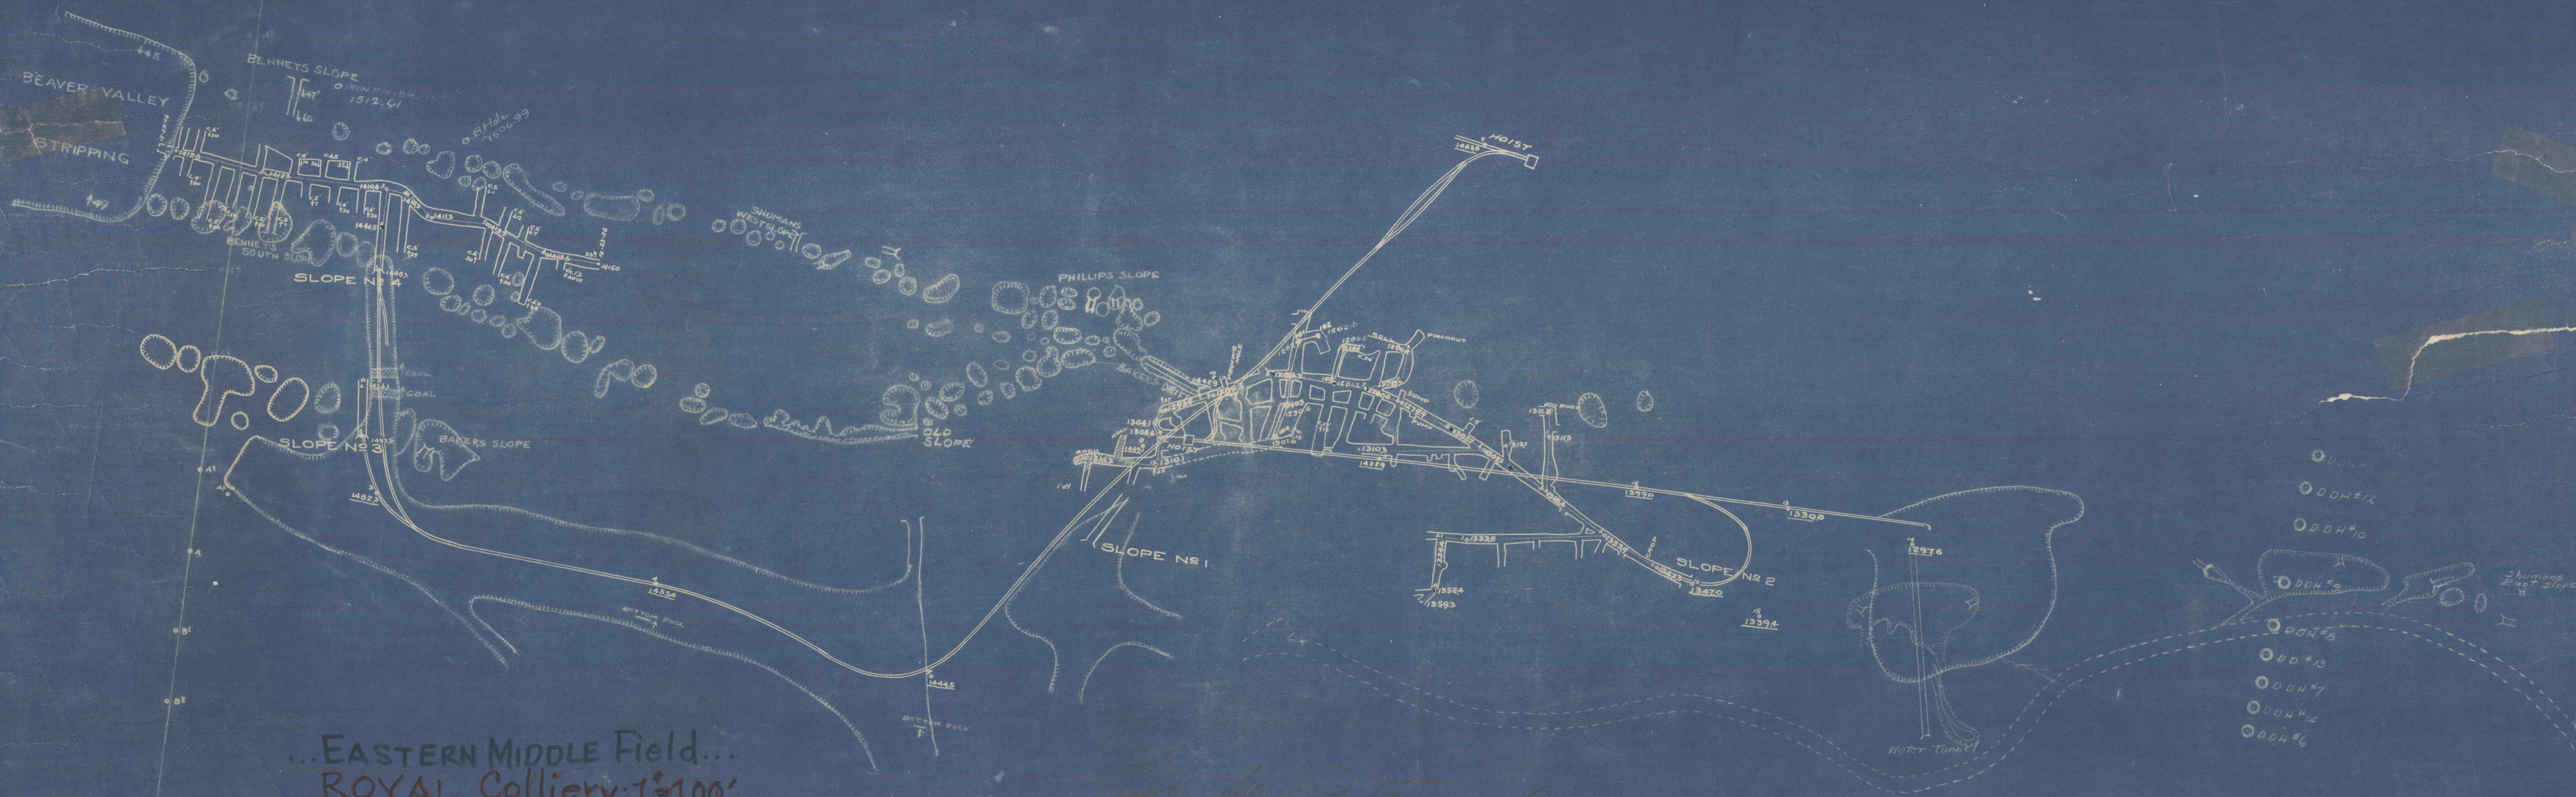

...EASTERN MIDDLE Field...
ROYAL Colliery: 1-100'
BUCK MTN. VN. / CABIN Creek,
BEAVER TOWNSHIP, COLUMBIA COUNTY, SCOTCH
VALLEY PA.,

Is a part of the
Mountain Grove Coal Co.
MOUNTAIN GROVE COAL CO.

000H#1
000H#2
000H#3
000H#4
000H#5
000H#6
000H#7
000H#8
000H#9
000H#10
000H#11
000H#12
000H#13
