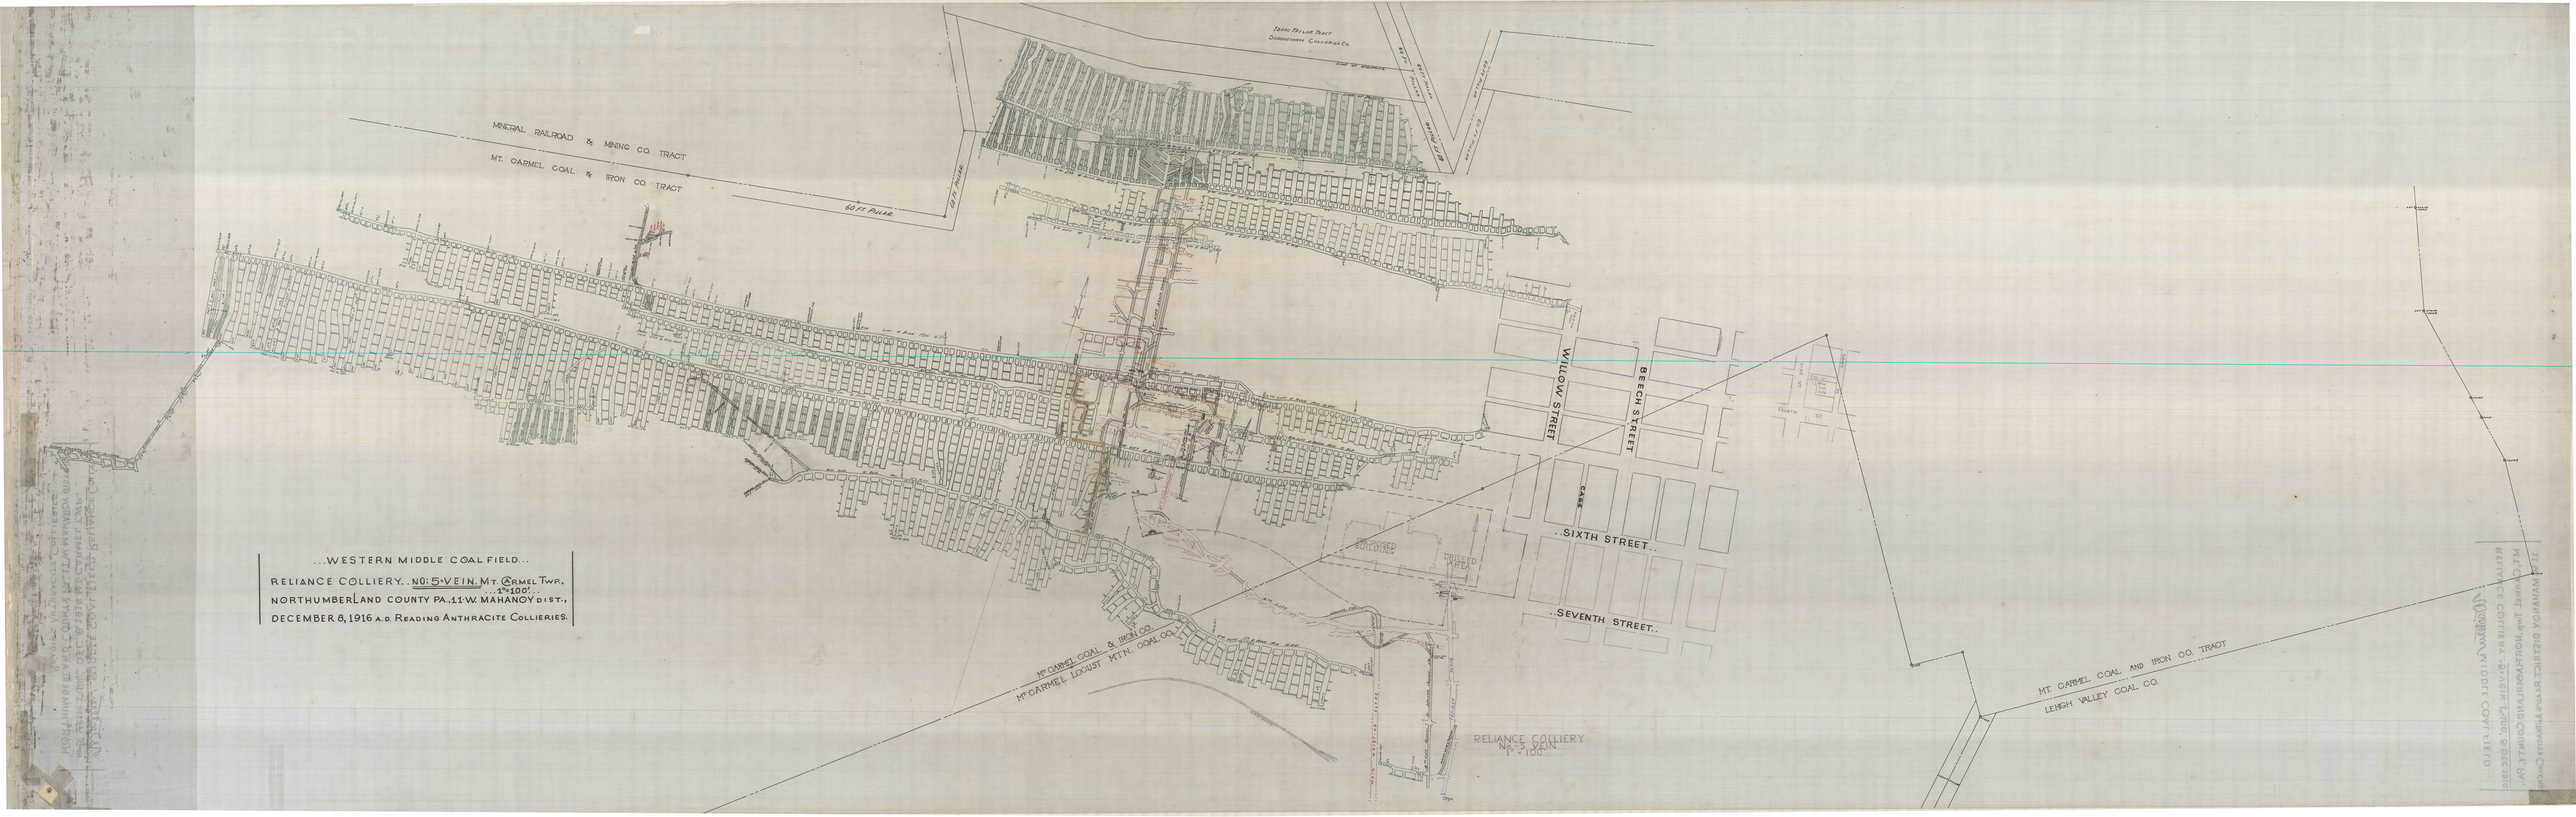

...WESTERN MIDDLE COAL FIELD...
RELIANCE COLLIERY. NO: 5 VEIN. MT. CARMEL TWP.
1"=100'.
NORTHUMBERLAND COUNTY PA. 11 W. MAHANOY DIST.,
DECEMBER 8, 1916 A.D. READING ANTHRACITE COLLIERIES.
MINERAL RAILROAD & MINING CO. TRACT
MT. CARMEL COAL & IRON CO. TRACT
60 FT. PILLAR
ISAAC TAYLOR TRACT
SUSQUEHANNA COLLIERIES CO.
WILLOW STREET
BEECH STREET
SIXTH STREET
SEVENTH STREET
PROPOSED BUILDINGS
DRILLED WELL
MT. CARMEL COAL & IRON CO.
MT. CARMEL LOCUST MTN. COAL CO.
RELIANCE COLLIERY
No. 5 VEIN
1"=100'
MT. CARMEL COAL AND IRON CO. TRACT
LEHIGH VALLEY COAL CO.