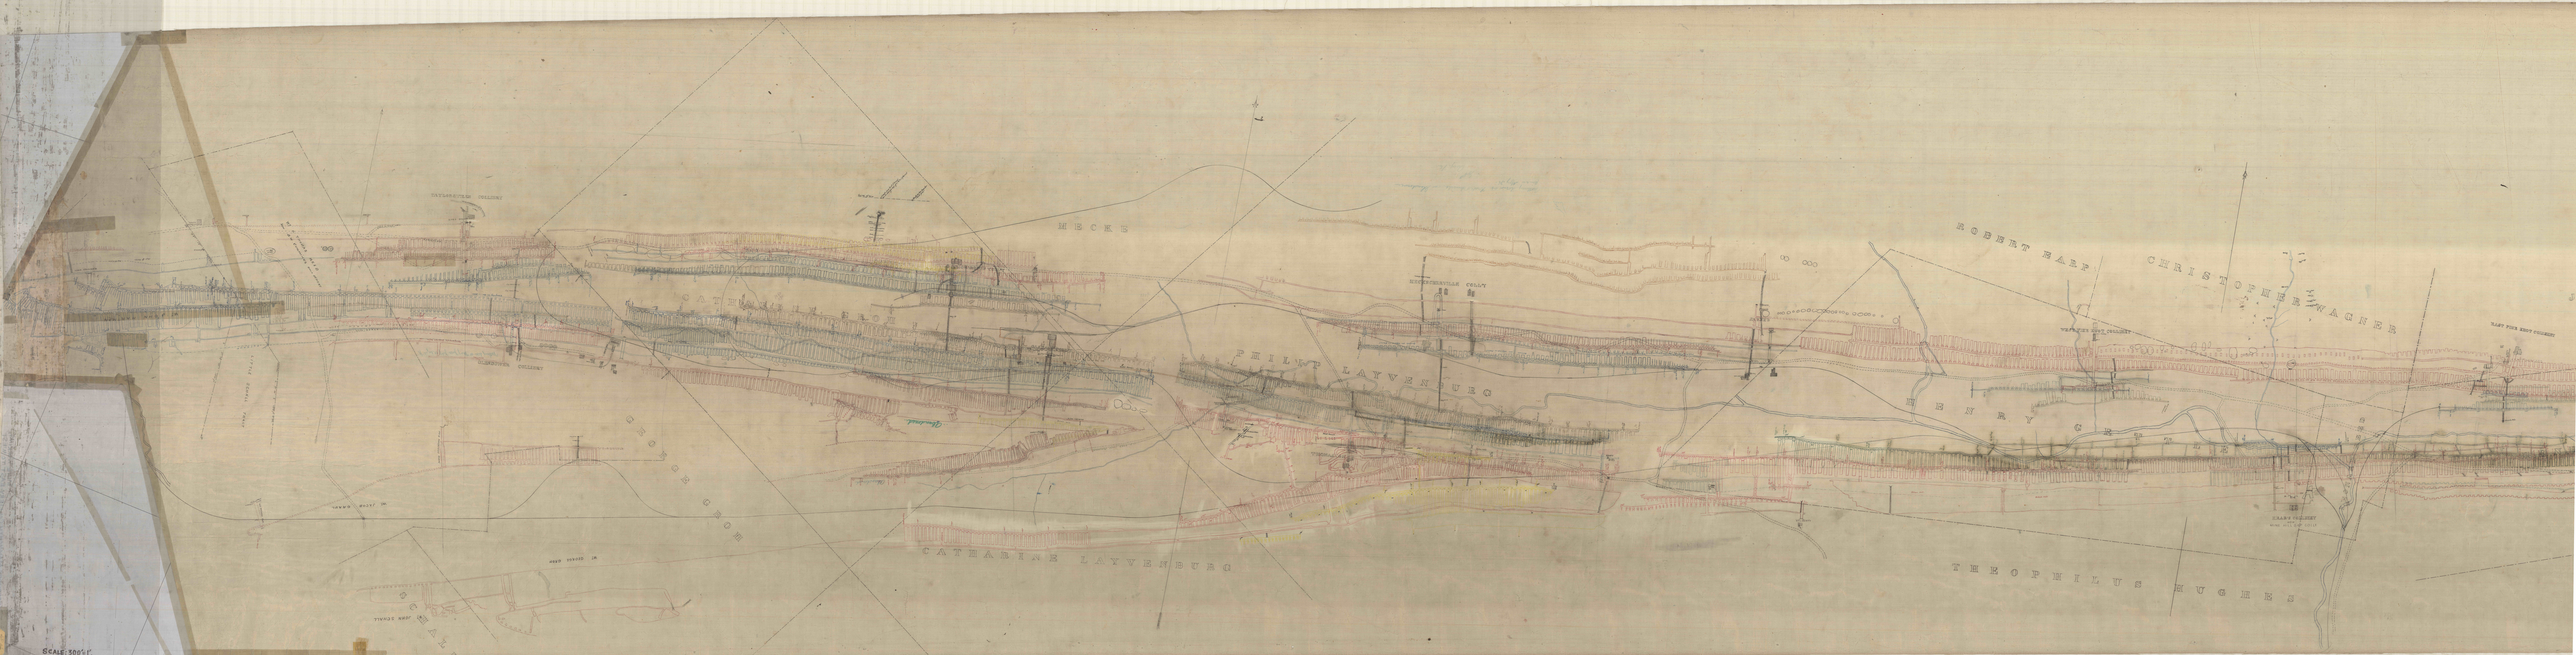

MECKE
PHILIP LAYENBURG
CATHARINE LAYENBURG
ROBERT HARP
CHRISTOPHER WAGNER
HENRY G
THEOPHILUS HUGHES
SCALE: 200'=1'