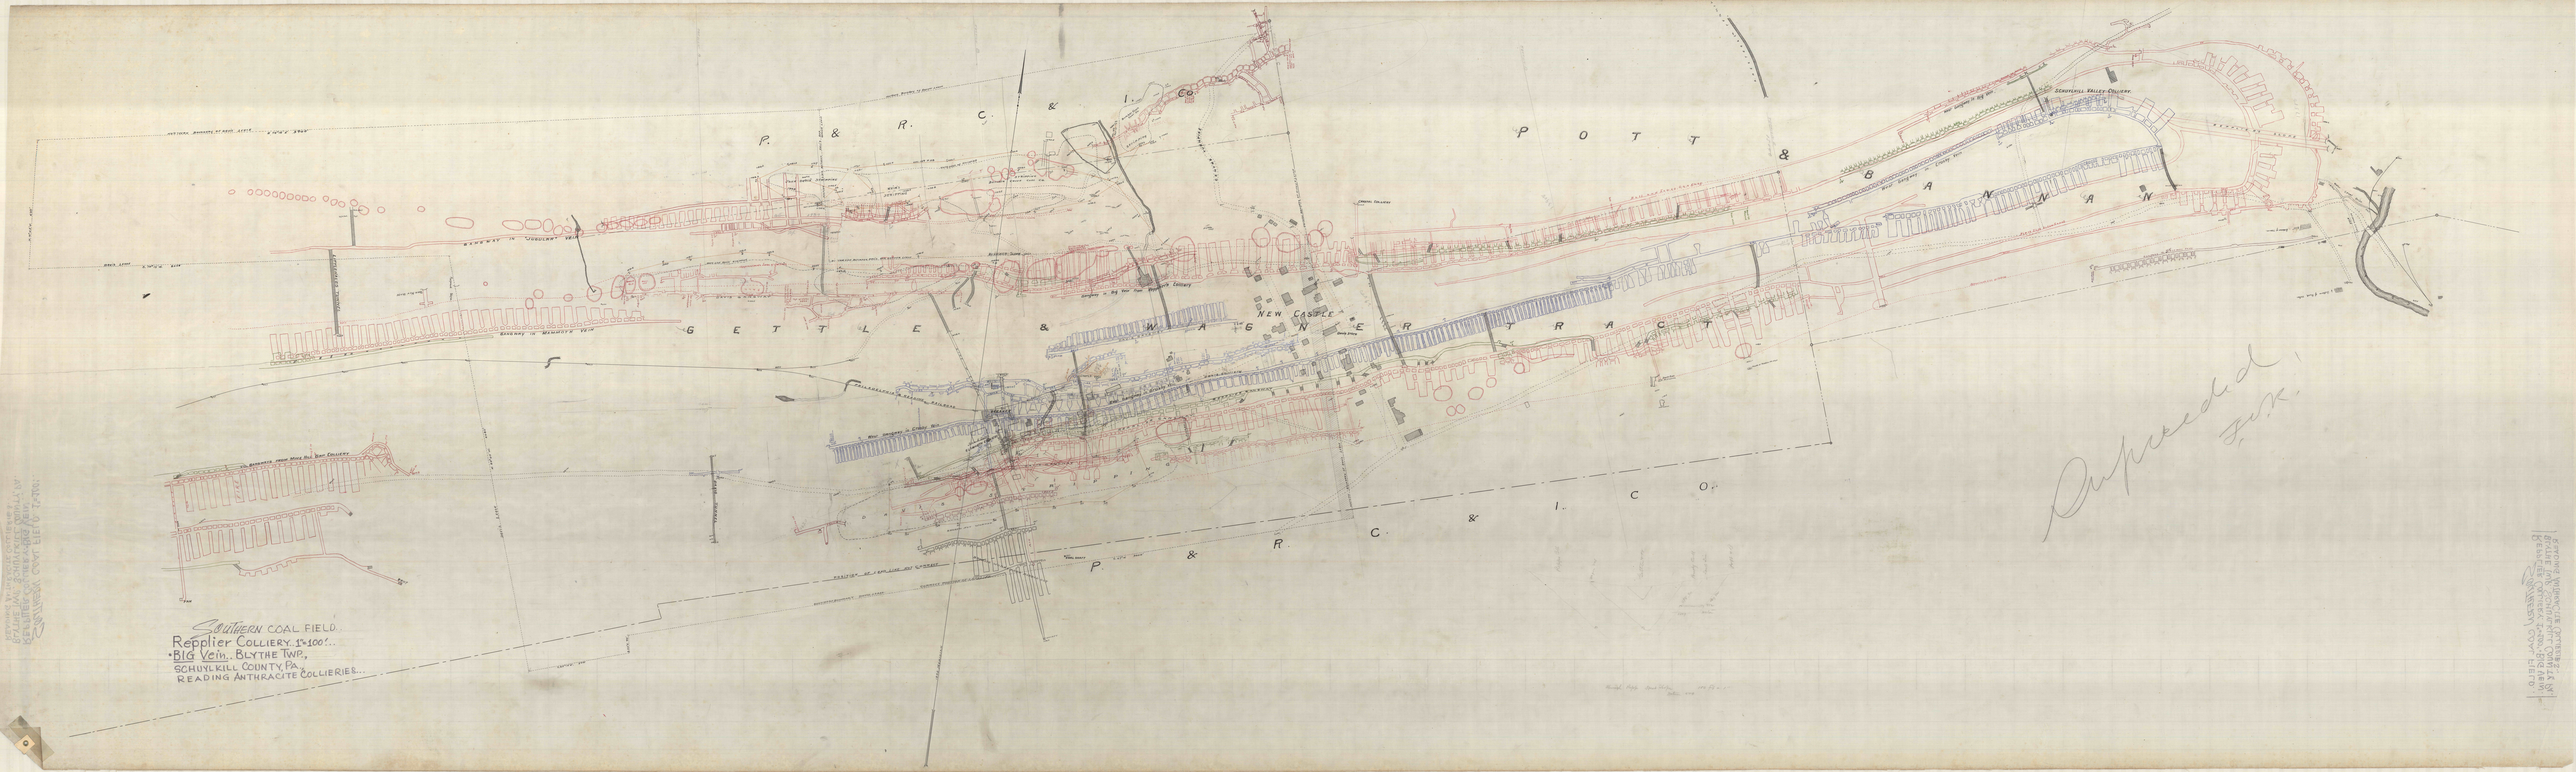


Southern Coal Field.
Reppler Colliery 1"=100'.
Big Vein, Blythe Twp,
Schuylkill County, Pa.
Reading Anthracite Collieries.