


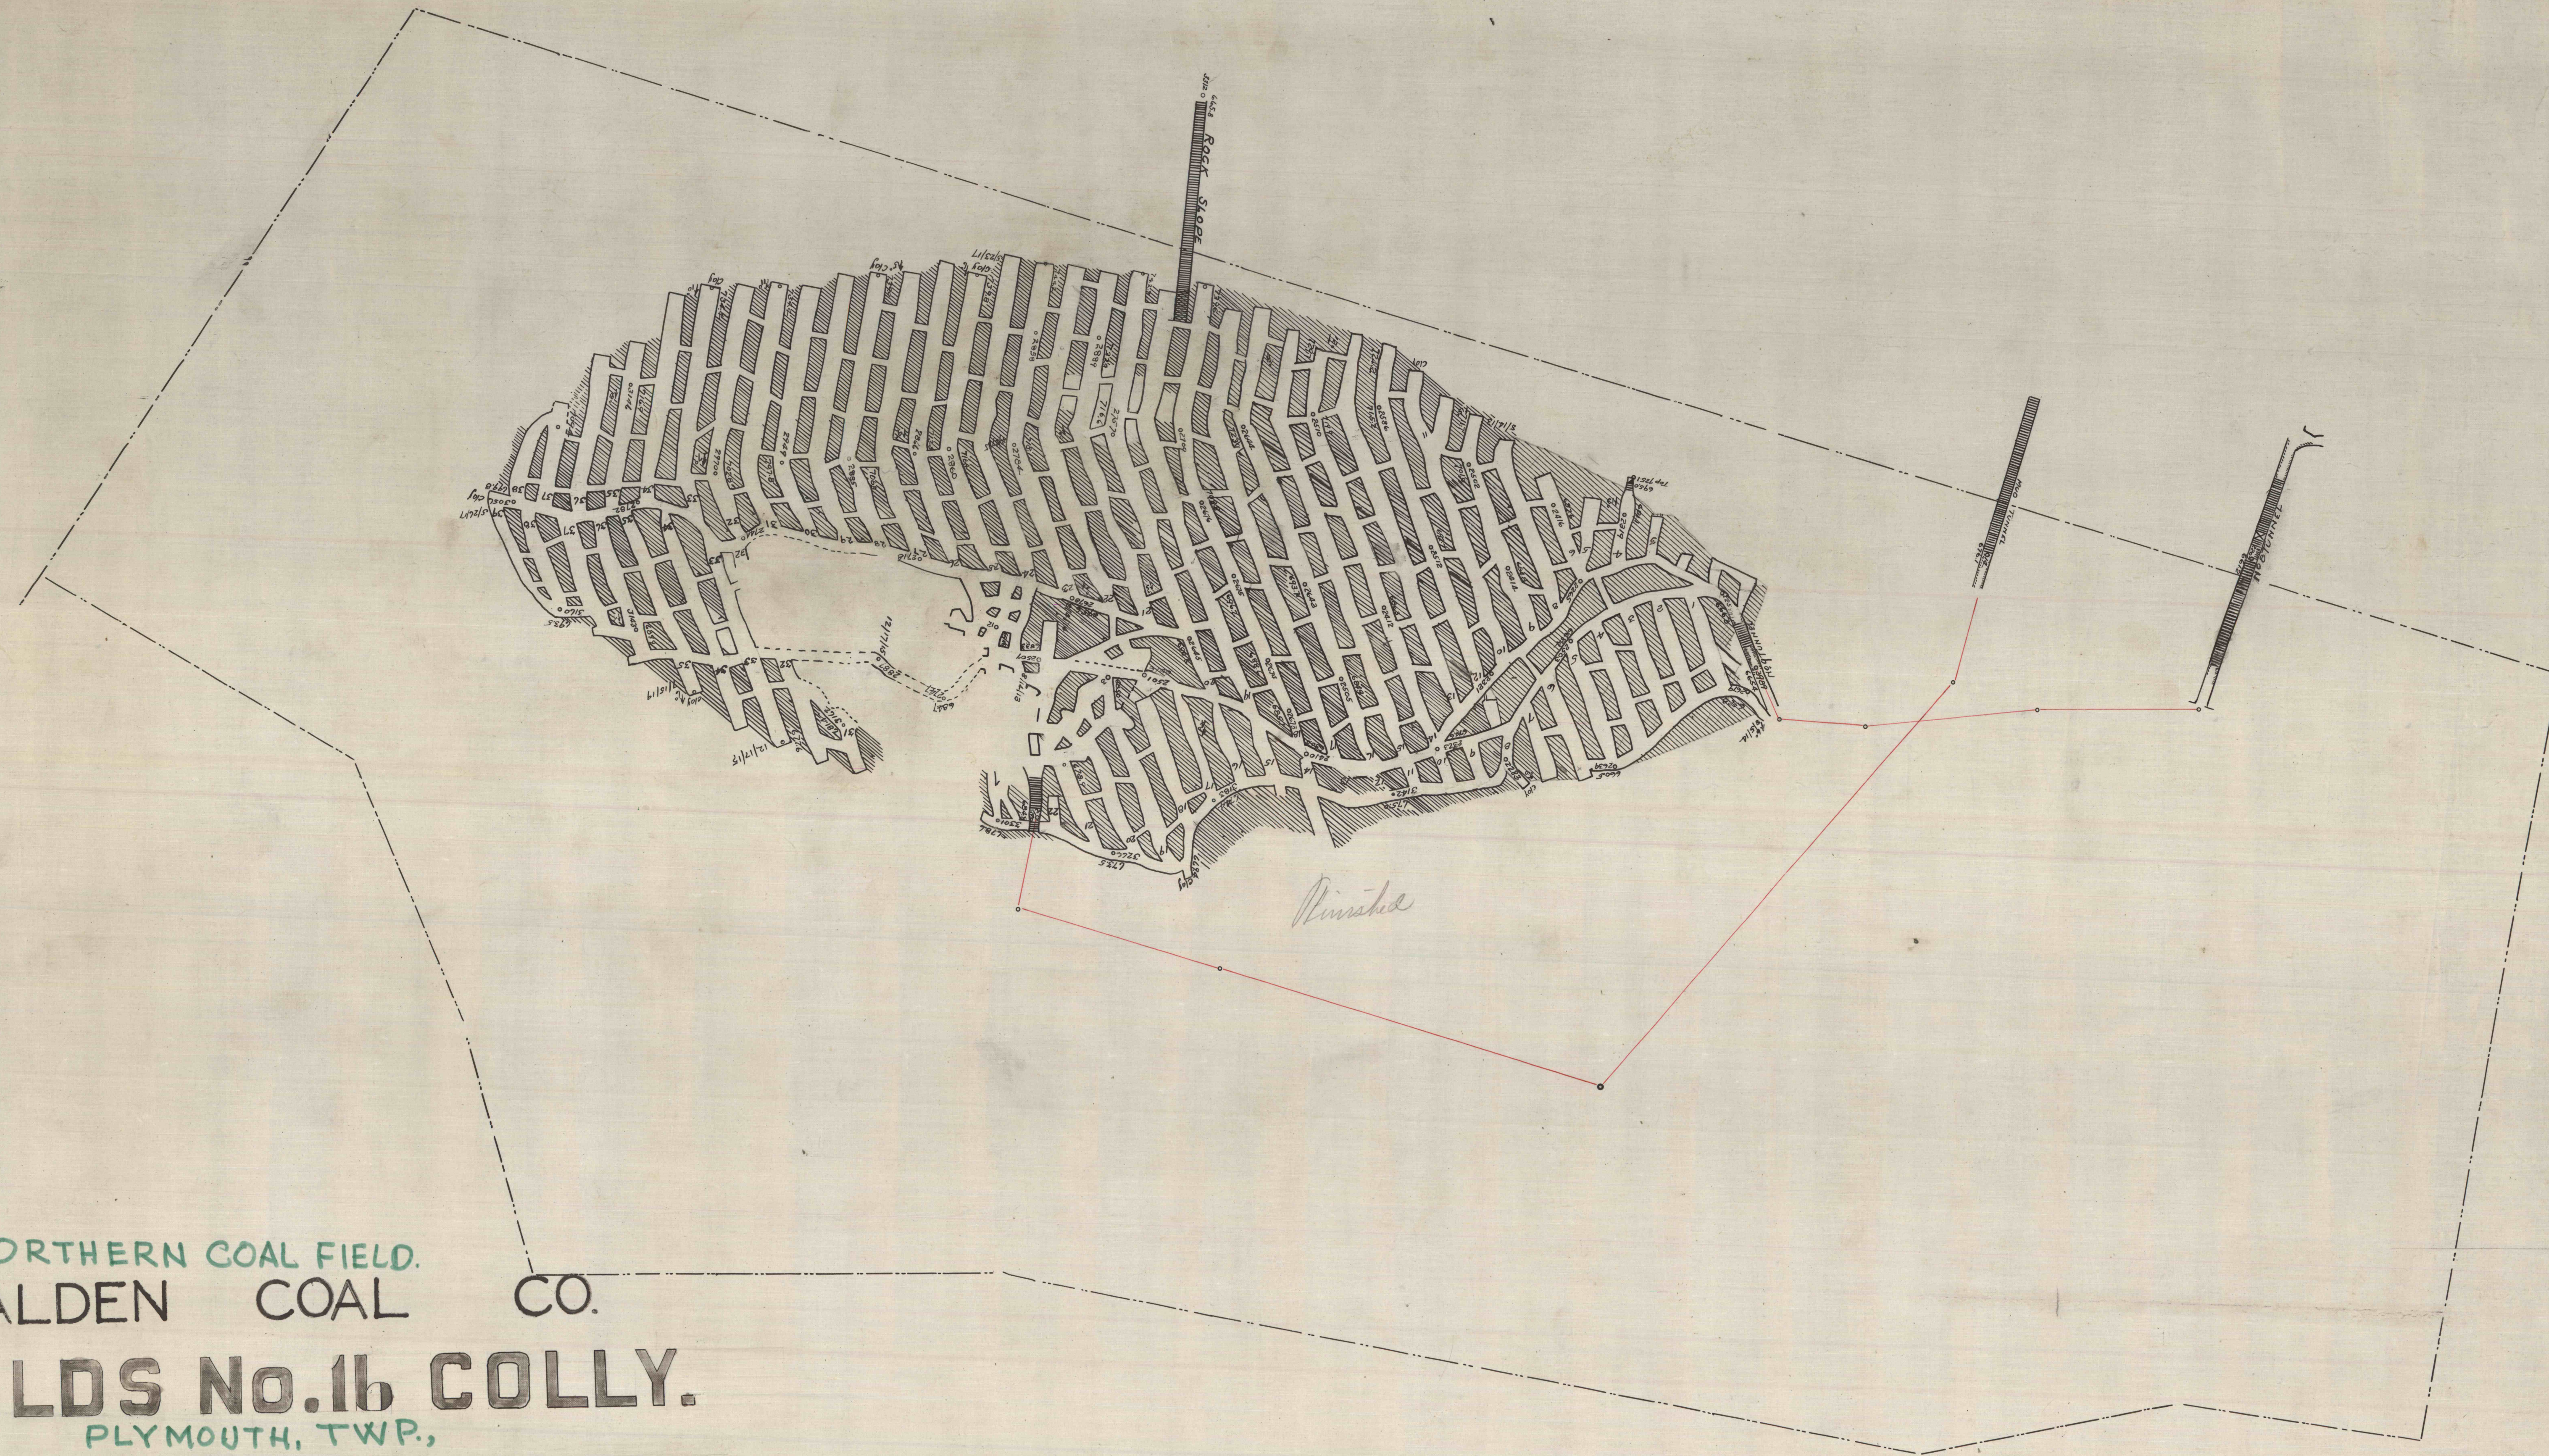

NORTHERN COAL FIELD.
GLEN ALDEN COAL CO.
REYNOLDS No. 16 COLLY.
PLYMOUTH, TWP.,
BALTIMORE VEIN... 1"=100'...
... LUZERNE COUNTY...

EXTENDED
OCT. 1914
July 1915
Mar. 1916
July 1921
Aug. 1921
Apr. 1922
MARCH 1924
January 1926
August 1931
August 1936
FEBRUARY 1938
MARCH 1939
January 1942
January 1943
July 1943
January 1947
Sept. 1947
Feb. 14, 1948
JULY 17, 1951
Nov. 14, 1952
DEC. 14, 1953
DEC. 14, 1954

TRACING...
#2 of 2..

WASHINGTON NO. 16 COLLIERY.
BALTIMORE VEIN.

MINING ENGINEERING DEPT.
LEHIGH & WILkes-BARRE COAL CO.
WILkes-BARRE, PA.
Scale 1"=100'
TAPE M.B.B-16