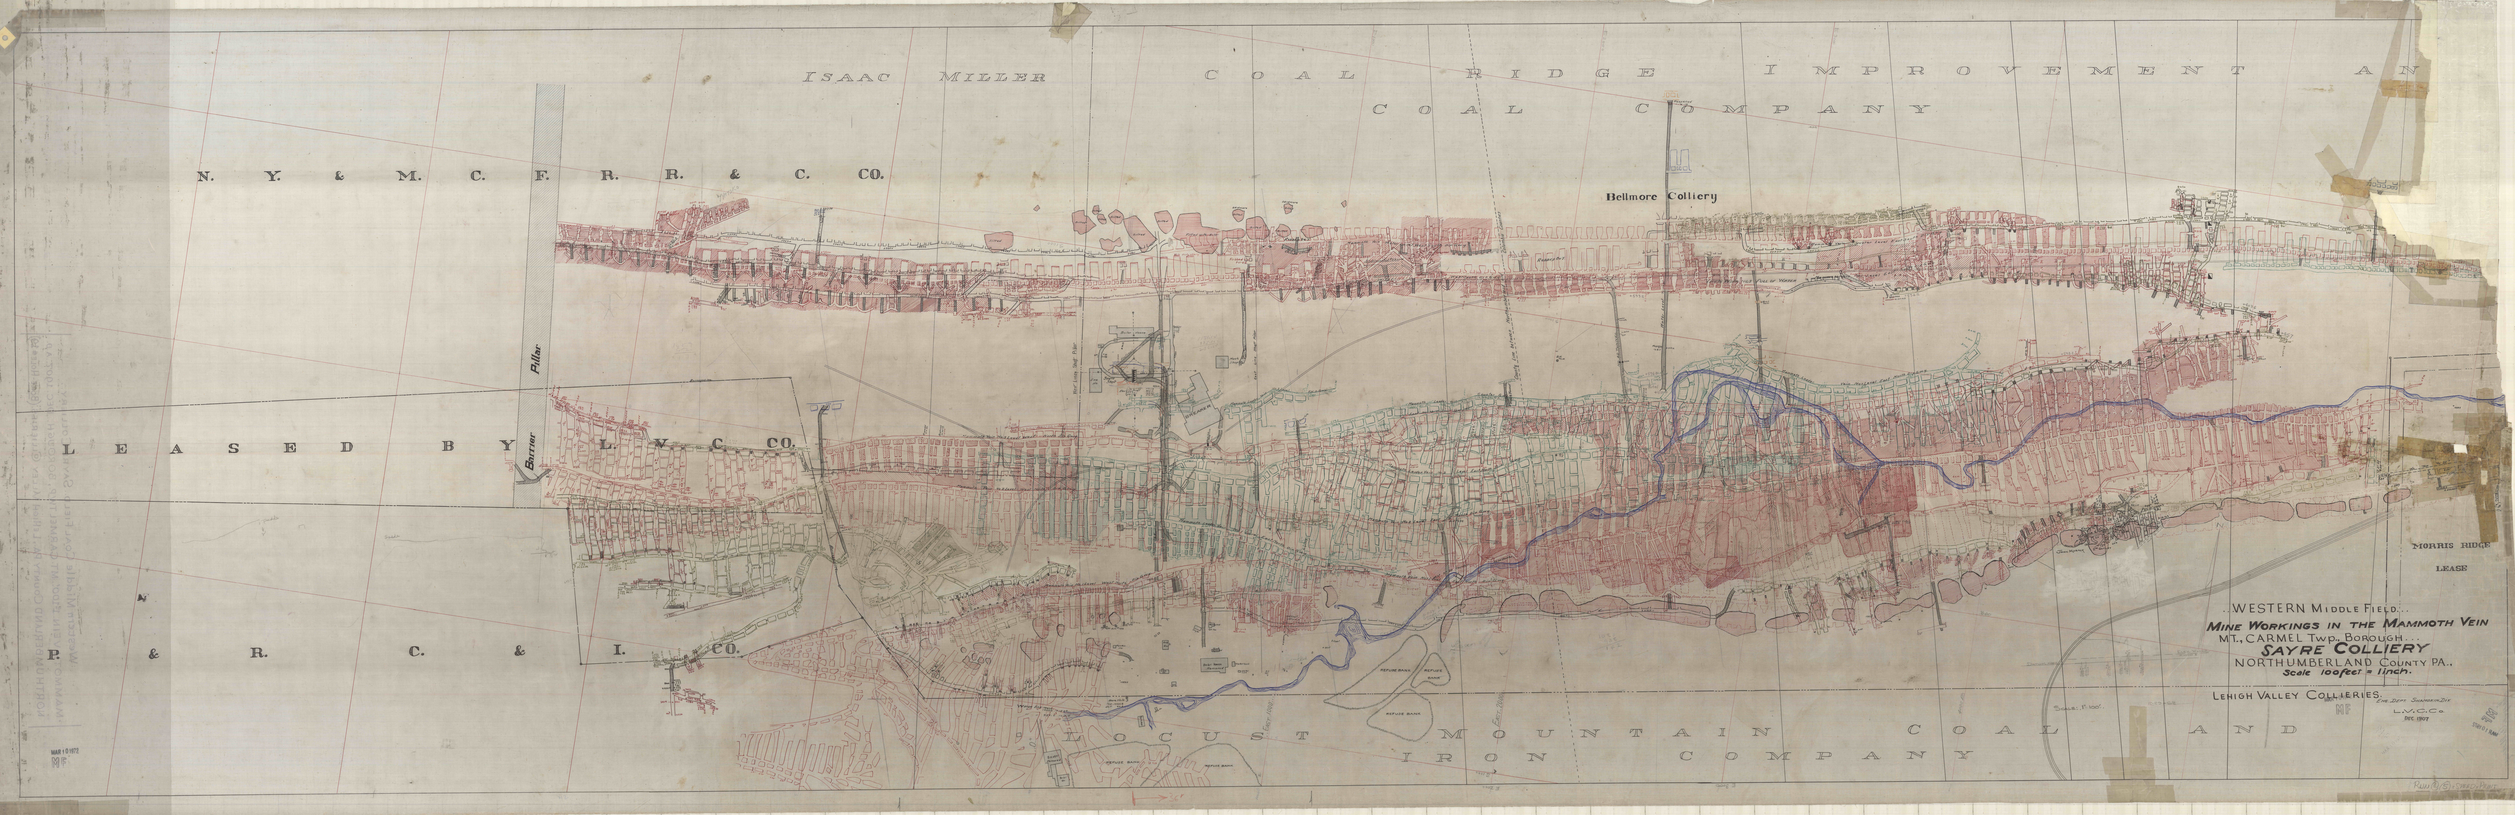
ISAAC MILLER COAL COMPANY
RIDGE IMPROVEMENT AN
N. Y. & M. C. F. R. R. & C. CO.
Bellmore Colliery
Pillar
Barrier
L E A S E D B Y L. V. C. CO.
P & R. C. & I. CO.
MORRIS RIDGE LEASE
WESTERN Middle Field.
MINE WORKINGS IN THE MAMMOTH VEIN
MT. CARMEL Twp. BOROUGH
SAYRE COLLIERY
NORTHUMBERLAND County PA.
Scale 100 feet = 1 inch.
LEHIGH VALLEY COLLIERIES
LOCUST MOUNTAIN COAL AND IRON COMPANY