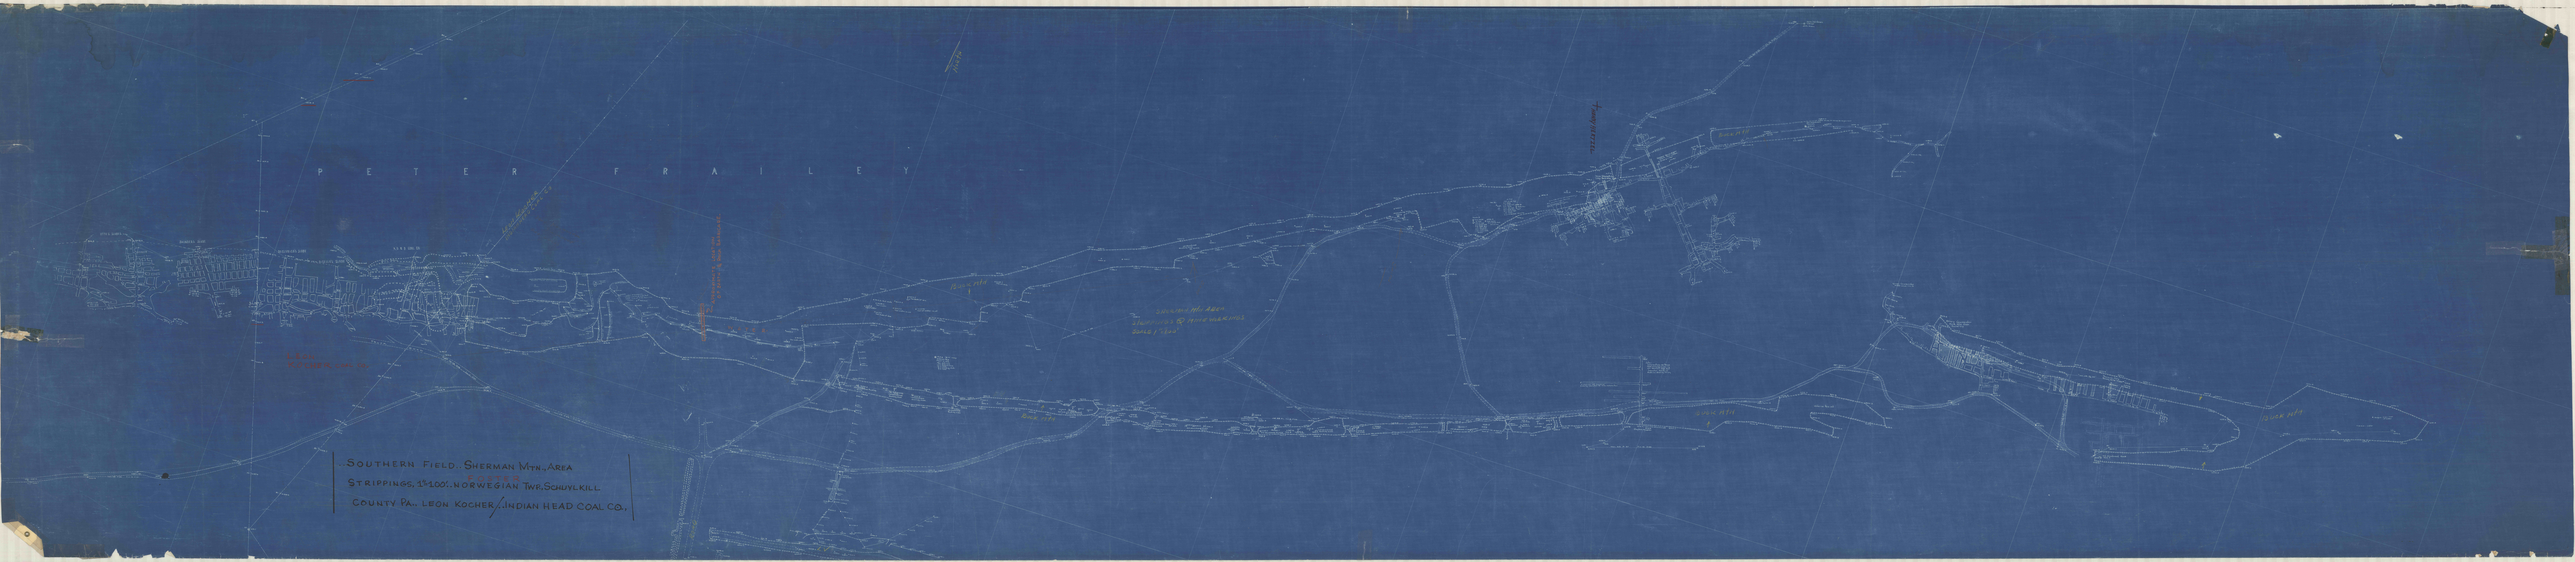
P E T E R F R A I L E Y
SOUTHERN FIELD - SHERMAN MTN. AREA
STRIPPINGS, 1" = 100'. NORWEGIAN TWP. SCHUYLKILL
COUNTY PA. - LEON KOCHER / INDIAN HEAD COAL CO.,